
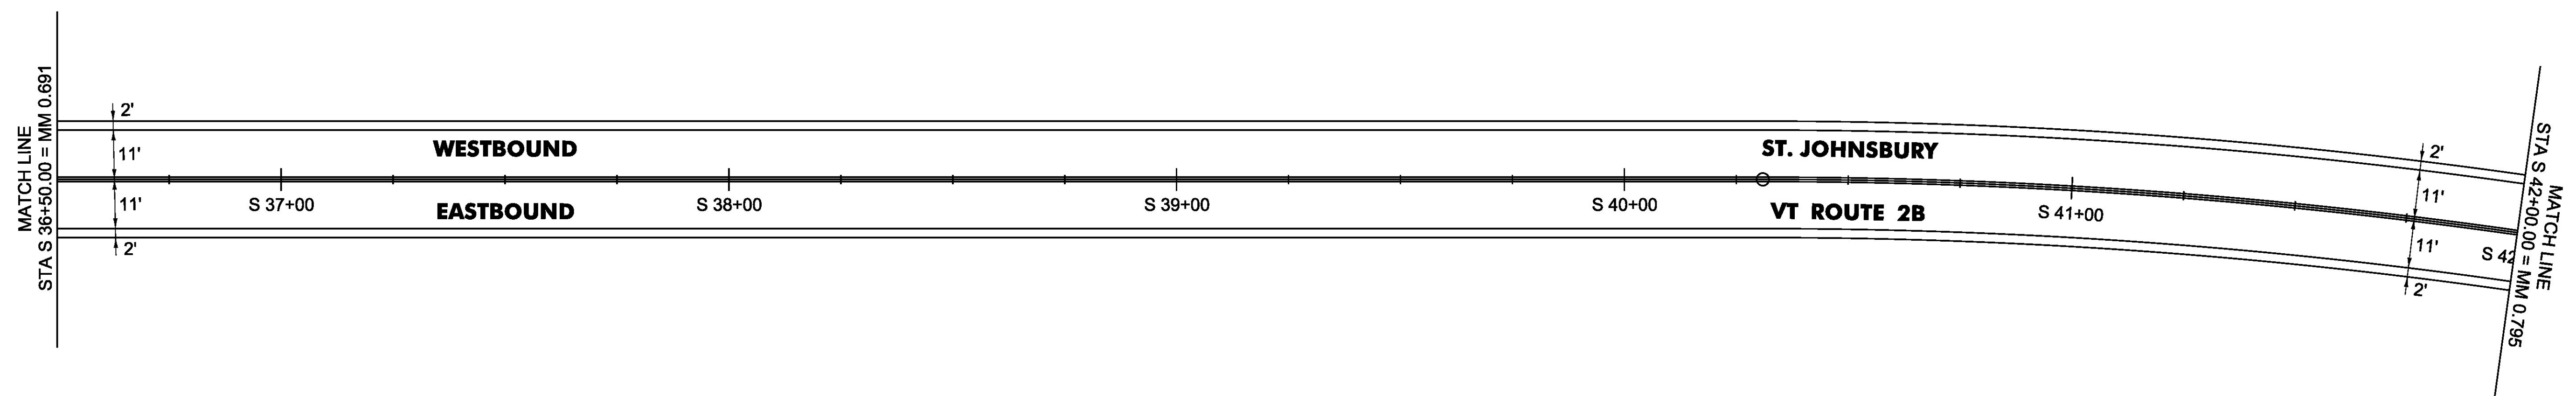


4 INCH YELLOW LINE, WATERBORNE PAINT  
S 31+00 TO S 42+00 SOLID RT & LT

4 INCH WHITE LINE, WATERBORNE PAINT  
S 31+00 TO S 42+00 SOLID RT & LT

TEMPORARY 4 INCH YELLOW LINE, PAINT  
S 31+00 TO S 42+00 SOLID RT & LT

TEMPORARY 4 INCH WHITE LINE, PAINT  
S 31+00 TO S 42+00 SOLID RT & LT

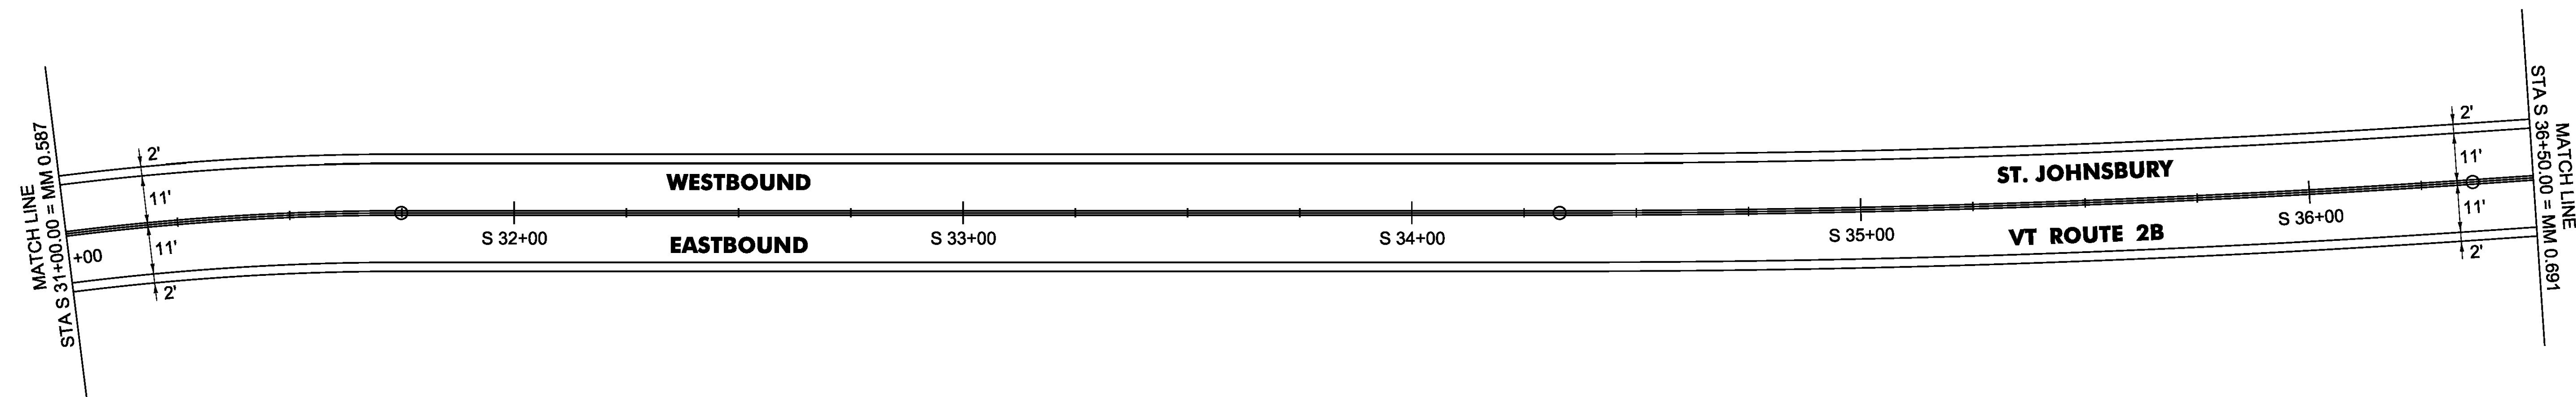

NOT TO SCALE

PROJECT NAME: DANVILLE-ST. JOHNSBURY

PROJECT NUMBER: STP FPAV(9)

FILE NAME: 16v148.dgn

PLOT DATE: 05-JUN-2017

PROJECT LEADER: B. KIPP

DRAWN BY: B. KIPP

DESIGNED BY: B. KIPP

CHECKED BY: M. FOWLER

PLAN SHEET 13

SHEET 28 OF 33