


4 INCH YELLOW LINE, WATERBORNE PAINT
S 64+00 TO S 75+00 SOLID RT & LT

4 INCH WHITE LINE, WATERBORNE PAINT
S 64+00 TO S 75+00 SOLID RT & LT

CHANGING ELEVATION OF SEWER MANHOLE
S 67+70 LT

TEMPORARY 4 INCH YELLOW LINE, PAINT
S 64+00 TO S 75+00 SOLID RT & LT

TEMPORARY 4 INCH WHITE LINE, PAINT
S 64+00 TO S 75+00 SOLID RT & LT

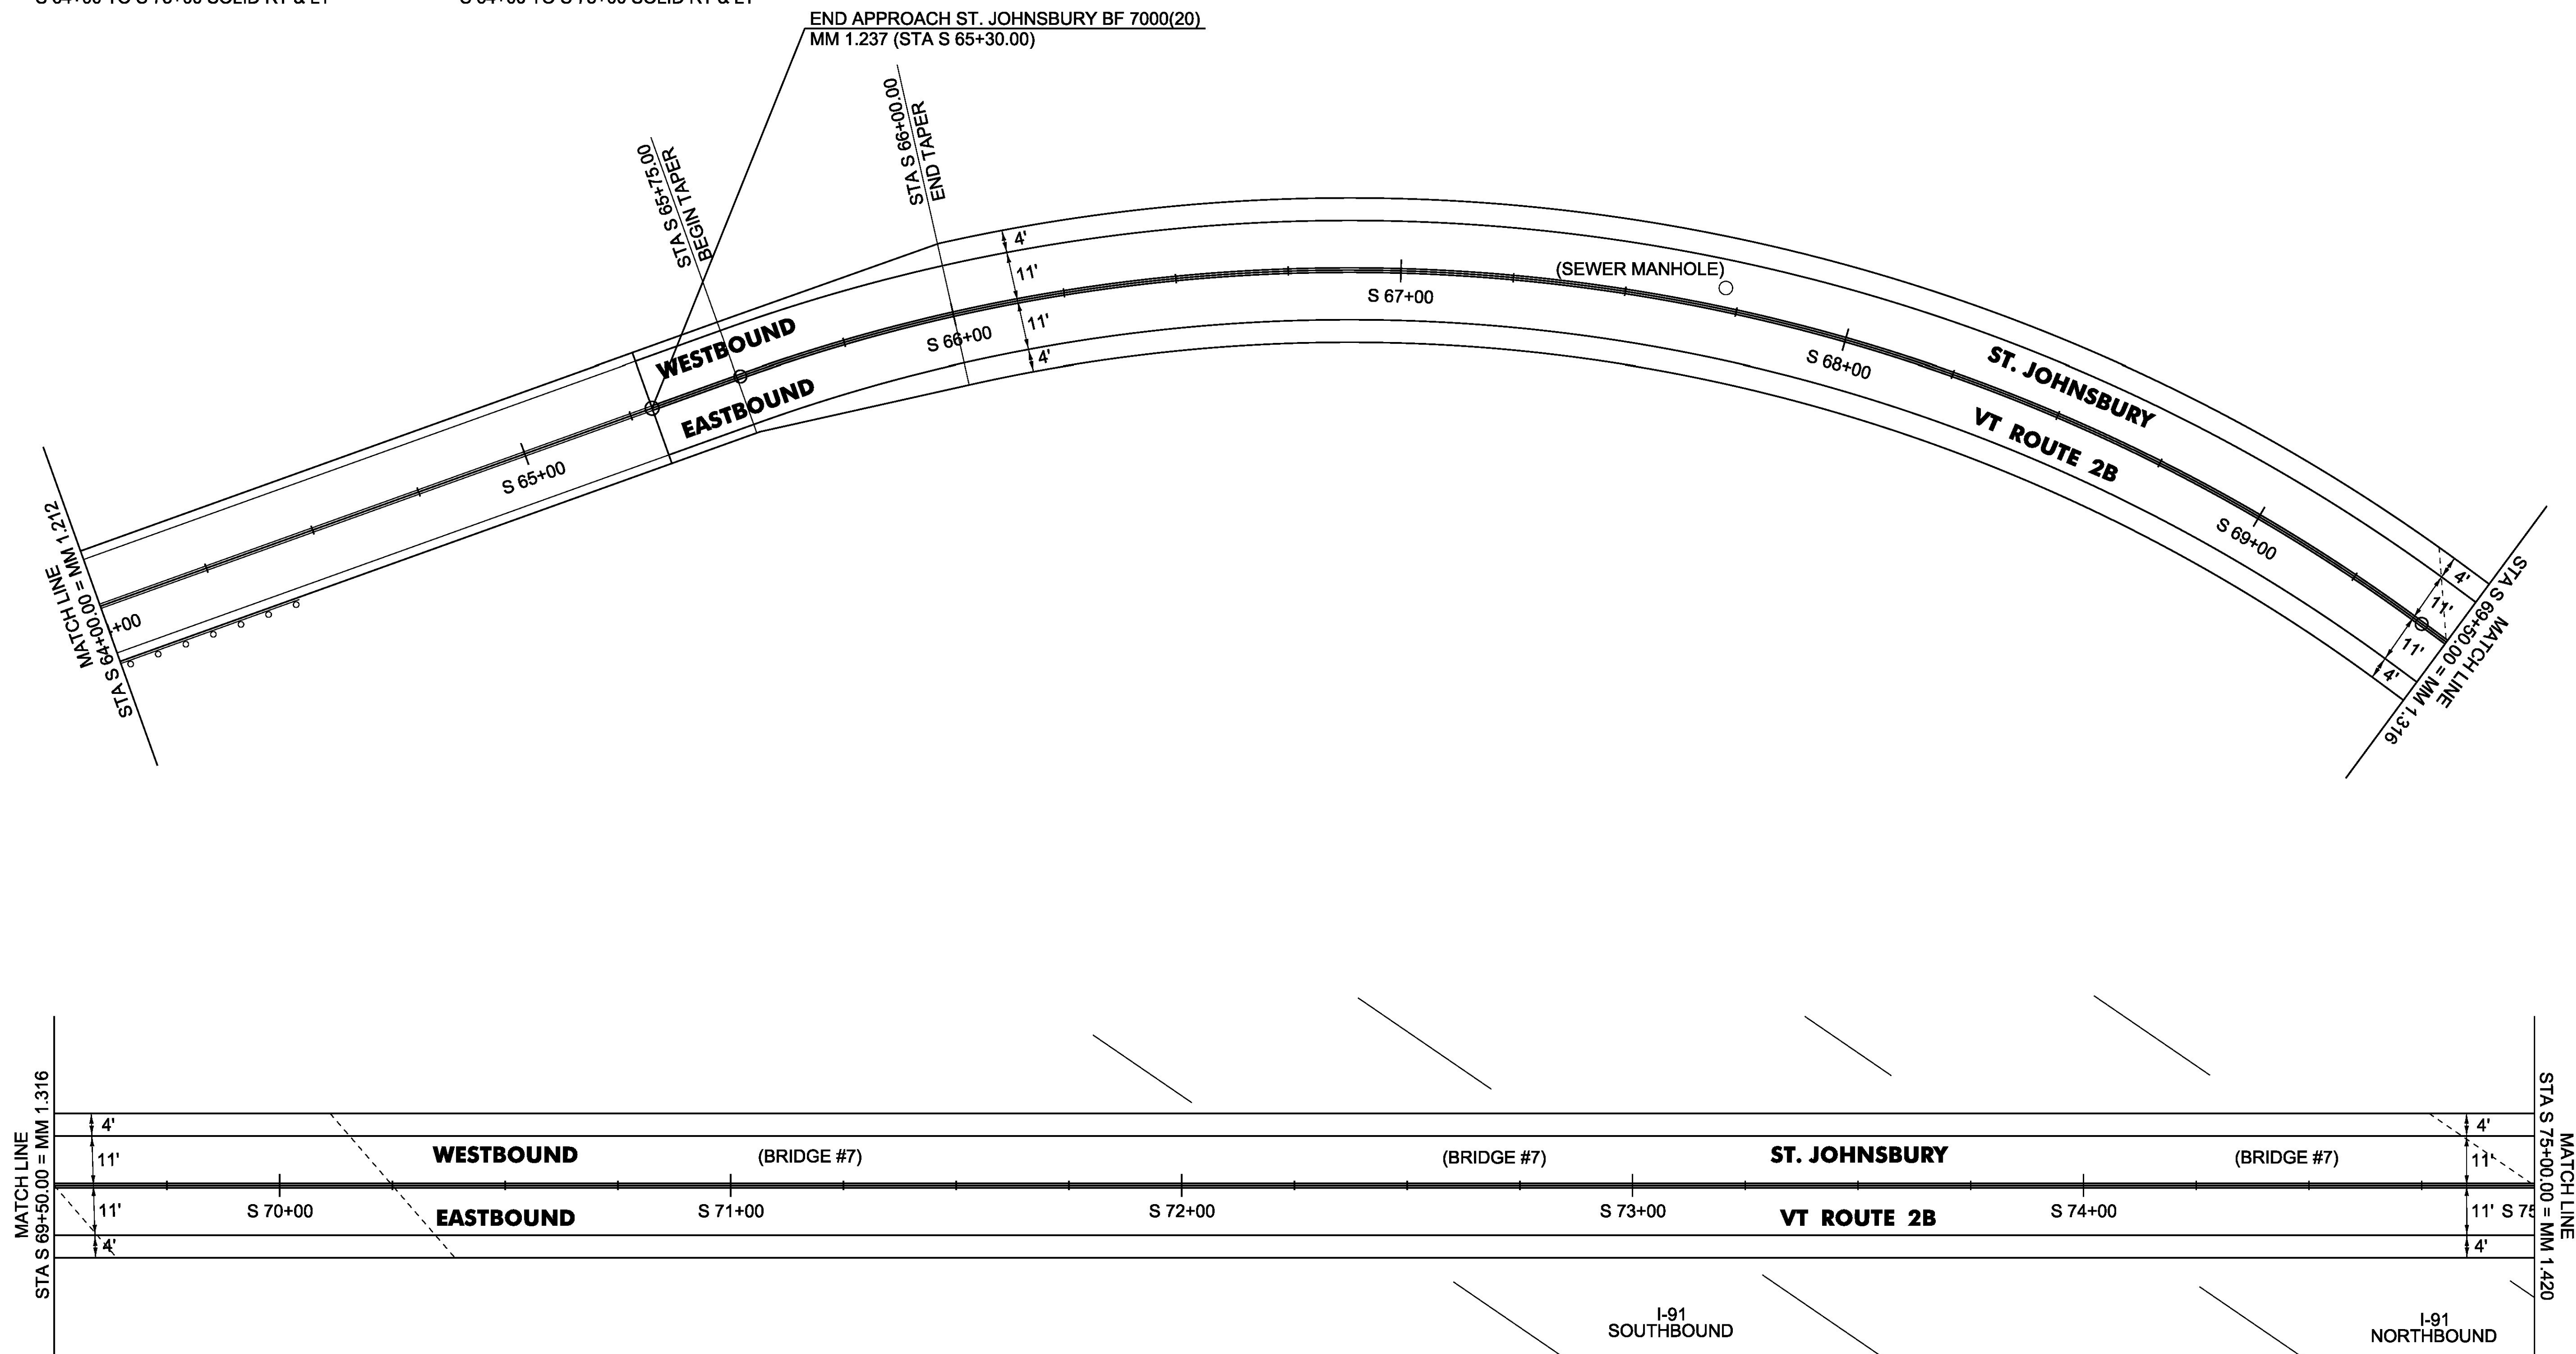

NOT TO SCALE

PROJECT NAME:	DANVILLE-ST. JOHNSBURY
PROJECT NUMBER:	STP FPAV(9)
FILE NAME:	16v148.dgn
PROJECT LEADER:	B. KIPP
DESIGNED BY:	B. KIPP
PLAN SHEET 16	
PLOT DATE:	05-JUN-2017
DRAWN BY:	B. KIPP
CHECKED BY:	M. FOWLER
SHEET 31	OF 33