

**4 INCH YELLOW LINE, WATERBORNE PAINT**  
 S 75+00 TO S 79+00 SOLID RT & LT  
 S 79+00 TO S 80+45 DOUBLE SOLID RT & LT  
 S 80+45 TO S 81+10 SOLID RT & LT

**TEMPORARY 4 INCH YELLOW LINE, PAINT**  
 S 75+00 TO S 79+00 SOLID RT & LT  
 S 79+00 TO S 80+45 DOUBLE SOLID RT & LT  
 S 80+45 TO S 81+10 SOLID RT & LT

**4 INCH WHITE LINE, WATERBORNE PAINT**  
 S 75+00 TO S 81+13 SOLID RT & LT  
 S 80+75 TO S 81+13 SOLID RT

**TEMPORARY 4 INCH WHITE LINE, PAINT**  
 S 75+00 TO S 81+13 SOLID RT & LT  
 S 80+75 TO S 81+13 SOLID RT

**24 INCH STOP BAR, WATERBORNE PAINT**  
 S 81+09 RT

**TEMPORARY 24 INCH STOP BAR, PAINT**  
 S 81+09 RT

**DURABLE LETTER OR SYMBOL, WATERBORNE PAINT**

S 80+85 RT ARROW	1 EACH
S 80+85 RT ARROW	1 EACH
S 81+00 RT "S,T,O,P"	4 EACH
S 81+00 RT "S,T,O,P"	4 EACH

**TEMPORARY LETTER OR SYMBOL, PAINT**


S 80+85 RT ARROW	1 EACH
S 80+85 RT ARROW	1 EACH
S 81+00 RT "S,T,O,P"	4 EACH
S 81+00 RT "S,T,O,P"	4 EACH

**PAINTED CURB**  
 S 80+45 TO S 81+10 RT & LT

**REMOVE AND RESET GUARDRAIL**  
 S 75+46 TO S 80+50 LT

**REMOVAL OF EXISTING CURB**  
 S 75+46 TO S 80+50 LT

**BITUMINOUS CONCRETE CURB, TYPE A**  
 S 75+46 TO S 80+50 LT

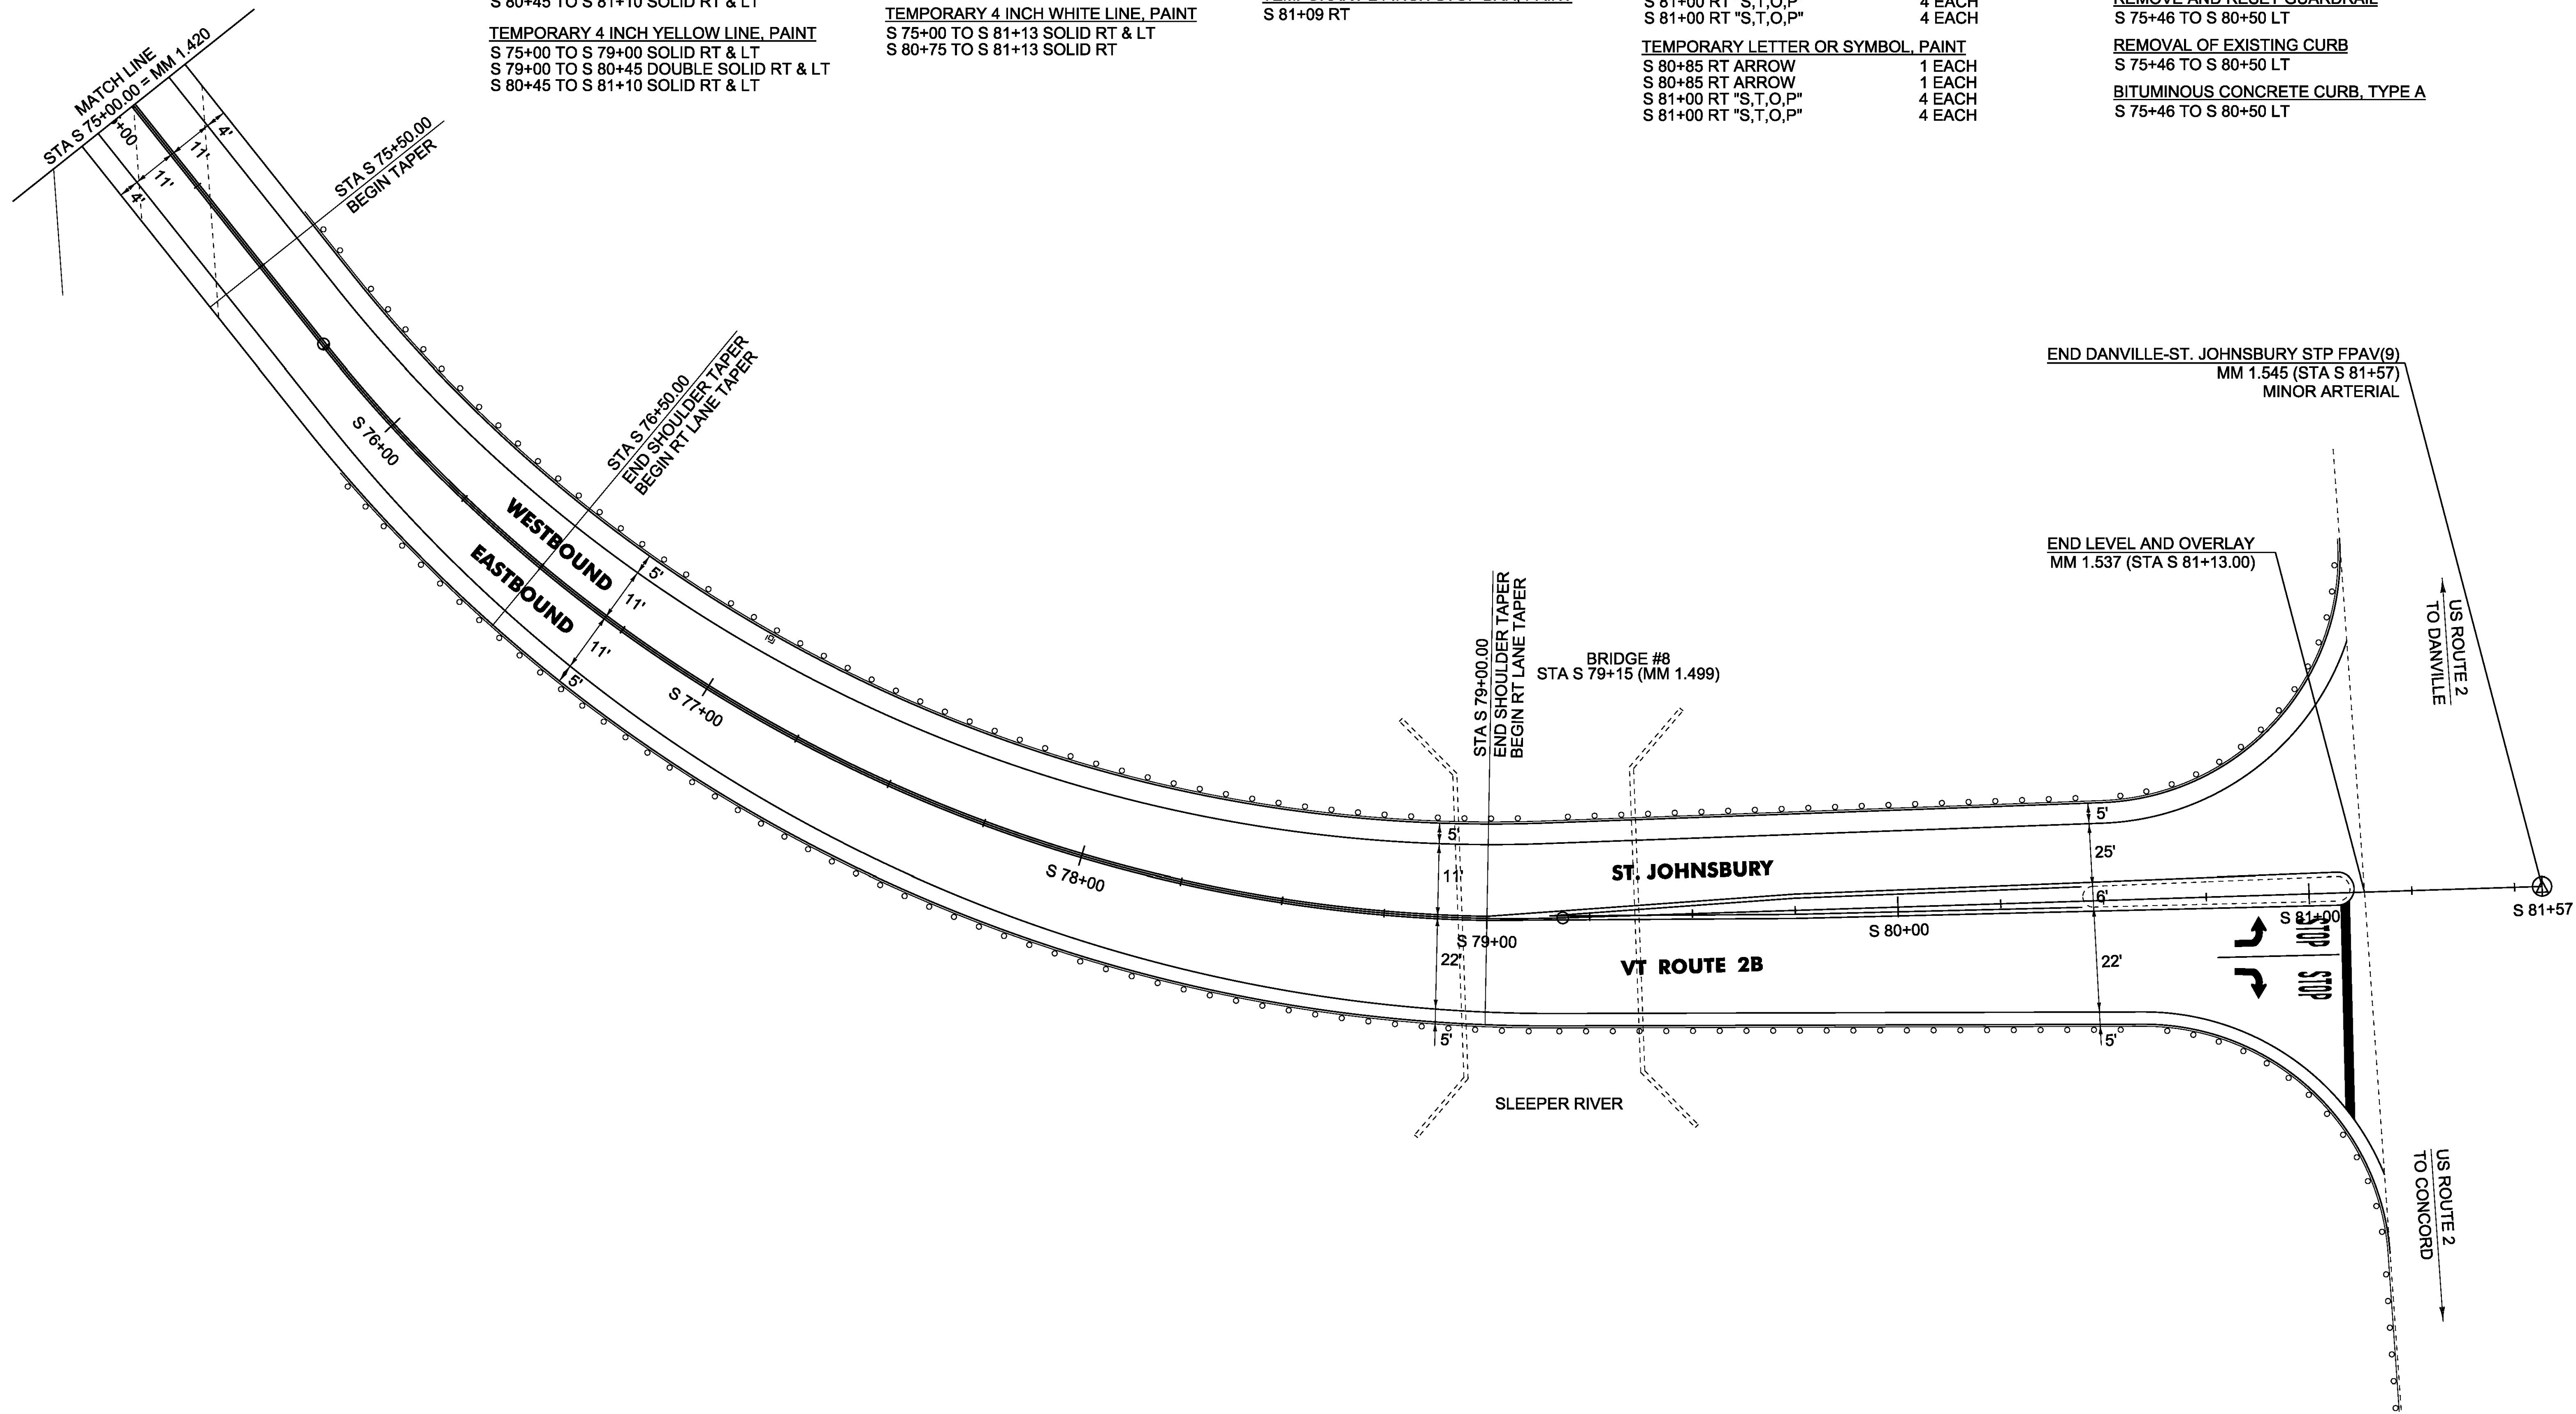

**NOT TO SCALE**

PROJECT NAME:	DANVILLE-ST. JOHNSBURY
PROJECT NUMBER:	STP FPAV(9)
FILE NAME:	16v148.dgn
PROJECT LEADER:	B. KIPP
DESIGNED BY:	B. KIPP
PLAN SHEET 17	
PLOT DATE:	05-JUN-2017
DRAWN BY:	B. KIPP
CHECKED BY:	M. FOWLER
SHEET 32	OF 33