

INDEX OF SHEETS

- 1 TITLE SHEET
- 2 CRACK SEALING TYPICAL
- 3 QUANTITY SHEET
- 4 LOCATION LAYOUT
- 5-6 CRACK SEALING LOCATION DETAIL SHEETS
- 7-31 INTERCHANGE DETAIL SHEETS
- 32 TRAFFIC CONTROL NOTES

VAOT STANDARDS


- T-1 04/25/16
- T-10 08/06/12
- T-11 08/06/12
- T-12 08/06/12
- T-16 08/06/12
- T-17 08/06/12
- T-20 08/06/12
- T-28 08/06/12
- T-29 08/06/12
- T-30 08/06/12
- T-31 08/06/12

STATE OF VERMONT AGENCY OF TRANSPORTATION




PROPOSED IMPROVEMENT STATEWIDE CRACK SEALING


WORK TO BE PERFORMED UNDER THIS PROJECT INCLUDES THE ROUTING AND SEALING OF CRACKS IN BITUMINOUS CONCRETE PAVEMENT ON EXISTING STATE, U.S., AND INTERSTATE HIGHWAYS AND THE APPROPRIATE TRAFFIC CONTROL.

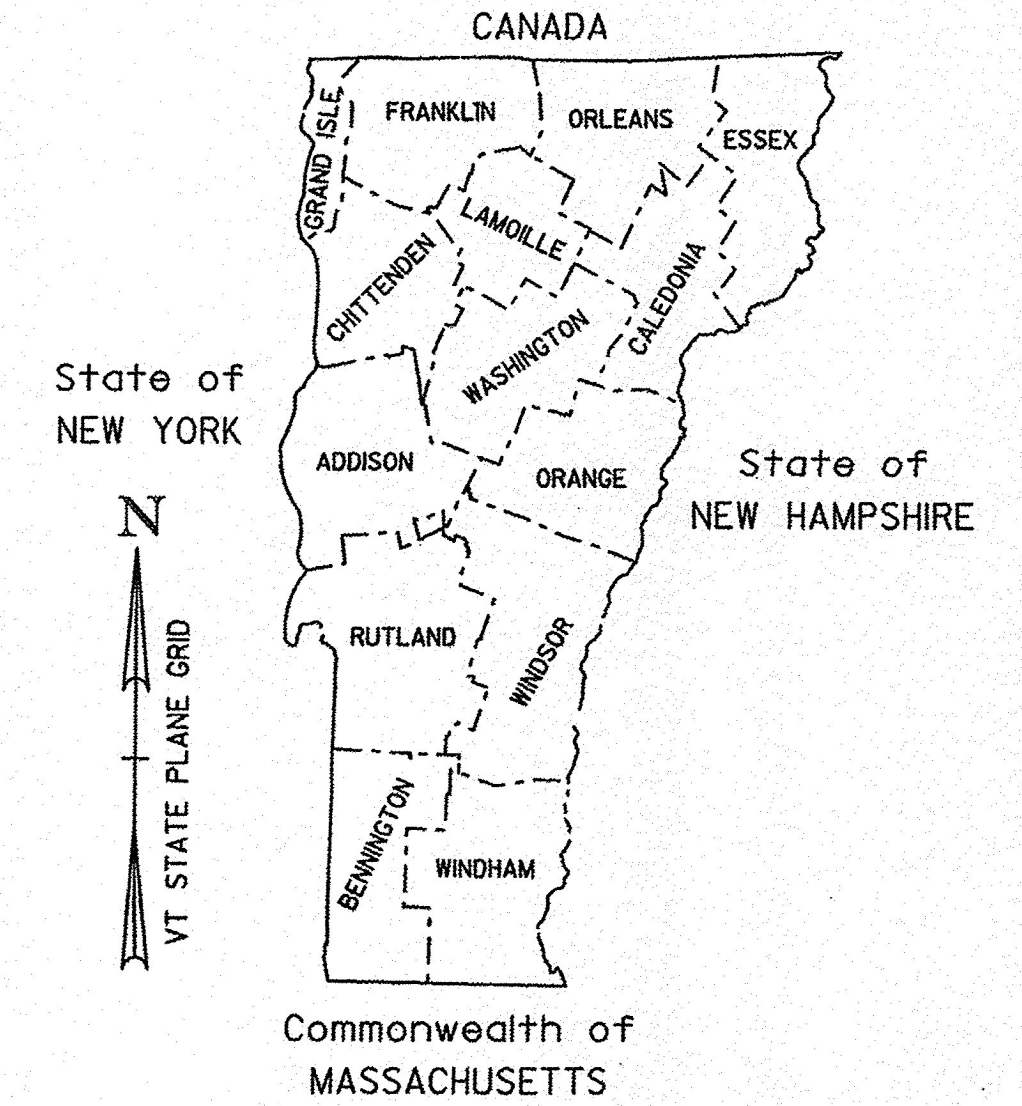

RECORD PLANS	
CONTRACTOR:	ANNSEAL, INC. - JOHNSON CITY, NY
RESIDENT ENGINEER:	CHRIS LAVALETTE
CONSTRUCTION BEGAN:	AUGUST 28, 2017
CONSTRUCTION COMPLETE:	MAY 10, 2018
RECORD PLANS BY:	CHRIS LAVALETTE & JESSE IVES
I HEREBY CERTIFY THAT ALL THE CONSTRUCTION REQUIRED BY THIS SET OF DRAWINGS HAS BEEN ACCOMPLISHED AS INDICATED HEREIN.	
BY	RESIDENT ENGINEER
DATE 9/10/18	
NOTE: Any further information concerning final quantities, amounts or other details relative to this project may be found at Central Files in the electronic archives.	

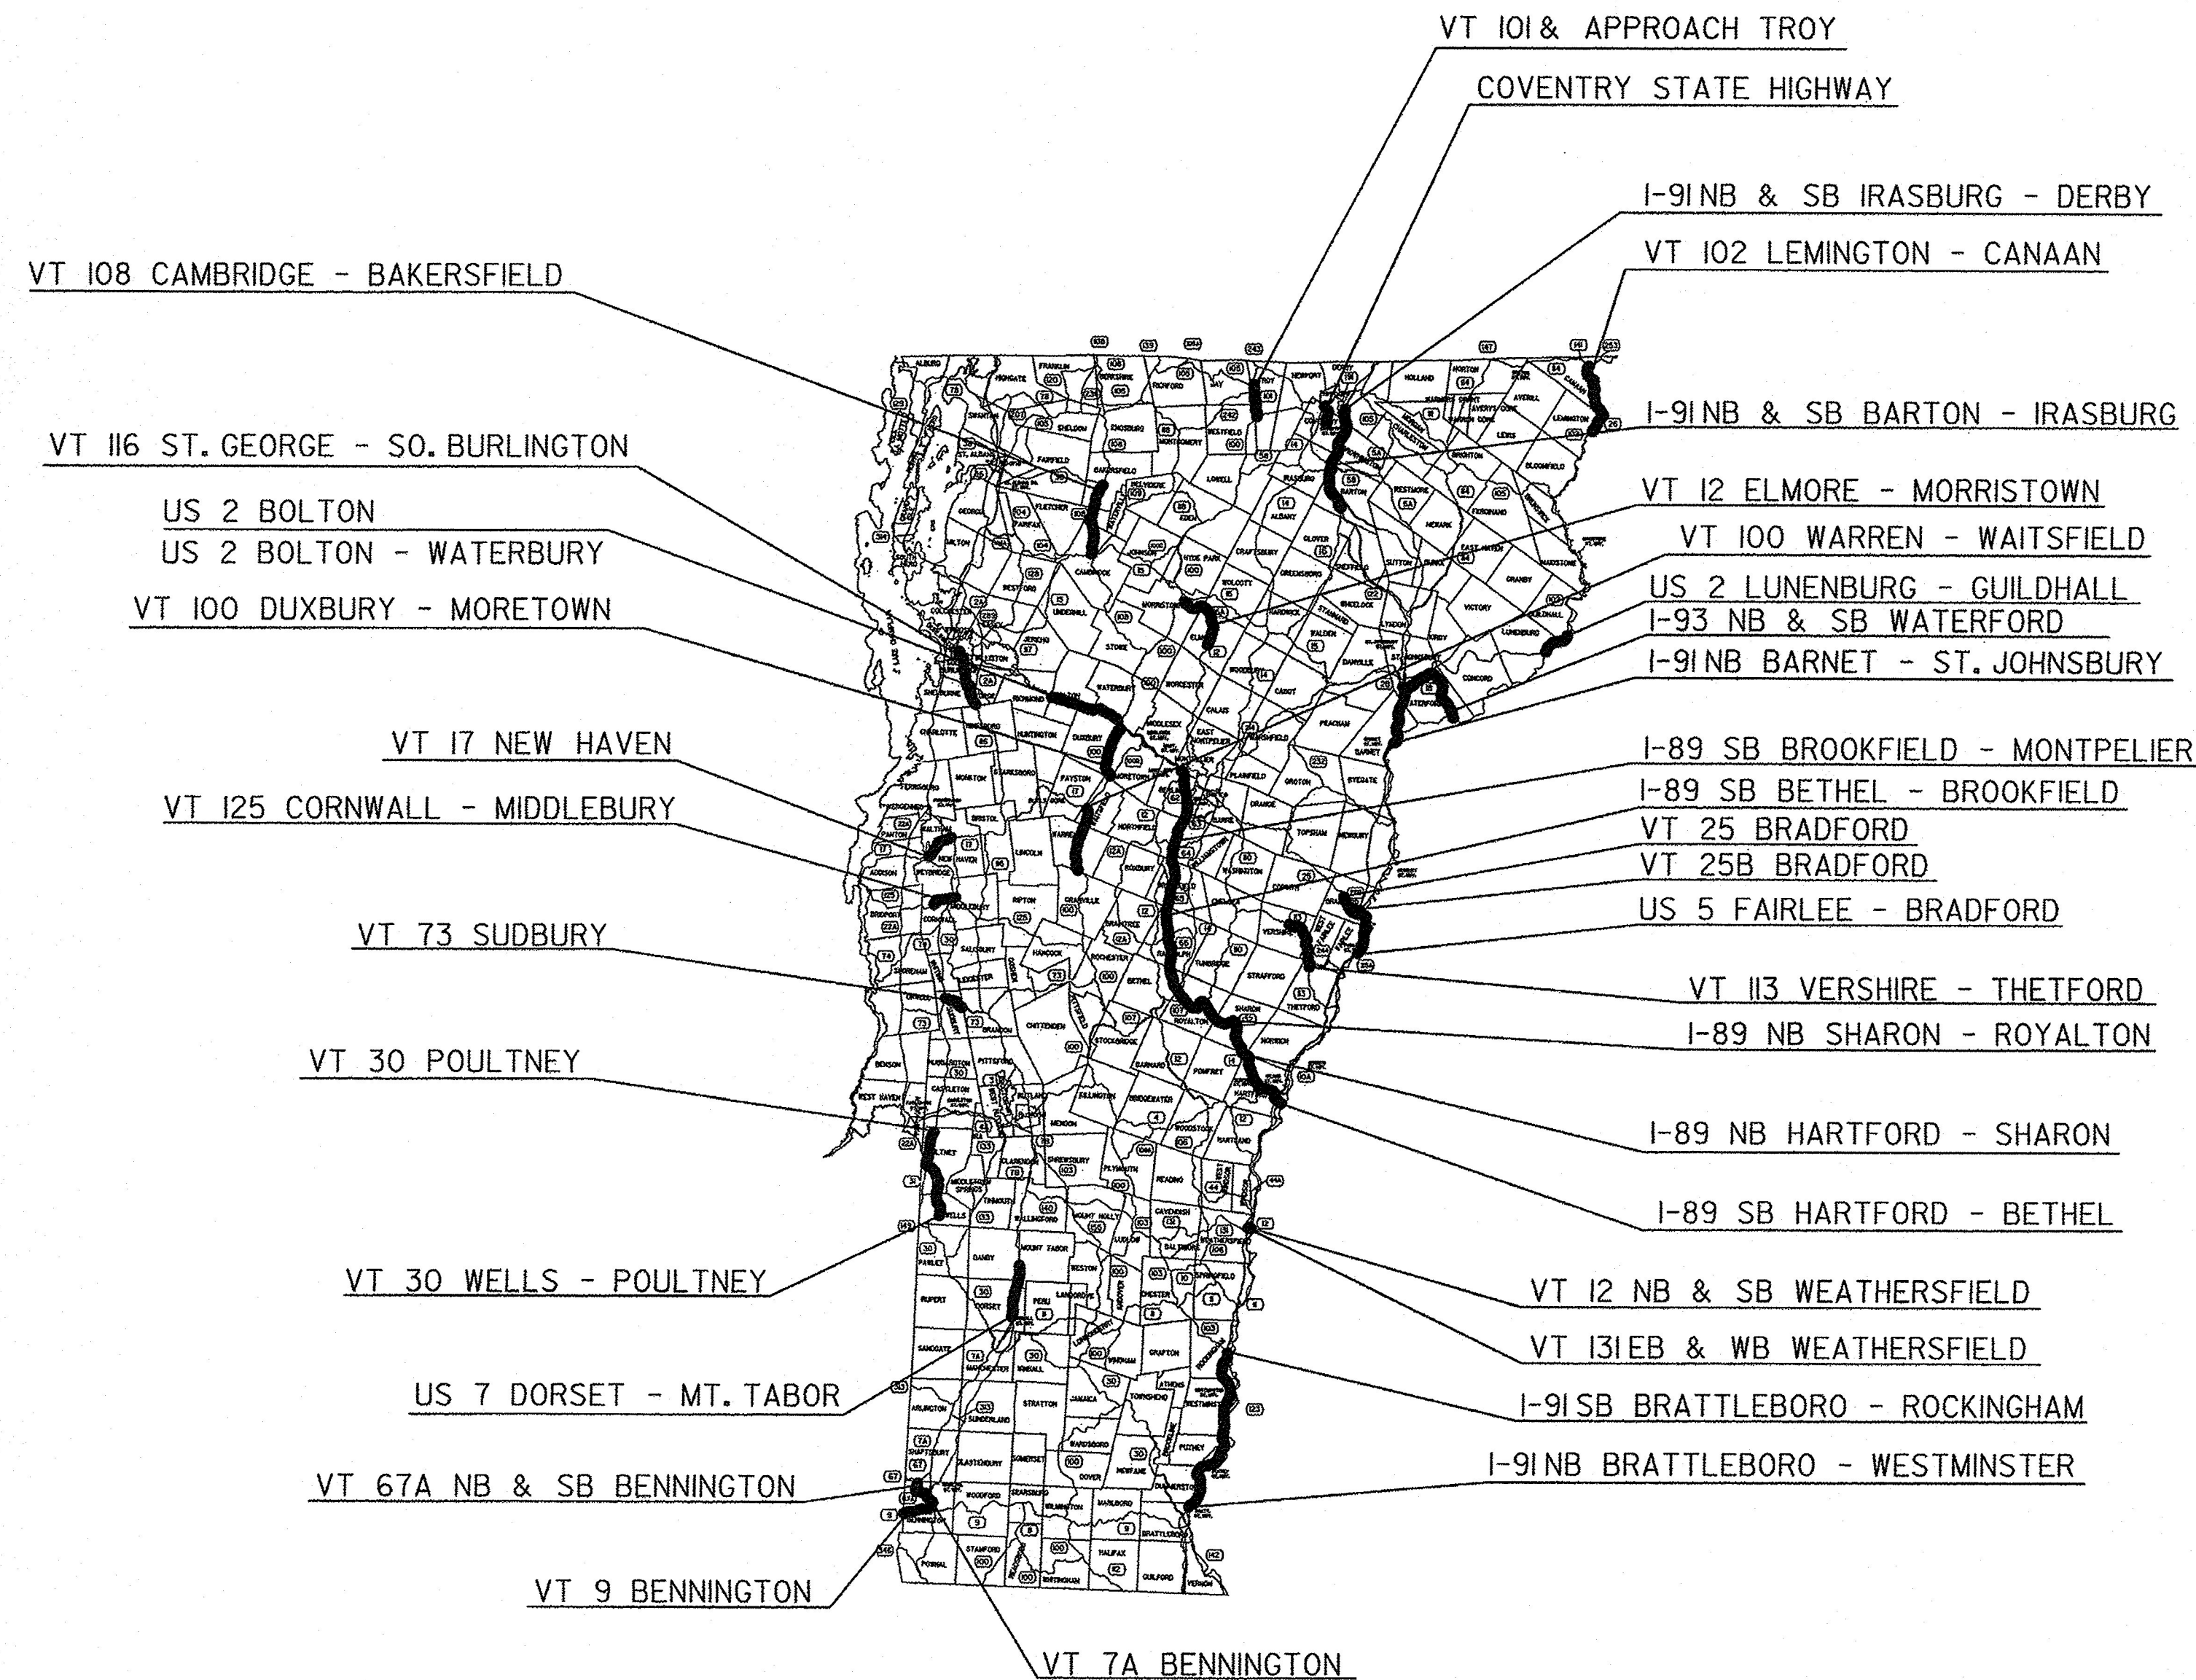

CONSTRUCTION IS TO BE CARRIED ON IN ACCORDANCE WITH THESE PLANS AND THE STANDARD SPECIFICATIONS FOR CONSTRUCTION DATED 2011, AS APPROVED BY THE FEDERAL HIGHWAY ADMINISTRATION ON JULY 20, 2011 FOR USE ON THIS PROJECT, INCLUDING ALL SUBSEQUENT REVISIONS AND SUCH REVISED SPECIFICATIONS AND SPECIAL PROVISIONS AS ARE INCORPORATED IN THESE PLANS.

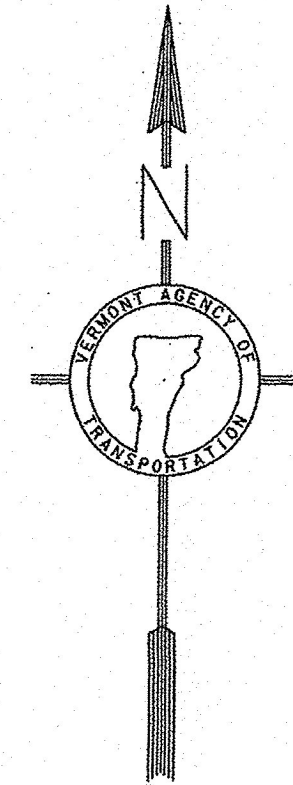

QUALITY ASSURANCE PROGRAM : LEVEL I
SURVEYED BY : N/A
SURVEYED DATE : N/A
DATUM
VERTICAL : N/A
HORIZONTAL : N/A

DIRECTOR OF PROJECT DELIVERY	
APPROVED	DATE 5/16/2017
PROJECT MANAGER : MICHAEL J. FOWLER, P.E.	
PROJECT NAME : STATEWIDE	
PROJECT NUMBER : STP CRAK (35)	
SHEET 1 OF 32 SHEETS	

NOT TO SCALE