

I-89 SOUTH
TO WHITE RIVER
JUNCTION

VT STATE PLANE GRID

U.S. ROUTE 4
TO WHITE RIVER
JUNCTION

RAMP "B"

RAMP "A"

RAMP "C"

RAMP "D"

T.H. 45


DRIVE
DRIVE

U.S. ROUTE 4
TO WOODSTOCK

I-89 NORTH
TO SHARON

QUECHEE INTERCHANGE # 1 I-89

RAMPS REQUIRING CRACK SEALING

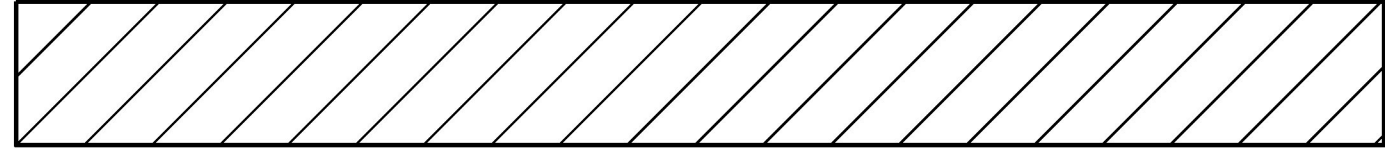

NOT TO SCALE

PROJECT NAME:	STATEWIDE	PLOT DATE:	17-MAY-2017
PROJECT NUMBER:	STP CRAK(35)	DRAWN BY:	LOCKE
FILE NAME:	pl6v2ll.dgn	DESIGNED BY:	LOCKE
PROJECT LEADER:	FOWLER	CHECKED BY:	FOWLER
INTERCHANGE DETAIL SHEET 1		SHEET 7	OF 32