


SHARON INTERCHANGE # 2
I-89

RAMPS REQUIRING CRACK SEALING

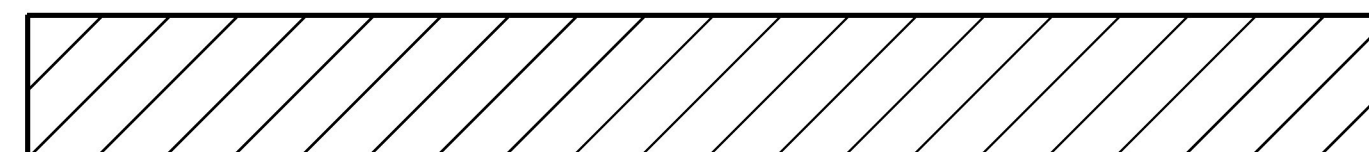

NOT TO SCALE

PROJECT NAME:	STATEWIDE	PLOT DATE:	17-MAY-2017
PROJECT NUMBER:	STP CRAK(35)	DRAWN BY:	LOCKE
FILE NAME:	pl6v2ll.dgn	CHECKED BY:	FOWLER
PROJECT LEADER:	FOWLER	INTERCHANGE DETAIL SHEET 2	SHEET 8 OF 32