


SOUTH BARRE INTERCHANGE # 6
I-89

RAMPS REQUIRING CRACK SEALING

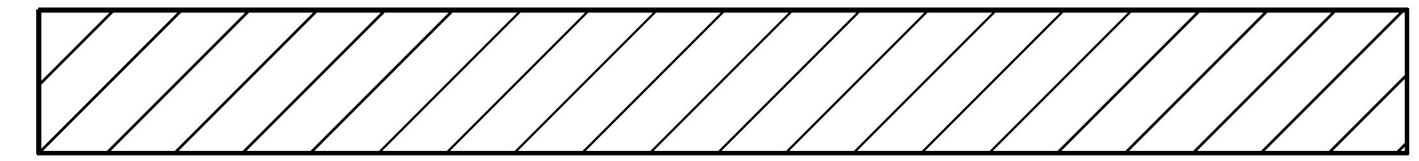

NOT TO SCALE

PROJECT NAME: STATEWIDE	PLOT DATE: 17-MAY-2017
PROJECT NUMBER: STP CRAK(35)	DRAWN BY: LOCKE
FILE NAME: pl6v2ll.dgn	CHECKED BY: FOWLER
PROJECT LEADER: FOWLER	SHEET 12 OF 32
DESIGNED BY: LOCKE	
INTERCHANGE DETAIL SHEET 6	