


**BERLIN INTERCHANGE # 7**  
**I-89**

RAMPS REQUIRING CRACK SEALING

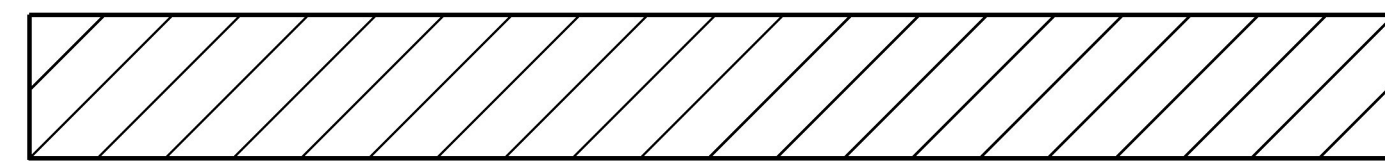

**NOT TO SCALE**

PROJECT NAME: STATEWIDE	PLOT DATE: 17-MAY-2017
PROJECT NUMBER: STP CRAK(35)	DRAWN BY: LOCKE
FILE NAME: pl6v2ll.dgn	CHECKED BY: FOWLER
PROJECT LEADER: FOWLER	SHEET 13 OF 32
DESIGNED BY: LOCKE	INTERCHANGE DETAIL SHEET 7