


**DUMMERSTON & PUTNEY INTERCHANGE # 4**  
**I-91**

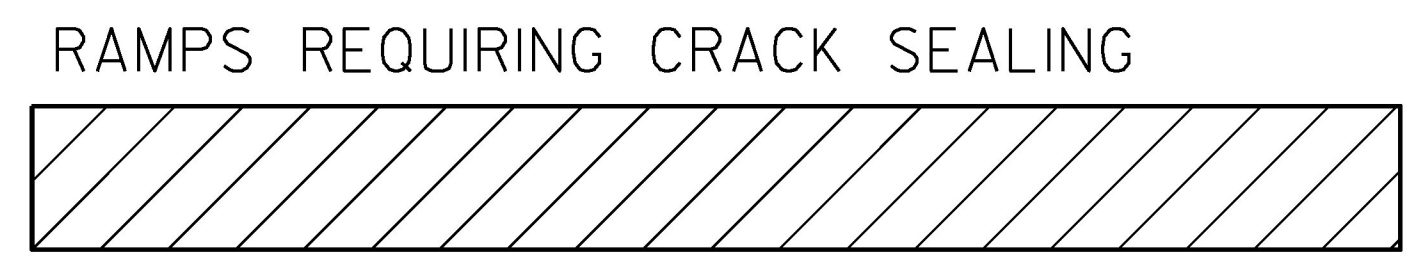

**NOT TO SCALE**

PROJECT NAME:	STATEWIDE	PLOT DATE:	17-MAY-2017
PROJECT NUMBER:	STP CRAK(35)	DRAWN BY:	LOCKE
FILE NAME:	pl6v2ll.dgn	CHECKED BY:	FOWLER
PROJECT LEADER:	FOWLER	INTERCHANGE DETAIL SHEET	9
DESIGNED BY:	LOCKE	SHEET	15 OF 32