

TO
TOWN GARAGE


WESTMINSTER

STATE HIGHWAY

TO
JCT US 5

RAMP B


SOUTHBOUND
I-91
TO PUTNEY

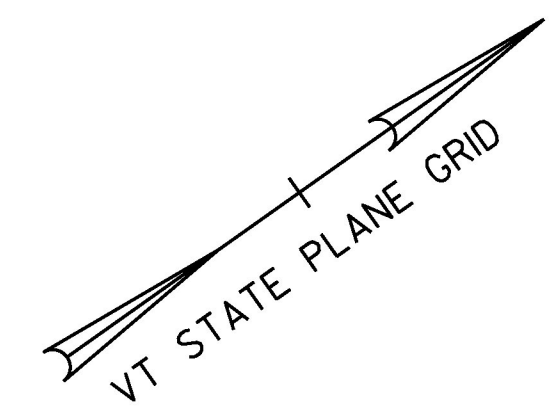

WESTMINSTER INTERCHANGE # 5

I-91

RAMPS REQUIRING CRACK SEALING

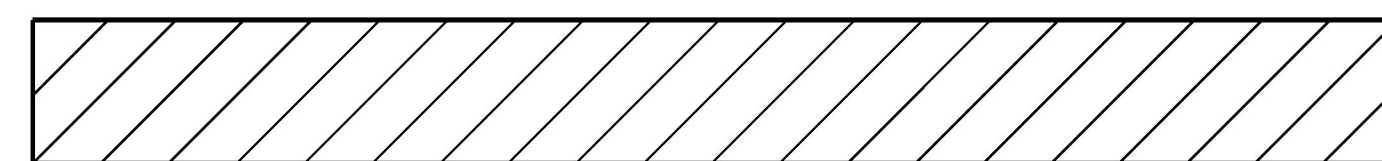

NOT TO SCALE

PROJECT NAME:	STATEWIDE	PLOT DATE:	17-MAY-2017
PROJECT NUMBER:	STP CRAK(35)	DRAWN BY:	LOCKE
FILE NAME:	pl6v2ll.dgn	CHECKED BY:	FOWLER
PROJECT LEADER:	FOWLER	INTERCHANGE DETAIL SHEET II	SHEET 17 OF 32