


WESTMINSTER INTERCHANGE #5
I-91

RAMPS REQUIRING CRACK SEALING

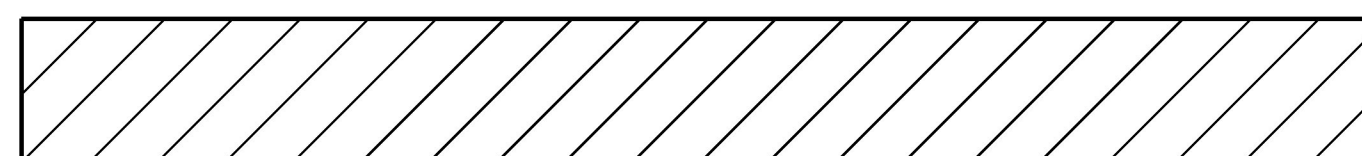

NOT TO SCALE

PROJECT NAME:	STATEWIDE	PLOT DATE:	17-MAY-2017
PROJECT NUMBER:	STP CRAK(35)	DRAWN BY:	LOCKE
FILE NAME:	pl6v2ll.dgn	CHECKED BY:	PAVT MGMT
PROJECT LEADER:	FOWLER	INTERCHANGE DETAIL SHEET	13
DESIGNED BY:	LOCKE	SHEET	19
		OF	32