


**ROCKINGHAM INTERCHANGE # 6**

**I-91**

RAMPS REQUIRING CRACK SEALING

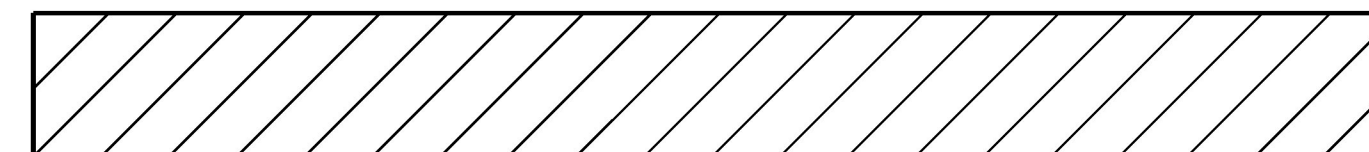

**NOT TO SCALE**

PROJECT NAME: STATEWIDE	PLOT DATE: 17-MAY-2017
PROJECT NUMBER: STP CRAK(35)	DRAWN BY: LOCKE
FILE NAME: pl6v2ll.dgn	DESIGNED BY: LOCKE
PROJECT LEADER: FOWLER	CHECKED BY: FOWLER
INTERCHANGE DETAIL SHEET 16	SHEET 22 OF 32