




SEE PREVIOUS SHEET

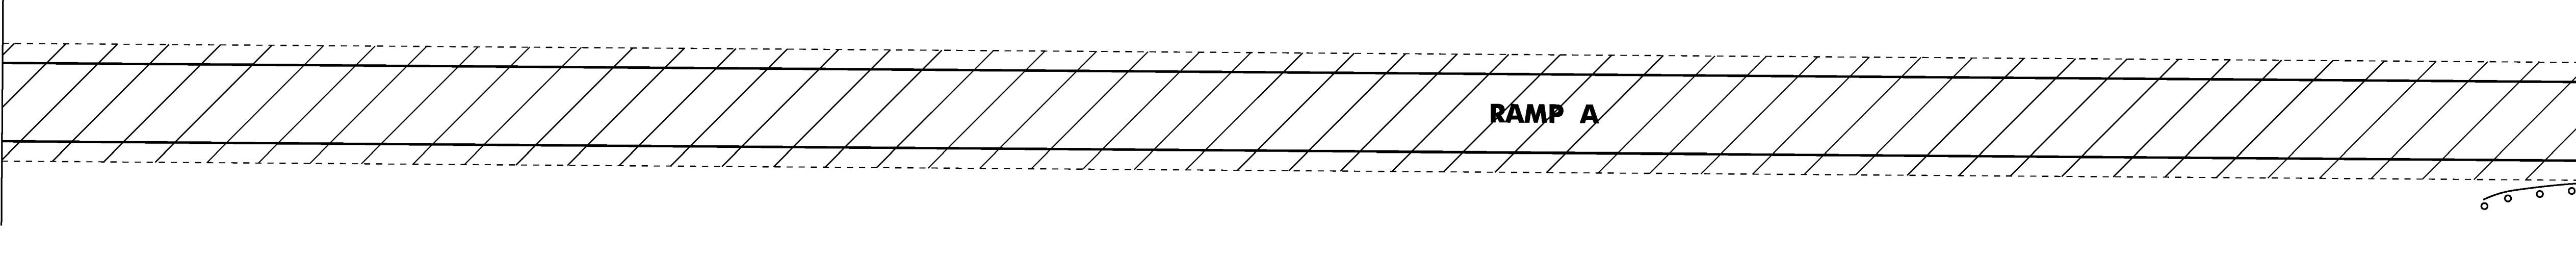

SEE BELOW

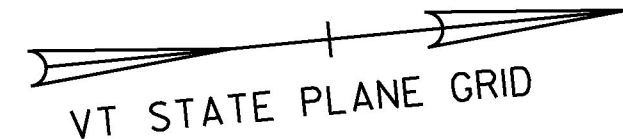

SEE ABOVE

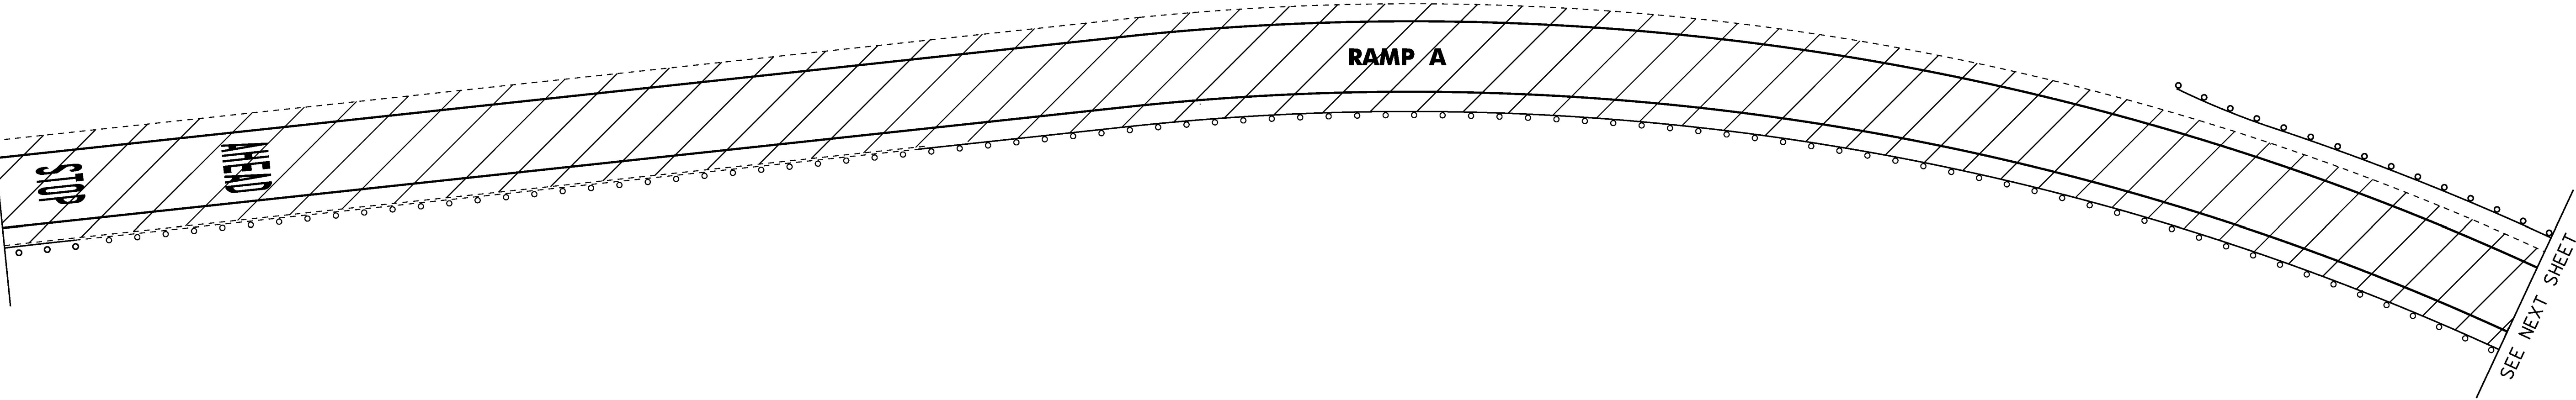


SEE NEXT SHEET

ROCKINGHAM INTERCHANGE # 6

I-91

RAMPS REQUIRING CRACK SEALING

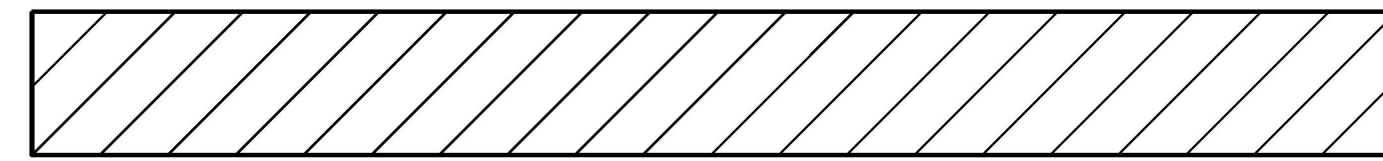

NOT TO SCALE

PROJECT NAME: STATEWIDE	PLOT DATE: 17-MAY-2017
PROJECT NUMBER: STP CRAK(35)	DRAWN BY: LOCKE
FILE NAME: pl6v2ll.dgn	CHECKED BY: FOWLER
PROJECT LEADER: FOWLER	SHEET 23 OF 32
DESIGNED BY: LOCKE	INTERCHANGE DETAIL SHEET 17