


ORLEANS INTERCHANGE #26
I-91

RAMPS REQUIRING CRACK SEALING

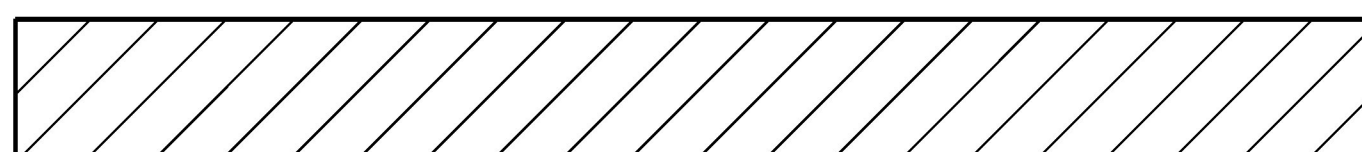

NOT TO SCALE

PROJECT NAME:	STATEWIDE	PLOT DATE:	17-MAY-2017
PROJECT NUMBER:	STP CRAK(35)	DRAWN BY:	LOCKE
FILE NAME:	pl6v2ll.dgn	DESIGNED BY:	LOCKE
PROJECT LEADER:	FOWLER	CHECKED BY:	PAVT MGMT
INTERCHANGE DETAIL SHEET	23	SHEET	29 OF 32