



SOUTHBOUND I-89
TO BETHEL

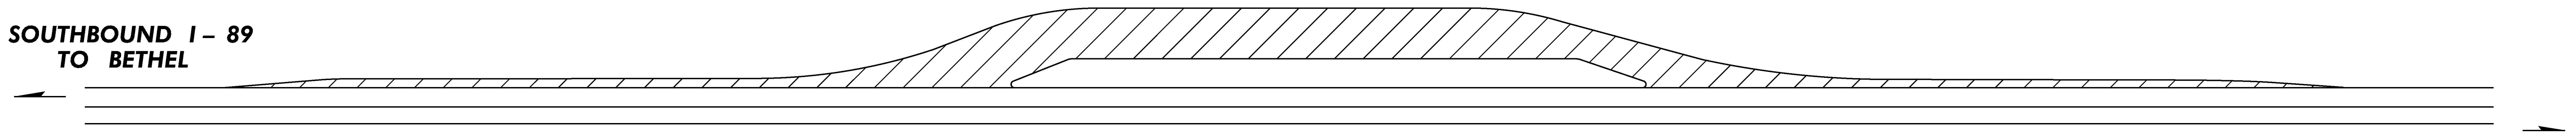


NORTHBOUND I-89
TO BARRE

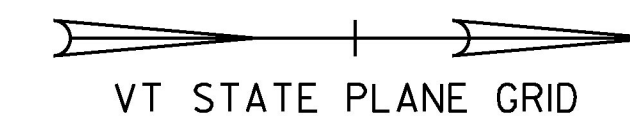

RANDOLPH PARKING AREA /WEIGH STATION
I-89 SB MM 29.700

AREA REQUIRING CRACK SEALING

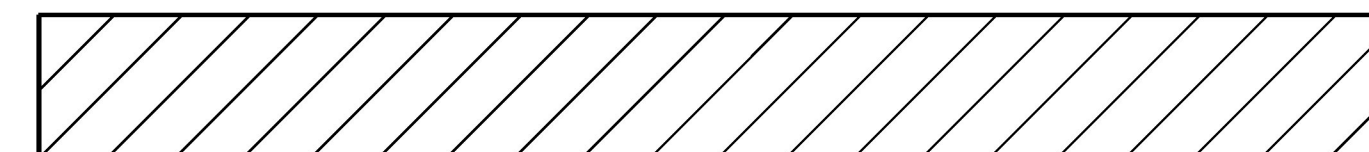

NOT TO SCALE

PROJECT NAME: STATEWIDE	PLOT DATE: 17-MAY-2017
PROJECT NUMBER: STP CRAK(35)	DRAWN BY: LOCKE
FILE NAME: pl6v2ll.dgn	CHECKED BY: PAVT MGMT
PROJECT LEADER: FOWLER	SHEET 31 OF 32
DESIGNED BY: LOCKE	
INTERCHANGE DETAIL SHEET 25	