
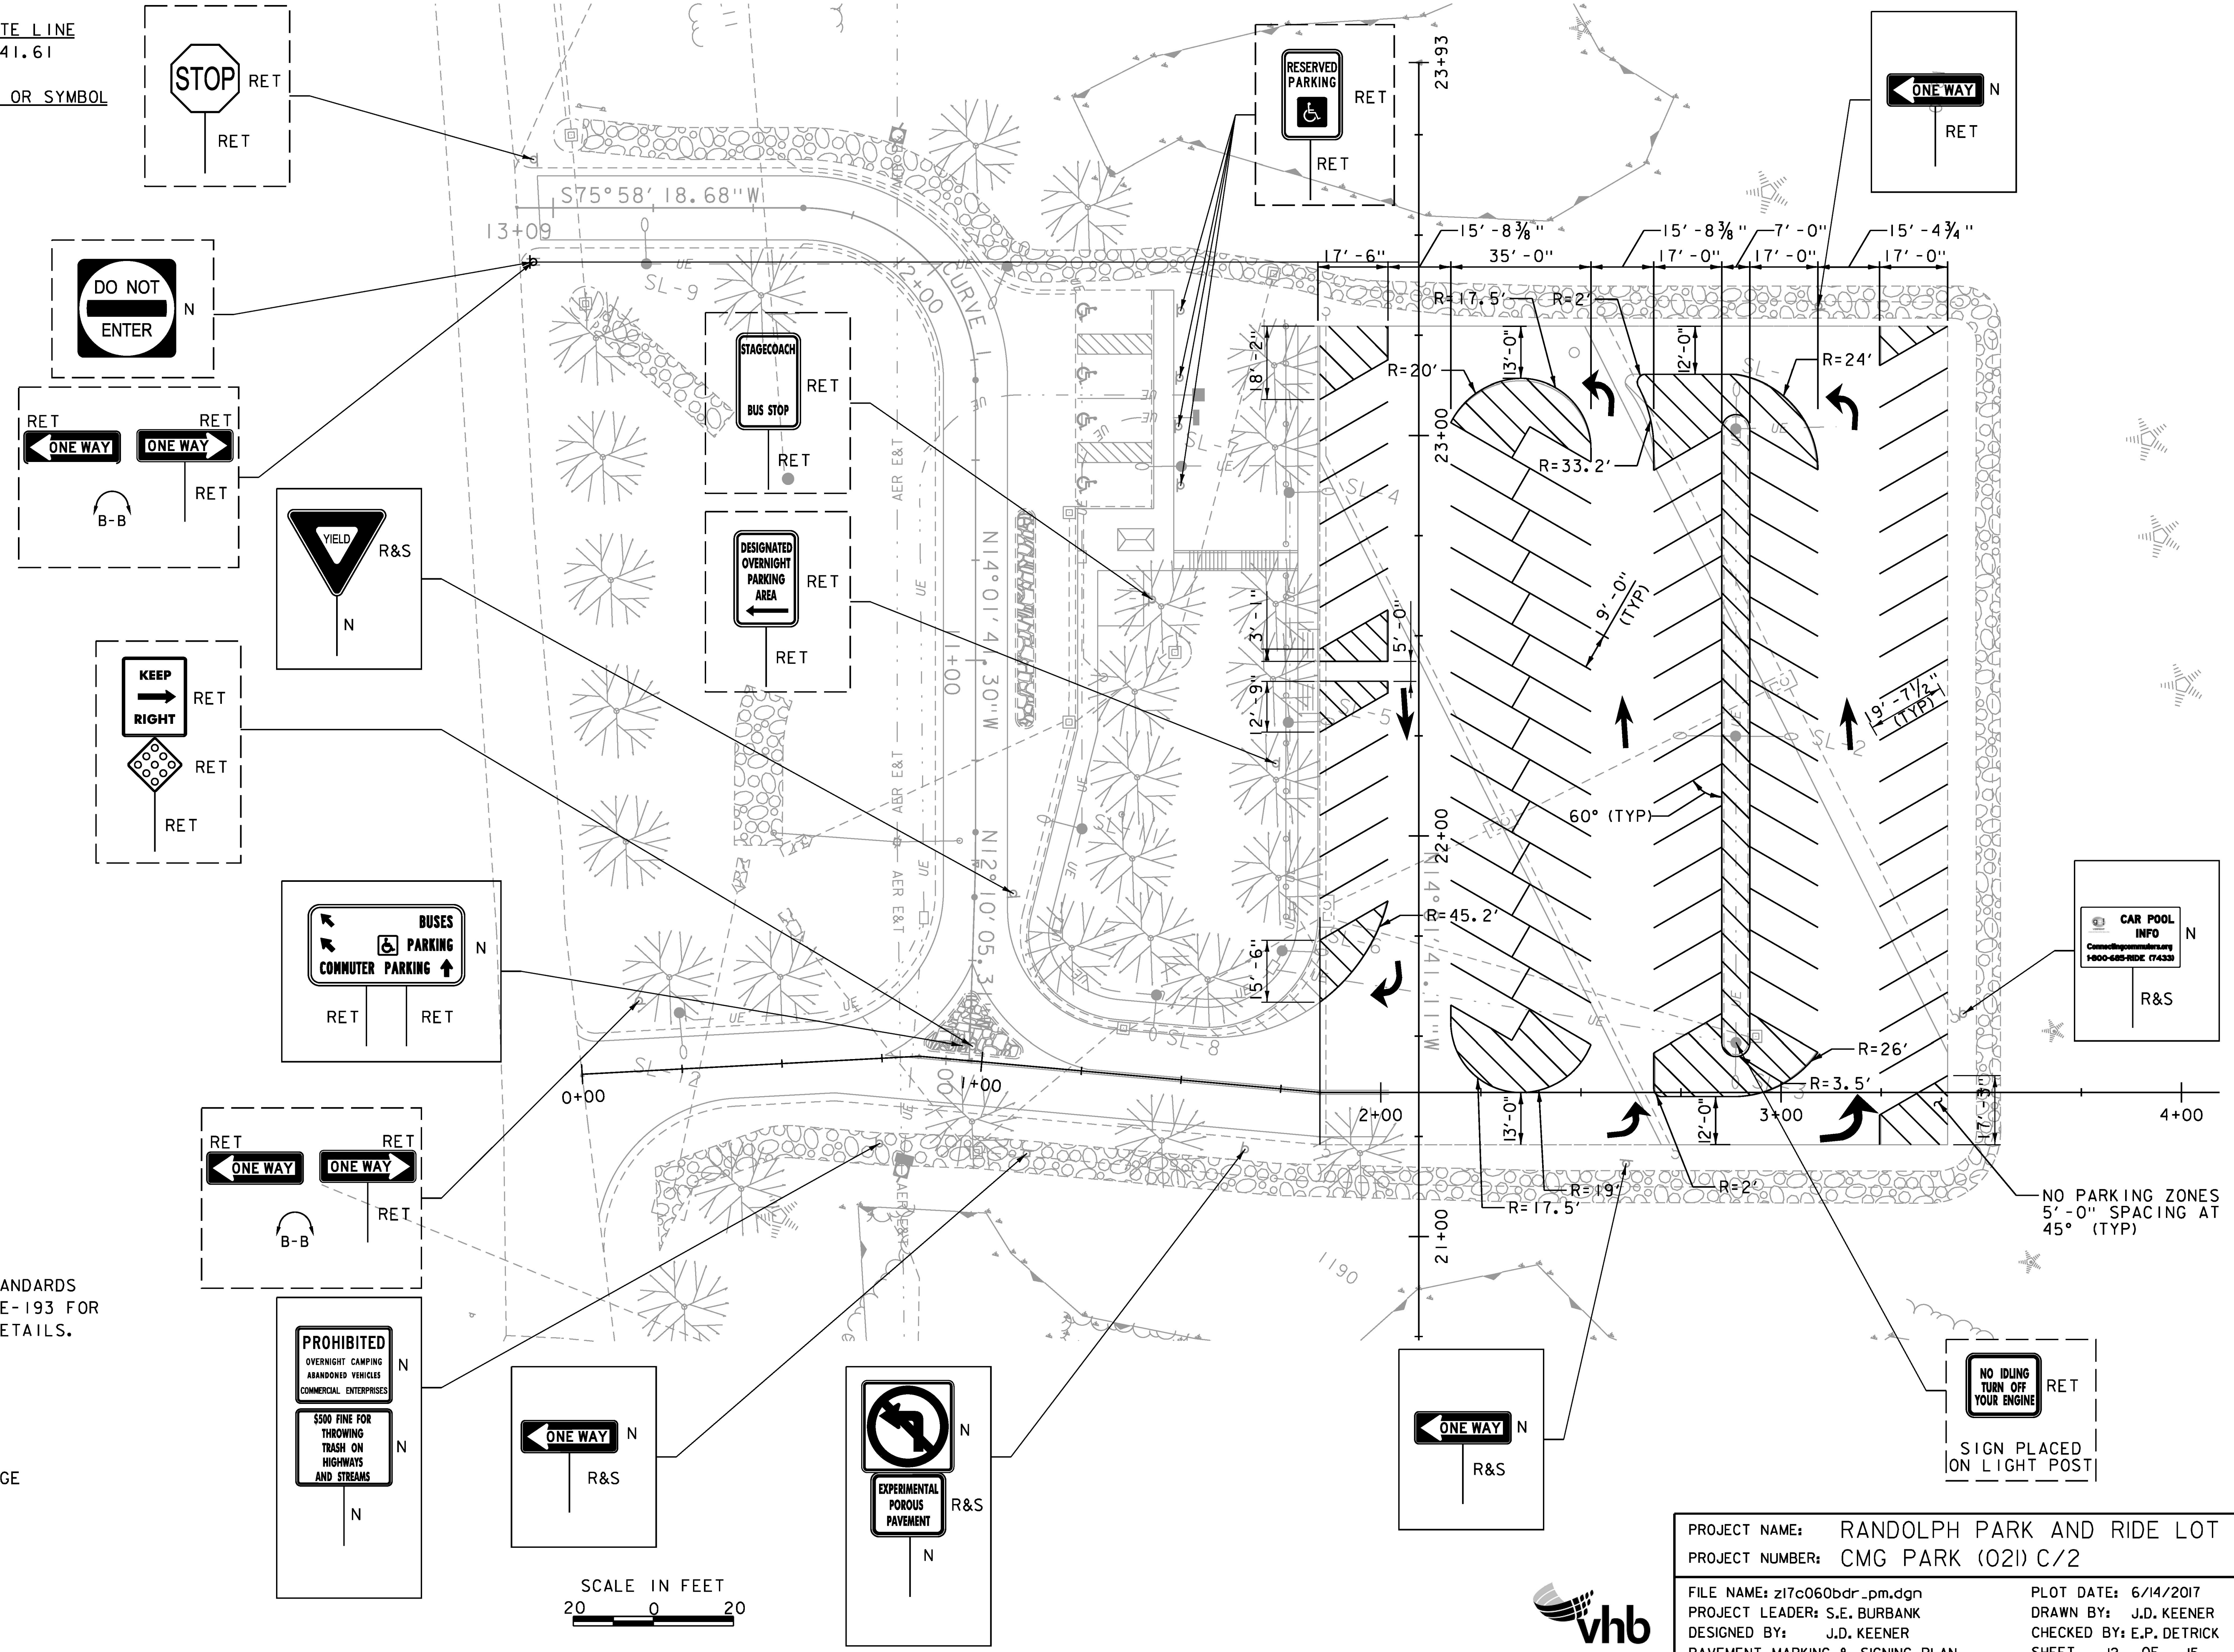


646.400 DURABLE 4" WHITE LINE
STA. 1+84.8 TO STA. 3+41.61

646.490 DURABLE LETTER OR SYMBOL
STA. 2+04, LT. -
STA. 2+04, LT. -
STA. 2+35, LT. -
STA. 2+35, LT. -
STA. 2+35, RT. -
STA. 2+92, LT. -
STA. 2+92, LT. -
STA. 2+92, RT. -

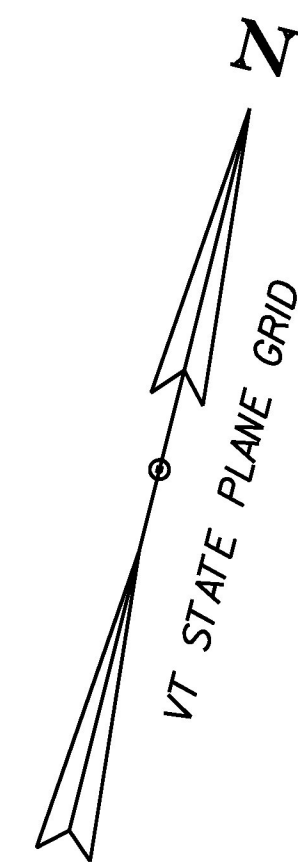

NOTES:

- REFER TO VTRANS STANDARDS E-191, E-192, AND E-193 FOR PAVEMENT MARKING DETAILS.

SIGN LEGEND:

N = NEW
RET = RETAIN
R&S = REMOVE AND SALVAGE

B-B = BACK TO BACK

PROHIBITED
OVERNIGHT CAMPING
ABANDONED VEHICLES
COMMERCIAL ENTERPRISES
\$500 FINE FOR
THROWING TRASH ON
HIGHWAYS
AND STREAMS

SCALE IN FEET
20 0 20

PROJECT NAME:	RANDOLPH PARK AND RIDE LOT
PROJECT NUMBER:	CMG PARK (021) C/2
FILE NAME:	z17c060bdr_pm.dgn
PROJECT LEADER:	S.E. BURBANK
DESIGNED BY:	J.D. KEENER
PAVEMENT MARKING & SIGNING PLAN	
PLOT DATE:	6/14/2017
DRAWN BY:	J.D. KEENER
CHECKED BY:	E.P. DETRICK
SHEET	12 OF 15