


INDEX OF SHEETS

- 1 TITLE SHEET
- 2 QUANTITY SHEET
- 3 TRAFFIC CONTROL PLAN
- 4 MISCELLANEOUS DETAILS SHEET
- 5-7 ROAD QUANTITY SHEETS 1-3
- 8 ROAD SUMMARY SHEET
- 9-18 CLASS 2 TOWN HIGHWAY QUANTITY SHEETS 1-10

VTRANS STANDARDS

E-192	PAVEMENT MARKING DETAILS	10/12/2000
E-193	PAVEMENT MARKING DETAILS	08/18/1995
T-1	TRAFFIC CONTROL GENERAL NOTES	04/25/2016
T-11	CONSTRUCTION APPROACH SIGNING	08/06/2012
	DIVIDED HIGHWAY ONE LANE CLOSED	
T-12	TRAFFIC CONTROL DIVIDED HIGHWAY ONE LANE CLOSED	08/06/2012
T-22	TRAFFIC CONTROL FOR PAVEMENT MARKING ON DIVIDED HIGHWAY	08/06/2012
T-23	TRAFFIC CONTROL FOR PAVEMENT MARKING ON DIVIDED HIGHWAY	08/06/2012
T-24	TRAFFIC CONTROL FOR MAINTENANCE PAVEMENT MARKING OPERATION	08/06/2012
T-28	CONSTRUCTION SIGN DETAILS	08/06/2012
T-29	CONSTRUCTION SIGN DETAILS	08/06/2012
T-31	CONSTRUCTION SIGN DETAILS	08/06/2012


STATE OF VERMONT AGENCY OF TRANSPORTATION

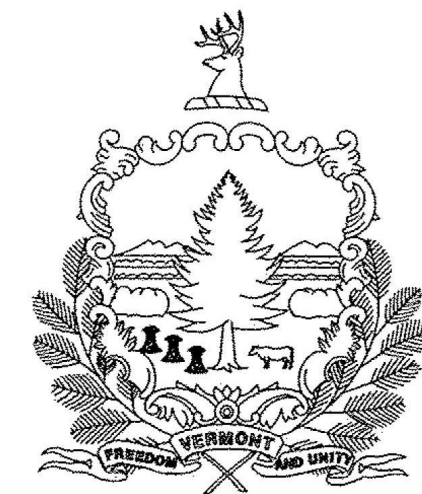

PROPOSED IMPROVEMENT STATEWIDE - NORTHEAST REGION VARIOUS FUNCTIONAL CLASSIFICATIONS OF STATE ROADS, CLASS 1 & CLASS 2 TOWN HIGHWAYS

APPLICATION OF CENTER LINE, EDGE LINE AND LANE LINE MARKINGS ON NATIONAL HIGHWAY AND STATE SYSTEM ROADS. APPLICATION OF CENTER LINE MARKINGS ONLY ON CLASS 1 AND CLASS 2 TOWN HIGHWAYS WITHIN THE NORTHEAST REGION (DISTRICT #7 AND DISTRICT #9).

LENGTH OF PROJECT 1084.742 MI = 5,727,437.76 LF

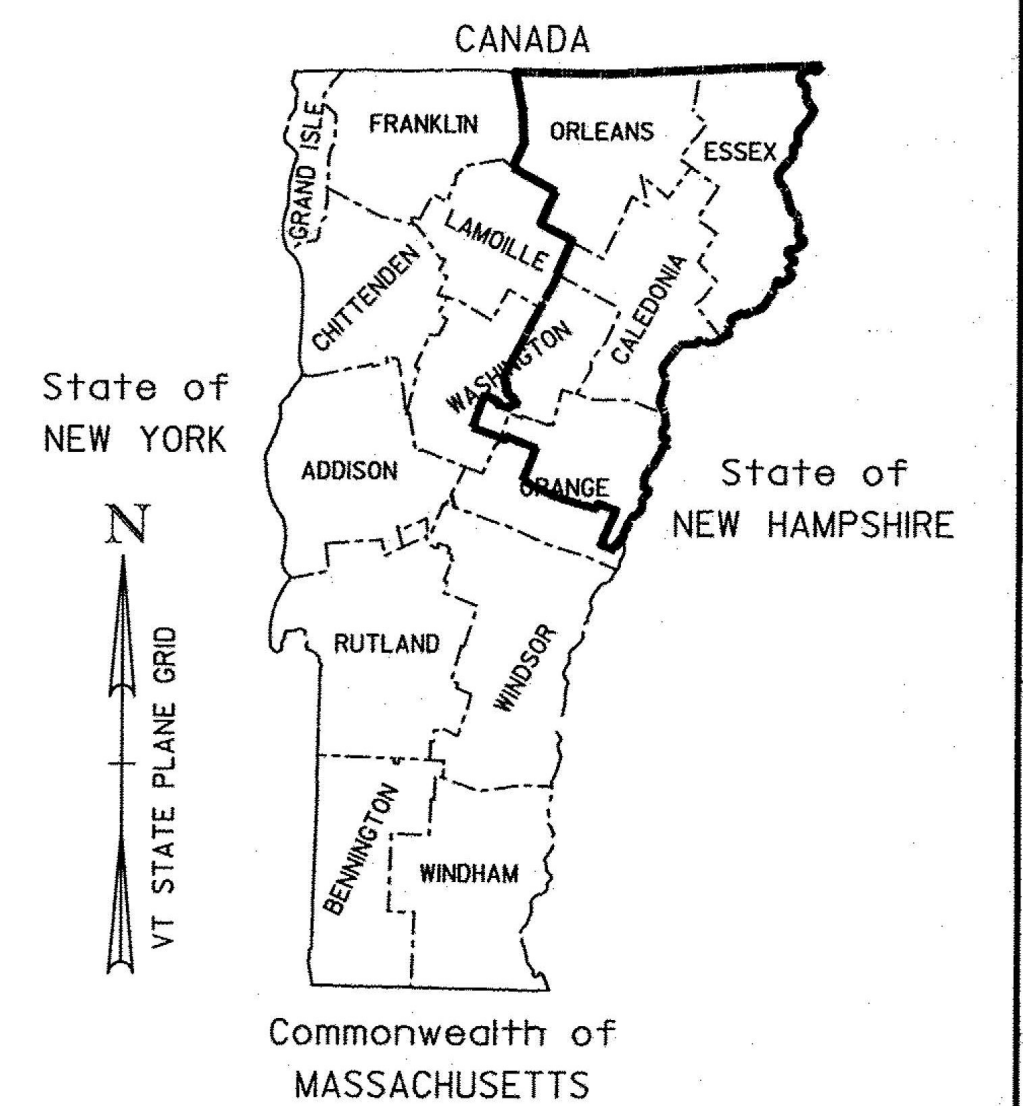

Record Plans

Contractor: L&D SAFETY MARKING CORP.
 Resident Engineer: RYAN CORKINS
 Construction Began: 5/29/2018
 Construction Complete: 10/29/2019
 Record Plans By: RYAN CORKINS

I hereby certify that all construction required by this set of drawings has been accomplished as indicated herein.


E-SIGNED by Ryan Corkins
 on 2020-03-11 13:08:30 GMT
 BY: _____ Resident Engineer

Date: March 11, 2020

NOTE: Any further information concerning final quantities, amounts or other details relative to this project may be found at Central Files in the electronic archives.

CONSTRUCTION IS TO BE CARRIED ON IN ACCORDANCE WITH THESE PLANS AND THE STANDARD SPECIFICATIONS FOR CONSTRUCTION DATED 2011, AS APPROVED BY THE FEDERAL HIGHWAY ADMINISTRATION ON JULY 20, 2011 FOR USE ON THIS PROJECT, INCLUDING ALL SUBSEQUENT REVISIONS AND SUCH REVISED SPECIFICATIONS AND SPECIAL PROVISIONS AS ARE INCORPORATED IN THESE PLANS.

QUALITY ASSURANCE PROGRAM : LEVEL 1	
SURVEYED BY :	N/A
SURVEYED DATE :	N/A
DATUM	
VERTICAL	N/A
HORIZONTAL	N/A

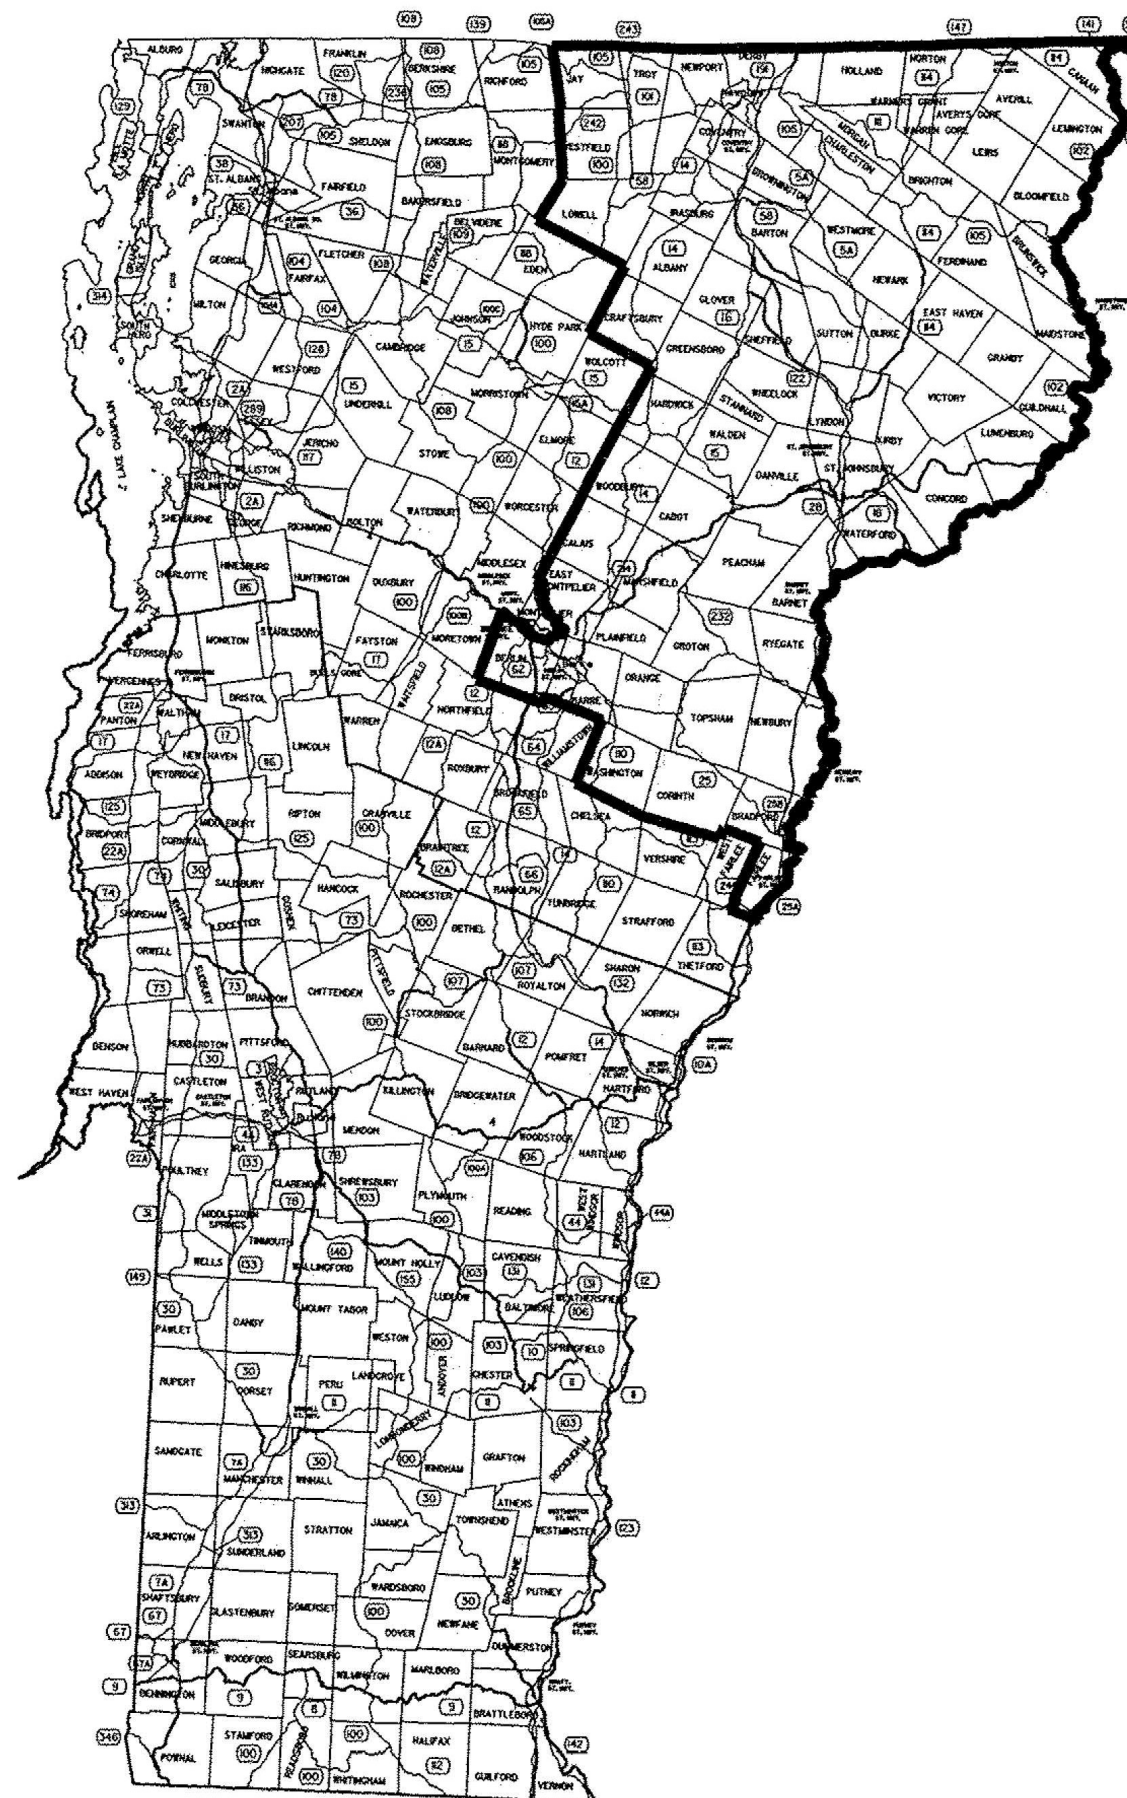

BUILT AS DESIGNED

DIRECTOR OF PROJECT DELIVERY	
APPROVED: <i>[Signature]</i>	DATE: 2/6/2018
PROJECT MANAGER : PATRICIA COBURN P.E.	
PROJECT NAME : STATEWIDE-NORTHEAST REGION	
PROJECT NUMBER : STPG MARK(310)	
SHEET 1 OF 18 SHEETS	