


INDEX OF SHEETS

- 1 TITLE SHEET
- 2 QUANTITY SHEET
- 3 TRAFFIC CONTROL PLAN
- 4 MISCELLANEOUS DETAILS SHEET
- 5-7 ROAD QUANTITY SHEETS 1-3
- 8 ROAD SUMMARY SHEET
- 9-18 CLASS 2 TOWN HIGHWAY QUANTITY SHEETS 1-10

VTRANS STANDARDS

E-192	PAVEMENT MARKING DETAILS	10/12/2000
E-193	PAVEMENT MARKING DETAILS	08/18/1995
T-1	TRAFFIC CONTROL GENERAL NOTES	04/25/2016
T-11	CONSTRUCTION APPROACH SIGNING	08/06/2012
	DIVIDED HIGHWAY ONE LANE CLOSED	
T-12	TRAFFIC CONTROL DIVIDED HIGHWAY ONE LANE CLOSED	08/06/2012
T-22	TRAFFIC CONTROL FOR PAVEMENT MARKING ON DIVIDED HIGHWAY	08/06/2012
T-23	TRAFFIC CONTROL FOR PAVEMENT MARKING ON DIVIDED HIGHWAY	08/06/2012
T-24	TRAFFIC CONTROL FOR MAINTENANCE PAVEMENT MARKING OPERATION	08/06/2012
T-28	CONSTRUCTION SIGN DETAILS	08/06/2012
T-29	CONSTRUCTION SIGN DETAILS	08/06/2012
T-31	CONSTRUCTION SIGN DETAILS	08/06/2012


STATE OF VERMONT AGENCY OF TRANSPORTATION

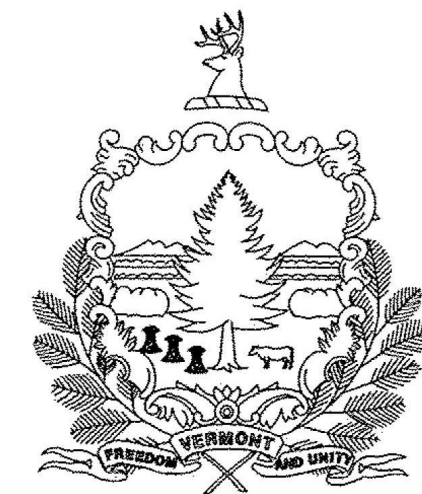

PROPOSED IMPROVEMENT STATEWIDE - NORTHEAST REGION VARIOUS FUNCTIONAL CLASSIFICATIONS OF STATE ROADS, CLASS 1 & CLASS 2 TOWN HIGHWAYS

APPLICATION OF CENTER LINE, EDGE LINE AND LANE LINE MARKINGS ON NATIONAL HIGHWAY AND STATE SYSTEM ROADS. APPLICATION OF CENTER LINE MARKINGS ONLY ON CLASS 1 AND CLASS 2 TOWN HIGHWAYS WITHIN THE NORTHEAST REGION (DISTRICT #7 AND DISTRICT #9).

LENGTH OF PROJECT 1084.742 MI = 5,727,437.76 LF

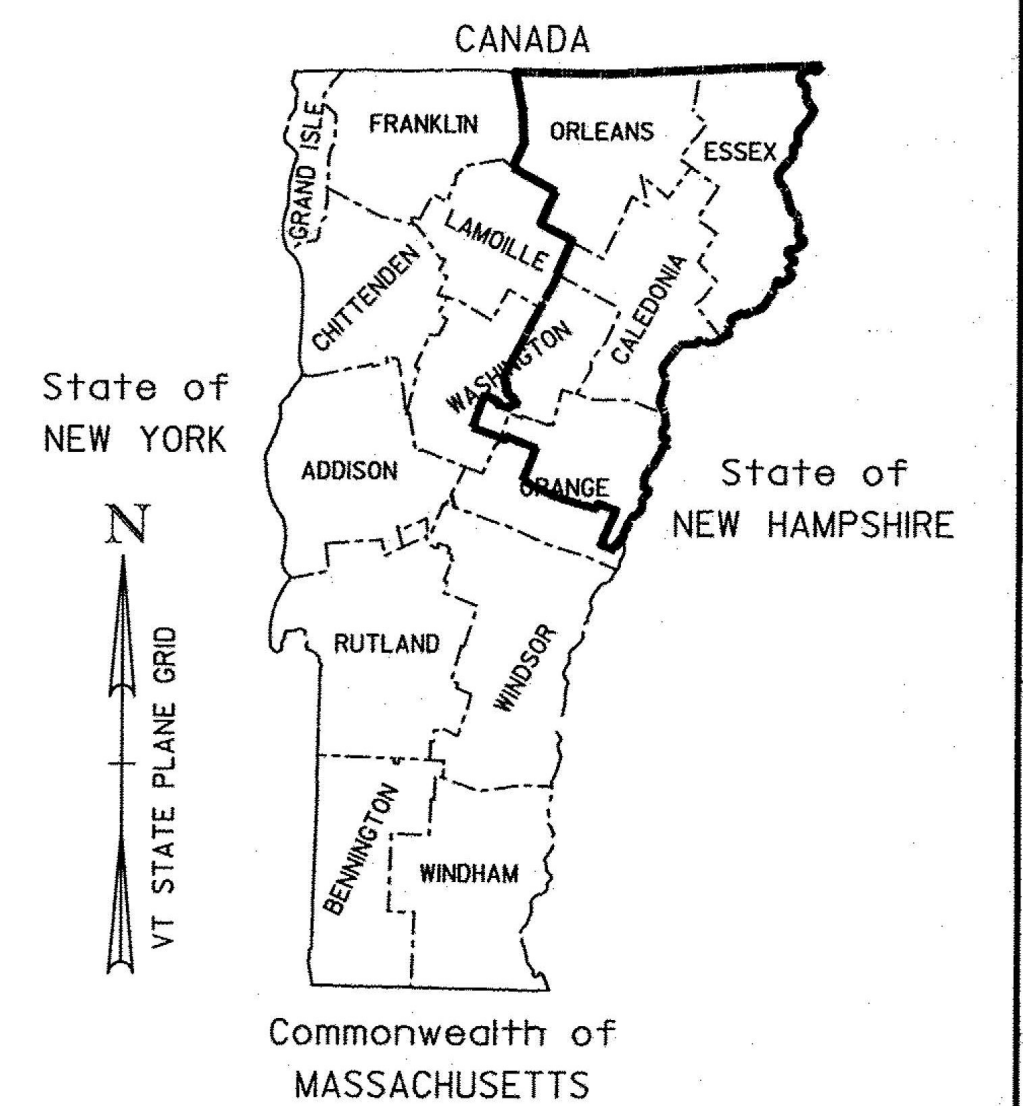

Record Plans

Contractor: L&D SAFETY MARKING CORP.
Resident Engineer: RYAN CORKINS
Construction Began: 5/29/2018
Construction Complete: 10/29/2019
Record Plans By: RYAN CORKINS

I hereby certify that all construction required by this set of drawings has been accomplished as indicated herein.



E-SIGNED by Ryan Corkins
on 2020-03-11 13:08:30 GMT
Resident Engineer

Date: March 11, 2020

NOTE: Any further information concerning final quantities, amounts or other details relative to this project may be found at Central Files in the electronic archives.

CONSTRUCTION IS TO BE CARRIED ON IN ACCORDANCE WITH THESE PLANS AND THE STANDARD SPECIFICATIONS FOR CONSTRUCTION DATED 2011, AS APPROVED BY THE FEDERAL HIGHWAY ADMINISTRATION ON JULY 20, 2011 FOR USE ON THIS PROJECT, INCLUDING ALL SUBSEQUENT REVISIONS AND SUCH REVISED SPECIFICATIONS AND SPECIAL PROVISIONS AS ARE INCORPORATED IN THESE PLANS.

QUALITY ASSURANCE PROGRAM : LEVEL 1	
SURVEYED BY :	N/A
SURVEYED DATE :	N/A
DATUM	
VERTICAL	N/A
HORIZONTAL	N/A

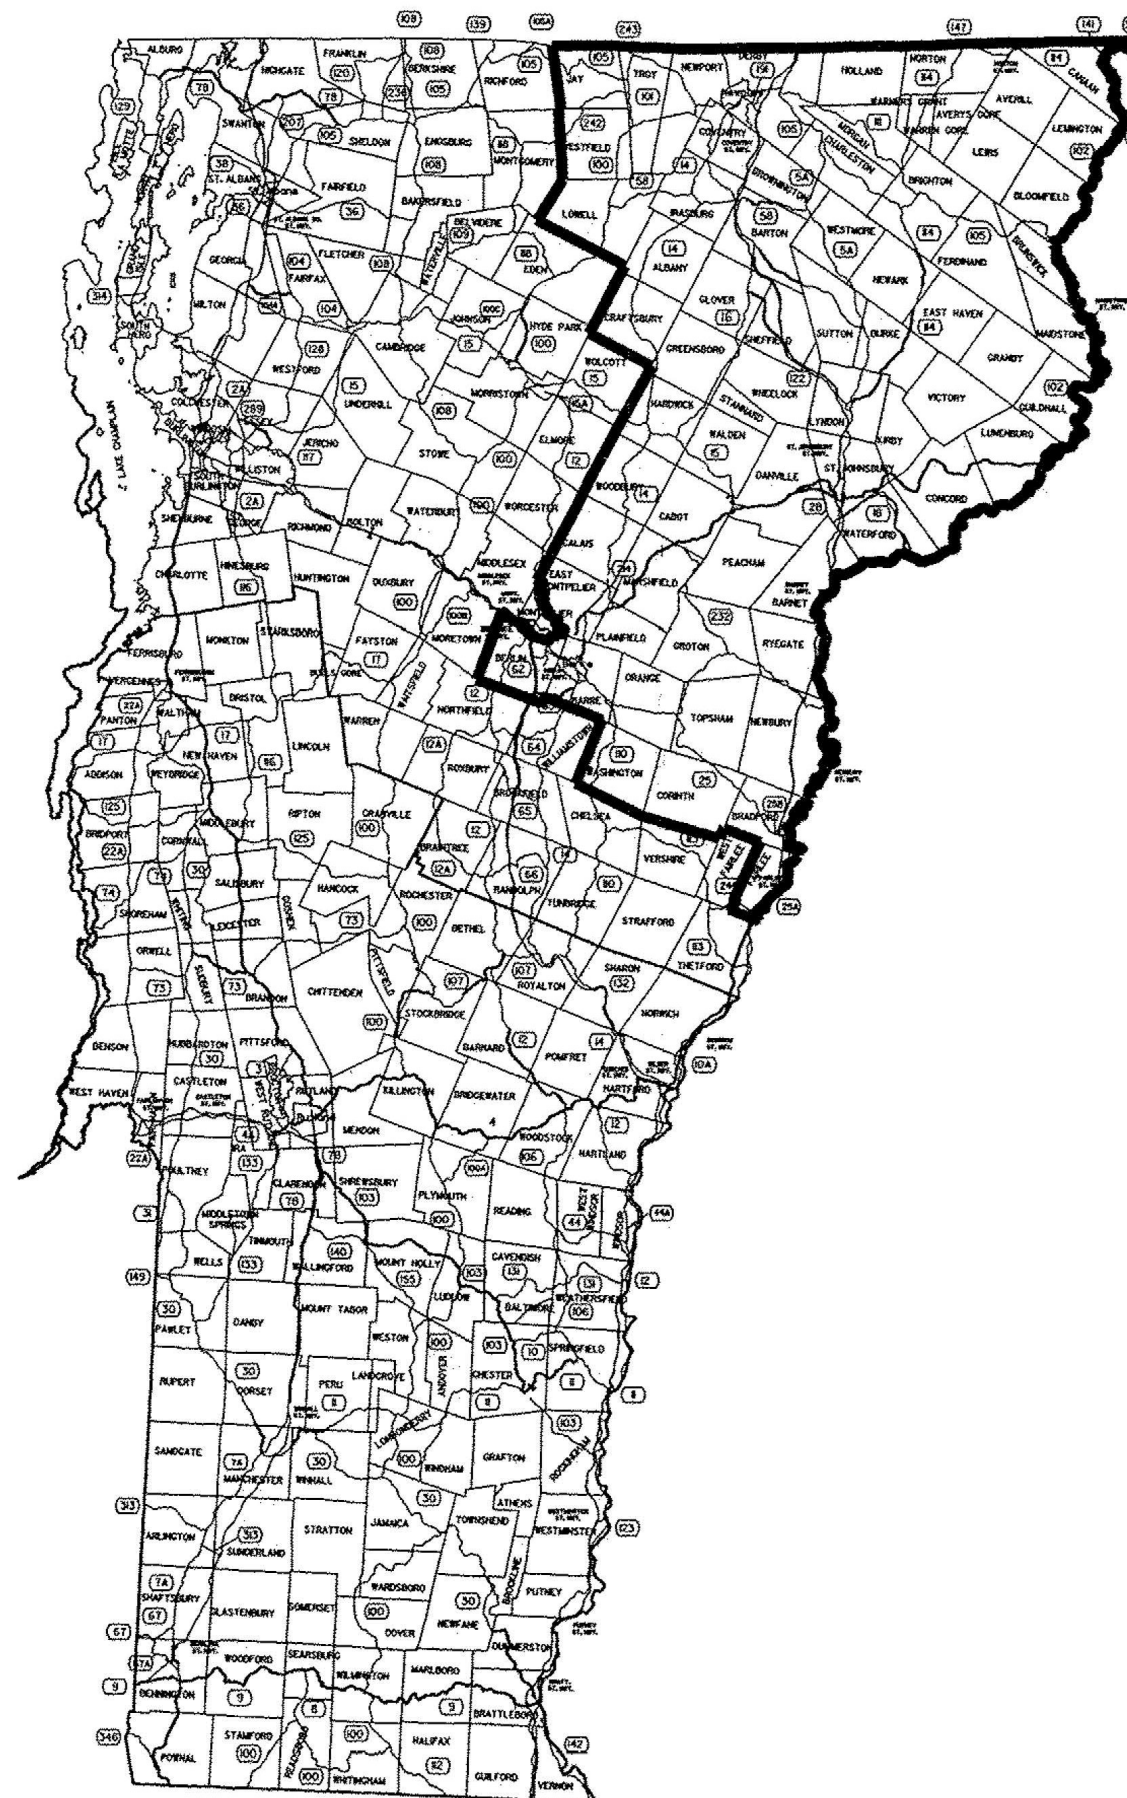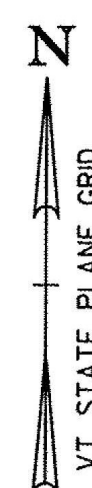

BUILT AS DESIGNED


DIRECTOR OF PROJECT DELIVERY	
APPROVED <i>[Signature]</i>	DATE 2/6/2018
PROJECT MANAGER : PATRICIA COBURN P.E.	
PROJECT NAME : STATEWIDE-NORTHEAST REGION	
PROJECT NUMBER : STPG MARK(310)	
SHEET 1 OF 18 SHEETS	

QUANTITY SHEET 1

SUMMARY OF ESTIMATED QUANTITIES										TOTALS			DESCRIPTIONS				DETAILED SUMMARY OF QUANTITIES		
									ROADWAY	GRAND TOTAL	FINAL	UNIT	ITEMS	ITEM NUMBER	ROUND	QUANTITIES	UNIT	ITEMS	
									1200	1200		HR	TRUCK-MOUNTED ATTENUATOR, AWW/PV	608.50	EST.				
									1	1		LS	MOBILIZATION/DEMOBILIZATION	635.11	--				
									1	1		LS	TRAFFIC CONTROL	641.10	--				
									11500000	11500000		LF	4 INCH WHITE LINE, WATERBORNE PAINT	646.201	EST.				
									20500000	20500000		LF	4 INCH YELLOW LINE, WATERBORNE PAINT	646.2111	EST.				
									124000	124000		LF	6 INCH WHITE LINE, WATERBORNE PAINT	646.2141	EST.				
									110000	110000		LF	6 INCH YELLOW LINE, WATERBORNE PAINT	646.2151	EST.				
									1800	1800		LF	12 INCH WHITE LINE, WATERBORNE PAINT	646.241	EST.				
									3500	3500		DL	SPECIAL PROVISION (UNIFORMED TRAFFIC OFFICERS) (N.A.B.I.)	900.615	EST.				

PROJECT NAME:	STATEWIDE NORTHEAST REGION
PROJECT NUMBER:	STPG MARK(310)
FILE NAME: +17+062frm.dgn	PLOT DATE: 2/13/2018
PROJECT LEADER: P. COBURN	DRAWN BY: M. BOGACZYK
DESIGNED BY: M. BOGACZYK	CHECKED BY: P. COBURN
QUANTITY SHEET	SHEET 2 OF 18

TRAFFIC CONTROL PLAN

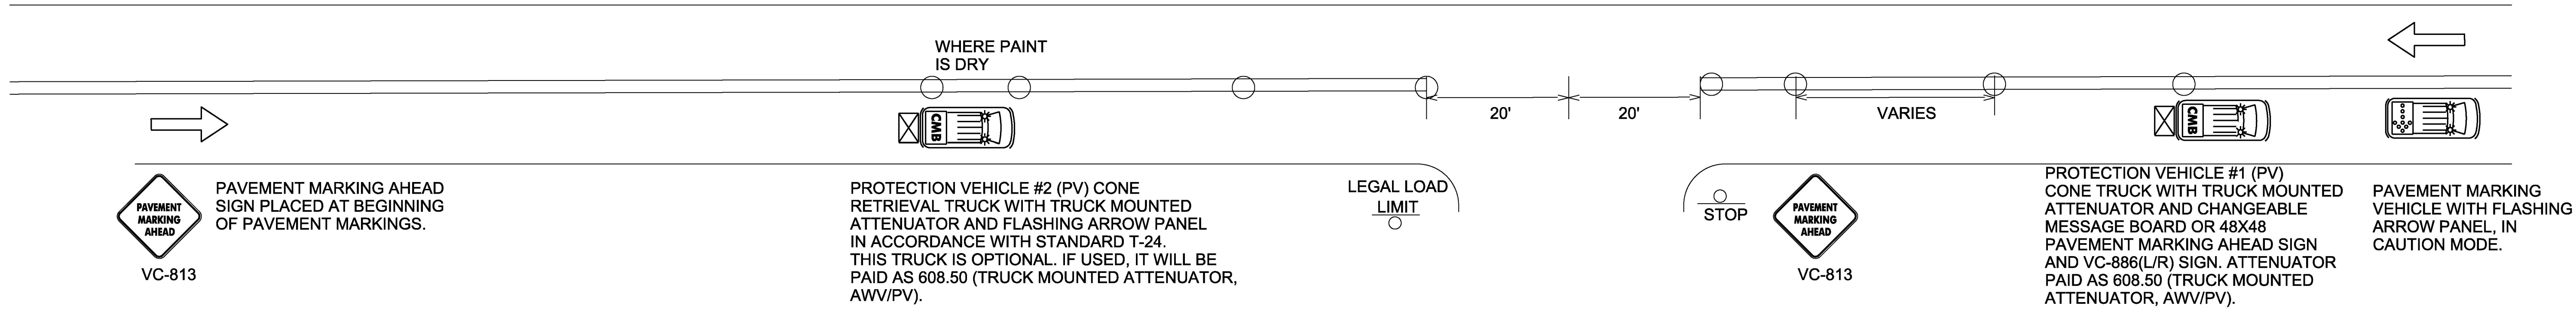

NOTES






1. ALL WORK VEHICLES USED SHALL DISPLAY HIGH-INTENSITY ROTATING, FLASHING, OSCILLATING OR STROBE LIGHTS.
2. ALL PROTECTION VEHICLES SHALL BE EQUIPPED WITH A TRUCK MOUNTED ATTENUATOR WITH A VC-866(L/R) SIGN IN ACCORDANCE WITH STANDARD T-29 ATTACHED AND A FLASHING ARROW PANEL IN ACCORDANCE WITH STANDARD T-24. PAYMENT WILL BE MADE UNDER ITEM 608.50 (TRUCK MOUNTED ATTENUATOR, AWW/PV).
3. FLASHING ARROW PANELS MOUNTED TO VEHICLES WILL NOT BE PAID FOR DIRECTLY, BUT WILL BE CONSIDERED INCIDENTAL TO ITEM 641.10 (TRAFFIC CONTROL). FLASHING ARROW PANELS SHALL BE USED IN CAUTION MODE WHEN VEHICLE IS IN TRAVEL LANE.
4. PROTECTION VEHICLE #1 SHALL TRAVEL AT A VARYING DISTANCE FROM PAVEMENT MARKING VEHICLE WHILE SETTING CONES ON THE WET PAINT TO ENSURE ADEQUATE SIGHT DISTANCE FOR TRAFFIC APPROACHING FROM THE REAR.
5. THE NUMBER OF CHANNELIZING DEVICES AND OTHER TRAFFIC CONTROL DEVICES SHOWN ON THIS SHEET ARE FOR ILLUSTRATIVE PURPOSES ONLY. THE ACTUAL NUMBER REQUIRED IS TO BE DETERMINED BY THE CONTRACTOR IN ACCORDANCE WITH THE MUTCD AND STANDARD T-24 BASED ON FIELD CONDITIONS OR AS DIRECTED BY THE ENGINEER.
6. CONE VEHICLES SHALL HAVE PROTECTIVE CAGES TO PROTECT THE PERSON PLACING AND RETRIEVING CONES.
7. PAVEMENT MARKING AHEAD SIGNS IN ACCORDANCE WITH STANDARD T-28 SHALL BE PLACED AT THE BEGINNING OF PAVEMENT MARKING OPERATION AND AT A MINIMUM OF EVERY THREE MILES. THEY SHALL ALSO BE PLACED AFTER EVERY NUMBERED STATE HIGHWAY OR MAJOR INTERSECTION INCLUDING COMMERCIAL DRIVES.
8. WORK VEHICLES SHALL PULL OVER TO ALLOW VEHICLES TO PASS AT REASONABLE INTERVALS TO AVOID EXCESSIVE QUEUING AND DELAYS.
9. CONE PICK-UP MAY BE ACCOMPLISHED USING DEDICATED VEHICLE (PV#2) OR BY PROTECTION VEHICLE #1 WHEN PAINT TRUCK IS NOT OPERATING AND PAINT IS DRY. QUANTITY OF 608.50 (TRUCK MOUNTED ATTENUATOR, AWW/PV) SHALL BE MEASURED AS THE NUMBER OF VEHICLE HOURS USED.
10. CONES SHALL BE LEFT IN PLACE UNTIL PAINT IS DRY AND NOT TRACKING.
11. ALL TRAFFIC CONTROL ITEMS WILL BE PAID UNDER PAY ITEM 641.10 UNLESS OTHERWISE SPECIFIED.

LEGEND

- INDICATES TRAFFIC FLOW
- FLASHING ARROW PANEL
- TRUCK MOUNTED ATTENUATOR
- CHANGEABLE MESSAGE BOARD
- 28" RETROREFLECTORIZED CONE
- MARKING OPERATIONS VEHICLE

PROJECT NAME: STATEWIDE NORTHEAST REGION	
PROJECT NUMBER: STPG MARK(310)	
FILE NAME: t17+062frm.dgn	PLOT DATE: 2/13/2018
PROJECT LEADER: P. COBURN	DRAWN BY: M. BOGACZYK
DESIGNED BY: M. BOGACZYK	CHECKED BY: P. COBURN
TRAFFIC CONTROL PLAN	SHEET 3 OF 18


NOT TO SCALE

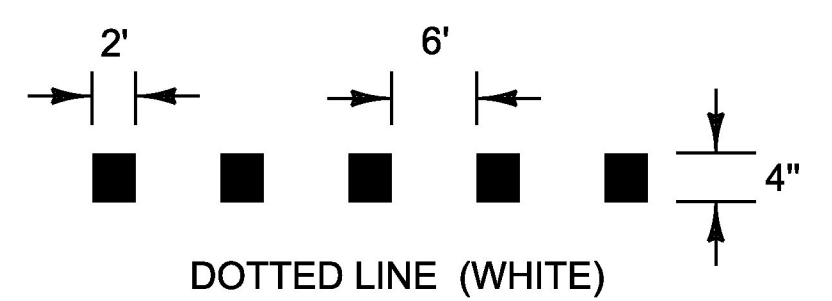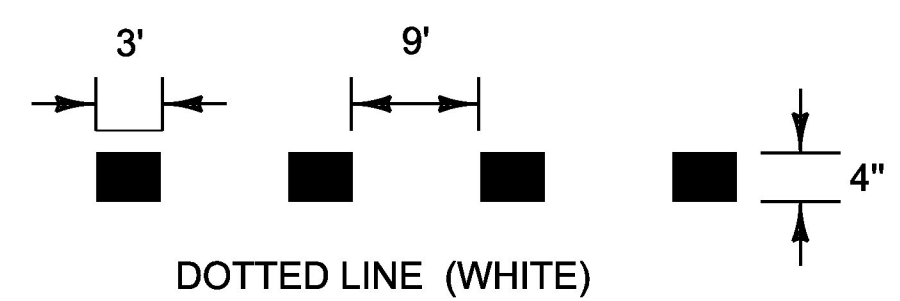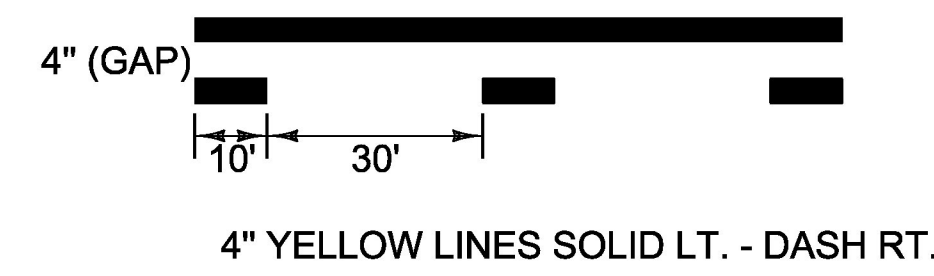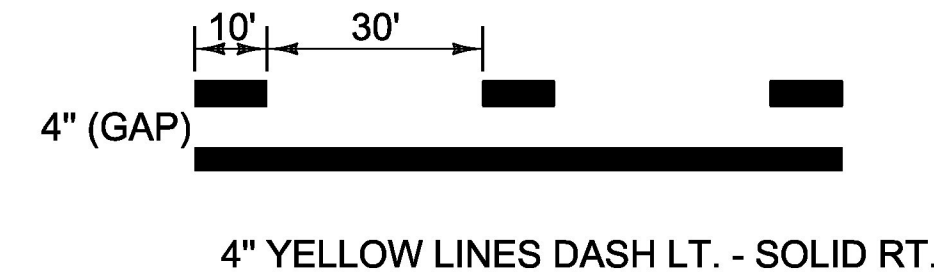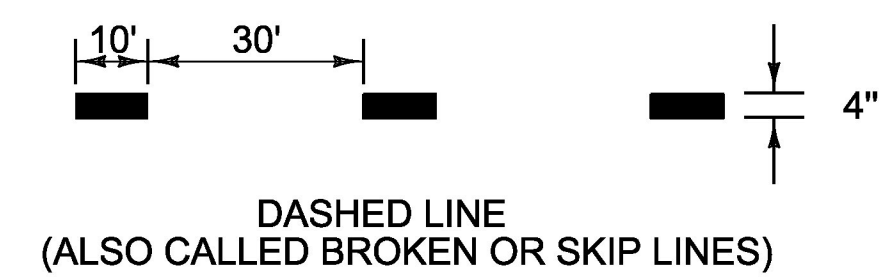

PAVEMENT MARKING LINE DETAILS

NOTES:

1. ALL MARKINGS SHALL BE APPLIED TO MATCH EXISTING OR AS DIRECTED BY THE ENGINEER.
2. IN AREAS THAT HAVE SIX INCH MARKINGS THERE SHALL BE A SIX INCH GAP BETWEEN LINES WITH A SIX INCH LINE WIDTH. MARKINGS SHOULD MATCH EXISTING.

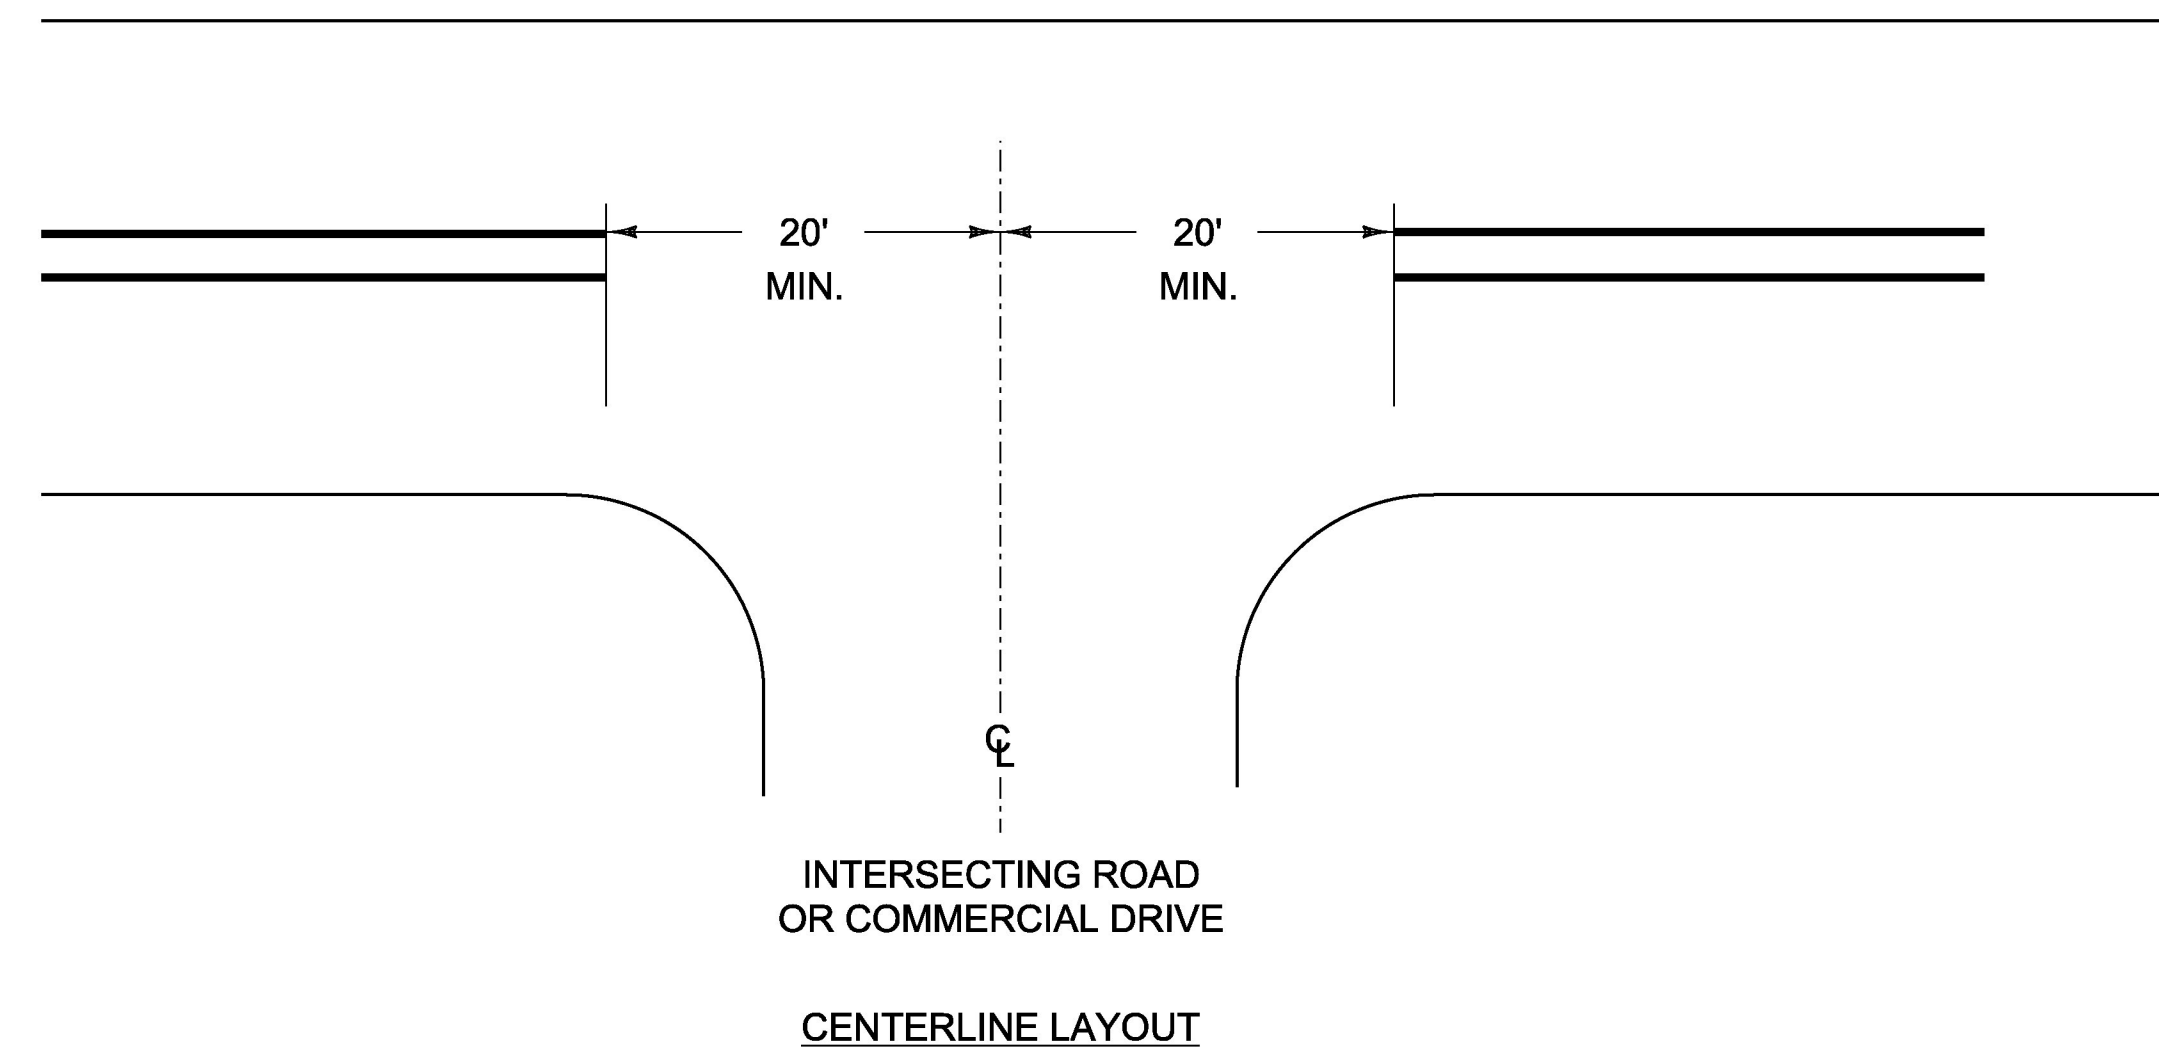


CENTERLINE BREAKS:

1. AT ALL STATE HIGHWAYS, TOWN HIGHWAYS THAT HAVE STOP OR YIELD SIGNS INSTALLED.
2. COMMERCIAL DRIVES:
 - A. WHERE A SEPARATE TURN LANE EXISTS ON THE MAIN LINE (LT. OR RT.).
 - B. WHERE SIGNIFICANT TRAFFIC VOLUMES EXIST.

GENERAL NOTES:

1. ALL ROADS LISTED IN THE PLANS SHALL BE MARKED WITH A COMPLETE APPLICATION OF MARKINGS AS SPECIFIED IN THE CONTRACT DOCUMENTS ONCE IN THE 2018 CONSTRUCTION SEASON AND ONCE IN THE 2019 CONSTRUCTION SEASON, UNLESS OTHERWISE DIRECTED BY THE ENGINEER.
2. NATIONAL HIGHWAY SYSTEM AND STATE HIGHWAY SYSTEM ROADS SHALL BE MARKED WITH YELLOW CENTERLINE AND WHITE EDGE LINE AND LANE LINES TO MATCH EXISTING. CLASS 1 AND CLASS 2 TOWN HIGHWAYS SHALL BE MARKED WITH YELLOW CENTERLINE ONLY.
3. ROADS THAT ARE SCHEDULED FOR REPAIR OR ARE PART OF AN ACTIVE CONSTRUCTION PROJECT SHALL BE EXCLUDED AT THE DIRECTION OF THE ENGINEER. ANY MARKINGS DEEMED BY THE ENGINEER TO NOT REQUIRE REPAINTING SHALL BE EXCLUDED FROM THE PROJECT.
4. THE TOTAL QUANTITY MEASURED FOR PAYMENT WILL BE THE ACTUAL QUANTITY MARKED AS DIRECTED BY THE ENGINEER.
5. THE CONTRACTOR SHALL COORDINATE WITH VTRANS TO SCHEDULE MARKING ON ALL ROADS THAT ARE SCHEDULED FOR REPAIRS OR RETREATMENT.
6. LANES TO BE PAINTED ON BOTH SIDES SHALL BE MARKED IN MULTIPLE PASSES SUCH THAT TRAFFIC DOES NOT TRAVEL BETWEEN WET PAINT AT ANY TIME. PAINT SHALL BE ALLOWED TO FULLY DRY BEFORE ANY SUBSEQUENT MARKINGS ARE APPLIED.
7. TOWN HIGHWAY MAPS ARE AVAILABLE FOR REFERENCE FROM THE VTRANS WEBSITE.
8. MARKINGS SHALL MATCH EXISTING, OR AS DIRECTED BY THE ENGINEER. THE PLANS INDICATE SIX INCH MARKINGS BASED ON BEST AVAILABLE INFORMATION. ROUNDABOUTS AND OTHER LOCATIONS MAY ALSO HAVE SIX INCH MARKINGS AND SHALL BE MARKED TO MATCH EXISTING. PAYMENT WILL BE FOR THE ACTUAL QUANTITY APPLIED OF EACH MARKING AS DIRECTED BY THE ENGINEER.
9. LONGITUDINAL 12 INCH WHITE LINES, EXCLUDING DIAGONAL GORE MARKINGS, SHALL BE MARKED AND MATCH EXISTING, OR AS DIRECTED BY THE ENGINEER.
10. SIDE ROAD RADII SHALL BE MARKED IN ACCORDANCE WITH STD. E-193.
11. ROUTES NOTED AS NIGHT WORK IN THE PLANS ARE REQUIRED TO BE MARKED AT NIGHT. THE CONTRACTOR MAY PROPOSE OTHER ROUTES TO BE MARKED AT NIGHT SUBJECT TO APPROVAL BY THE ENGINEER.

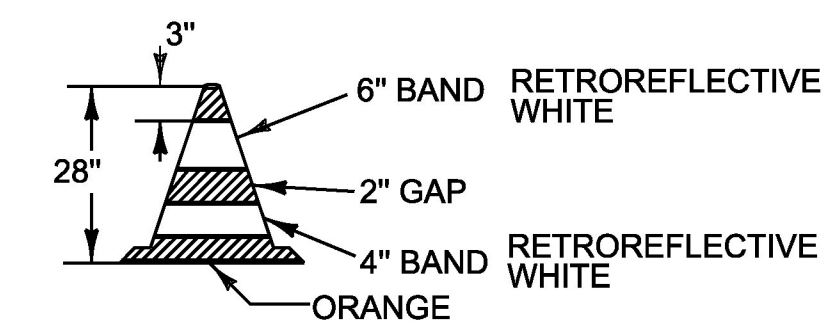

28" RETROREFLECTORIZED CONE

NOTES:

1. 28" RETROREFLECTORIZED CONES SHALL BE USED ON ALL ROADWAYS.
2. CONES MAY BE WEIGHTED TO PREVENT OVER-TURNING, HOWEVER THE WEIGHTS SHALL NOT PRESENT A HAZARD IF THE CONE IS STRUCK.

PROJECT NAME:	STATEWIDE NORTHEAST REGION
PROJECT NUMBER:	STPG MARK(310)
FILE NAME: +17+062frm.dgn	PLOT DATE: 2/13/2018
PROJECT LEADER: P. COBURN	DRAWN BY: M. BOGACZYK
DESIGNED BY: M. BOGACZYK	CHECKED BY: P. COBURN
MISCELLANEOUS DETAILS SHEET	SHEET 4 OF 18

NOT TO SCALE

SUMMARY BY ROUTE OF STATE HIGHWAYS AND CLASS 1 TOWN HIGHWAYS

COUNTY	TOWN NAME	ROUTE NAME	HIGHWAY SIGN	SEGMENT LENGTH (MI)	SEGMENT LENGTH (LF)	COMMENTS
CALEDONIA COUNTY	ST. JOHNSBURY	TH-3	ALT-5	1.175	6204.00	
CALEDONIA COUNTY	ST. JOHNSBURY	US-ALT5	US-ALT5	0.107	564.96	
CALEDONIA COUNTY	ST. JOHNSBURY	TH-3	ALT-5	0.038	200.64	
ORLEANS COUNTY	NEWPORT CITY	TH-5	ALT-5	1.283	6774.24	
ORLEANS COUNTY	DERBY	TH-1	ALT-5	0.604	3189.12	
			ALT-5 TOTAL	3.207	16932.96	
CALEDONIA COUNTY	LYNDON	TH-2	ALT-122	0.353	1863.84	
CALEDONIA COUNTY	LYNDON	TH-8	ALT-122	0.689	3637.92	
			ALT-122 TOTAL	1.042	5501.76	
CALEDONIA COUNTY	BARNET	NSH-BSH	BARNET STATE HIGHWAY	0.806	4255.68	FROM PARKING LOT TO INTERSECTION OF US-5
			BARNET STATE HIGHWAY TOTAL	0.806	4255.68	
WASHINGTON COUNTY	BERLIN	NSH-BSH	BERLIN STATE HIGHWAY	1.642	8669.76	
WASHINGTON COUNTY	BERLIN	NSH-BSH	BERLIN STATE HIGHWAY	0.638	3368.64	BEGINS AT KNAPP STATE AIRPORT, HEADS TOWARDS THE INTERSECTION OF VT-62, THEN HEADS DOWN THEN HILL TOWARDS US-302 AT THE VTRANS TRAINING CENTER
WASHINGTON COUNTY	BERLIN	NSH-BSH	BERLIN STATE HIGHWAY	0.454	2397.12	
WASHINGTON COUNTY	BERLIN	NSH-BSH	BERLIN STATE HIGHWAY	0.074	390.72	
			BERLIN STATE HIGHWAY TOTAL	2.808	14826.24	
ORLEANS COUNTY	COVENTRY	NSH-CSH	COVENTRY STATE HIGHWAY	2.543	13427.04	BEGINS AT NEWPORT AIRPORT AND HEADS NORTH JUST OVER NEWPORT CITY BORDER
ORLEANS COUNTY	NEWPORT CITY	TH-7	COVENTRY STATE HIGHWAY	0.087	459.36	
			COVENTRY STATE HIGHWAY TOTAL	2.630	13886.40	
ORANGE COUNTY	FAIRLEE	NSH-FSH	FAIRLEE STATE HIGHWAY	0.197	1040.16	BEGINS AT INTERSTATE TO INTERSECTION OF US-5
			FAIRLEE STATE HIGHWAY TOTAL	0.197	1040.16	
ESSEX COUNTY	MAIDSTONE	NSH-MSH	MAIDSTONE STATE HIGHWAY	0.602	3178.56	BEGINS AT INTERSECTION OF VT-102 AND ENDS AT NH BORDER, LAMOUREUX ROAD
			MAIDSTONE STATE HIGHWAY TOTAL	0.602	3178.56	
ORANGE COUNTY	NEWBURY	NSH-NSH	NEWBURY STATE HIGHWAY	0.482	2544.96	BEGINS AT INTERSECTION OF US-5 AND ENDS AT NH BORDER, NEWBURY CROSSING ROAD
			NEWBURY STATE HIGHWAY TOTAL	0.482	2544.96	
ESSEX COUNTY	NORTON	NSH-NSH	NORTON STATE HIGHWAY	0.037	195.36	LAKE VIEW ROAD
			NORTON STATE HIGHWAY TOTAL	0.037	195.36	
CALEDONIA COUNTY	ST. JOHNSBURY	NSH-SJSH	ST. JOHNSBURY STATE HIGHWAY	1.019	5380.32	BEGINS AT I-91 EXIT 22 AND ENDS AT INTERSECTION OF US-5
			ST. JOHNSBURY STATE HIGHWAY TOTAL	1.019	5380.32	

COUNTY	TOWN NAME	ROUTE NAME	HIGHWAY SIGN	SEGMENT LENGTH (MI)	SEGMENT LENGTH (LF)	COMMENTS
WASHINGTON COUNTY	BERLIN	US-2	US-2	1.382	7296.96	PRIORITIZED WORK, NHS
WASHINGTON COUNTY	BARRE TOWN	US-2	US-2	0.085	448.80	PRIORITIZED WORK, NHS
WASHINGTON COUNTY	EAST MONTEPELIER	US-2	US-2	4.924	25998.72	PRIORITIZED WORK, NHS
WASHINGTON COUNTY	PLAINFIELD	US-2	US-2	1.486	7846.08	PRIORITIZED WORK, NHS
WASHINGTON COUNTY	MARSHFIELD	US-2	US-2	8.205	43322.40	NHS
WASHINGTON COUNTY	CABOT	US-2	US-2	6.210	32788.80	NHS
CALEDONIA COUNTY	DANVILLE	US-2	US-2	9.059	47831.52	NHS
CALEDONIA COUNTY	ST. JOHNSBURY	TH-2	US-2	1.767	9329.76	NHS
CALEDONIA COUNTY	ST. JOHNSBURY	TH-2	US-2	0.227	1198.56	NHS
CALEDONIA COUNTY	ST. JOHNSBURY	TH-2	US-2	0.225	1188.00	NHS
CALEDONIA COUNTY	ST. JOHNSBURY	US-2	US-2	1.866	9852.48	NHS
CALEDONIA COUNTY	ST. JOHNSBURY	US-2	US-2	1.394	7360.32	NHS
CALEDONIA COUNTY	ST. JOHNSBURY	US-2	US-2	1.394	7360.32	NHS
CALEDONIA COUNTY	ST. JOHNSBURY	US-2	US-2	3.029	15993.12	NHS
CALEDONIA COUNTY	ST. JOHNSBURY	US-2	US-2	0.376	1985.28	NHS
CALEDONIA COUNTY	KIRBY	US-2	US-2	0.967	5105.76	NHS
ESSEX COUNTY	CONCORD	US-2	US-2	10.765	56839.20	NHS
ESSEX COUNTY	LUNENBURG	US-2	US-2	9.039	47725.92	NHS
ESSEX COUNTY	GUILDHALL	US-2	US-2	1.149	6066.72	NHS
			US-2 TOTAL	63.549	335538.72	
ORANGE COUNTY	FAIRLEE	US-5	US-5	7.278	38427.84	PRIORITIZED WORK
ORANGE COUNTY	BRADFORD	US-5	US-5	5.471	28886.88	PRIORITIZED WORK, BIKE LANES
ORANGE COUNTY	BRADFORD	US-5	US-5	0.365	1927.20	PRIORITIZED WORK, DIVIDED
ORANGE COUNTY	BRADFORD	US-5	US-5	0.388	2048.64	PRIORITIZED WORK, DIVIDED
ORANGE COUNTY	BRADFORD	US-5	US-5	0.077	406.56	PRIORITIZED WORK, DIVIDED
ORANGE COUNTY	BRADFORD	US-5	US-5	0.064	337.92	PRIORITIZED WORK, DIVIDED
ORANGE COUNTY	NEWBURY	US-5	US-5	9.822	51860.16	PRIORITIZED WORK
CALEDONIA COUNTY	RYEGATE	US-5	US-5	7.386	38998.08	PRIORITIZED WORK
CALEDONIA COUNTY	BARNET	US-5	US-5	9.939	52477.92	PRIORITIZED WORK
CALEDONIA COUNTY	WATERFORD	US-5	US-5	1.091	5760.48	PRIORITIZED WORK
CALEDONIA COUNTY	ST. JOHNSBURY	US-5	US-5	5.285	27904.80	PRIORITIZED WORK, NIGHT WORK
CALEDONIA COUNTY	ST. JOHNSBURY	TH-1	US-5	0.068	359.04	PRIORITIZED WORK, NIGHT WORK, DIVIDED
CALEDONIA COUNTY	ST. JOHNSBURY	TH-1	US-5	0.068	359.04	PRIORITIZED WORK, NIGHT WORK, DIVIDED
CALEDONIA COUNTY	ST. JOHNSBURY	US-5	US-5	0.854	4509.12	PRIORITIZED WORK, NIGHT WORK, DIVIDED
CALEDONIA COUNTY	ST. JOHNSBURY	US-5	US-5	0.879	4641.12	PRIORITIZED WORK, NIGHT WORK
CALEDONIA COUNTY	ST. JOHNSBURY	TH-1	US-5	1.468	7751.04	PRIORITIZED WORK, NIGHT WORK
CALEDONIA COUNTY	LYNDON	TH-1	US-5	0.984	5195.52	PRIORITIZED WORK, NIGHT WORK
CALEDONIA COUNTY	LYNDON	US-5	US-5	6.028	31827.84	PRIORITIZED WORK, NIGHT WORK
CALEDONIA COUNTY	BURKE	US-5	US-5	4.32	22809.60	
CALEDONIA COUNTY	SUTTON	US-5	US-5	7.329	38697.12	
ORLEANS COUNTY	BARTON	TH-1	US-5	1.114	5881.92	
ORLEANS COUNTY	BARTON	US-5	US-5	9.363	49436.64	
ORLEANS COUNTY	BARTON	US-5	US-5	0.306	1615.68	
ORLEANS COUNTY	BARTON	US-5	US-5	0.298	1573.44	DIVIDED
ORLEANS COUNTY	IRASBURG	US-5	US-5	4.404	23253.12	
ORLEANS COUNTY	IRASBURG	US-5	US-5	0.358	1890.24	
ORLEANS COUNTY	IRASBURG	US-5	US-5	0.358	1890.24	DIVIDED
ORLEANS COUNTY	COVENTRY	US-5	US-5	4.892	25829.76	
ORLEANS COUNTY	NEWPORT CITY	TH-1	US-5	3.88	20486.40	PRIORITIZED WORK, NIGHT WORK
ORLEANS COUNTY	DERBY	TH-1	US-5	0.819	4324.32	PRIORITIZED WORK
ORLEANS COUNTY	DERBY	US-5	US-5	4.678	24699.84	PRIORITIZED WORK
ORLEANS COUNTY	DERBY	US-5	US-5	0.44	2323.20	
ORLEANS COUNTY	DERBY	US-5	US-5	0.473	2497.44	PRIORITIZED WORK, DIVIDED
			US-5 TOTAL	100.547	530888.16	

NSH = NAMED STATE HIGHWAY
 NHS = NATIONAL HIGHWAY SYSTEM.

SIX INCH = ROUTES THAT SHOULD BE MARKED AS SIX INCH LINES. THESE ARE ESTIMATED ROUTES. MARKINGS SHALL MATCH EXISTING OR AS DIRECTED BY THE ENGINEER.

NIGHT WORK = AREAS THAT ARE DESIGNATED FOR NIGHT WORK.
 DIVIDED = AREAS THAT HAVE DIVIDED SEGMENTS. EACH SEGMENT IS MEASURED IN ONE DIRECTION.

ROUNDAABOUT = ROUTES THAT HAVE ROUNDAABOUTS.

SEGMENT LENGTH IS PROVIDED FOR INFORMATIONAL PURPOSES ONLY. THESE LENGTHS REPRESENT ROAD CENTERLINE LENGTH AND SHALL NOT BE USED FOR MEASURING QUANTITIES FOR PAYMENT.

PROJECT NAME: STATEWIDE NORTHEAST REGION
 PROJECT NUMBER: STPG MARK(310)

FILE NAME: i17+062roadl1st.dgn PLOT DATE: 2/13/2018
 PROJECT LEADER: P. COBURN DRAWN BY: M. BOGACZYK
 DESIGNED BY: M. BOGACZYK CHECKED BY: P. COBURN
 ROAD QUANTITY SHEET 1 SHEET 5 OF 18

SUMMARY BY ROUTE OF STATE HIGHWAYS AND CLASS 1 TOWN HIGHWAYS

COUNTY	TOWN NAME	ROUTE NAME	HIGHWAY SIGN	SEGMENT LENGTH (MI)	SEGMENT LENGTH (LF)	COMMENTS
WASHINGTON COUNTY	BERLIN	US-302	US-302	1.895	10005.60	PRIORITIZED WORK, NIGHT WORK, BIKE LANES
WASHINGTON COUNTY	BARRE CITY	TH-1	US-302	3.359	17735.52	PRIORITIZED WORK, NIGHT WORK
WASHINGTON COUNTY	BARRE TOWN	US-302	US-302	3.424	18078.72	PRIORITIZED WORK, ROUNDABOUT
ORANGE COUNTY	ORANGE	US-302	US-302	6.268	33095.04	
ORANGE COUNTY	TOPSHAM	US-302	US-302	3.397	17936.16	
CALEDONIA COUNTY	GROTON	US-302	US-302	7.904	41733.12	
CALEDONIA COUNTY	RYEGATE	US-302	US-302	3.698	19525.44	
ORANGE COUNTY	NEWBURY	US-302	US-302	4.542	23981.76	
ORANGE COUNTY	NEWBURY	US-302	US-302	0.375	1980	
ORANGE COUNTY	NEWBURY	US-302	US-302	0.375	1980	DIVIDED
			US-302 TOTAL	35.237	186051.36	
CALEDONIA COUNTY	DANVILLE	VT-2B	VT-2B	1.916	10116.48	
CALEDONIA COUNTY	ST. JOHNSBURY	VT-2B	VT-2B	1.543	8147.04	
			VT-2B TOTAL	3.459	18263.52	
CALEDONIA COUNTY	BURKE	VT-5A	VT-5A	0.657	3468.96	
CALEDONIA COUNTY	SUTTON	VT-5A	VT-5A	3.204	16917.12	
CALEDONIA COUNTY	NEWARK	VT-5A	VT-5A	0.852	4498.56	
ORLEANS COUNTY	WESTMORE	VT-5A	VT-5A	7.222	38132.16	
ORLEANS COUNTY	BROWNINGTON	VT-5A	VT-5A	3.712	19599.36	
ORLEANS COUNTY	CHARLESTON	VT-5A	VT-5A	3.850	20328.00	
ORLEANS COUNTY	CHARLESTON	VT-5A	VT-5A	0.030	158.40	
			VT-5A TOTAL	19.527	103102.56	
WASHINGTON COUNTY	BERLIN	VT-12	VT-12	6.690	35323.20	
			VT-12 TOTAL	6.690	35323.20	
WASHINGTON COUNTY	BARRE TOWN	VT-14	VT-14	4.033	21294.24	PRIORITIZED WORK
WASHINGTON COUNTY	BARRE CITY	TH-2	VT-14	1.193	6299.04	PRIORITIZED WORK
WASHINGTON COUNTY	BARRE CITY	TH-3	VT-14	0.905	4778.40	PRIORITIZED WORK
WASHINGTON COUNTY	BARRE CITY	TH-2	VT-14	0.074	390.72	PRIORITIZED WORK
WASHINGTON COUNTY	BARRE CITY	TH-2	VT-14	0.074	390.72	PRIORITIZED WORK
WASHINGTON COUNTY	EAST MONTPELIER	VT-14	VT-14	5.778	30507.84	
WASHINGTON COUNTY	CALAIS	VT-14	VT-14	6.902	36442.56	
WASHINGTON COUNTY	WOODBURY	VT-14	VT-14	7.691	40608.48	
CALEDONIA COUNTY	HARDWICK	TH-2	VT-14	0.514	2713.92	
CALEDONIA COUNTY	HARDWICK	VT-14	VT-14	5.514	29113.92	
ORLEANS COUNTY	GREENSBORO	VT-14	VT-14	1.903	10047.84	
ORLEANS COUNTY	CRAFTSBURY	VT-14	VT-14	7.962	42039.36	
ORLEANS COUNTY	ALBANY	VT-14	VT-14	6.722	35492.16	
ORLEANS COUNTY	IRASBURG	VT-14	VT-14	7.350	38808.00	
ORLEANS COUNTY	COVENTRY	VT-14	VT-14	4.252	22450.56	
ORLEANS COUNTY	COVENTRY	VT-14	VT-14	0.088	464.64	
ORLEANS COUNTY	NEWPORT TOWN	VT-14	VT-14	0.492	2597.76	
			VT-14 TOTAL	61.447	324440.16	
CALEDONIA COUNTY	HARDWICK	TH-1	VT-15	0.986	5206.08	
CALEDONIA COUNTY	HARDWICK	VT-15	VT-15	6.212	32799.36	
CALEDONIA COUNTY	WALDEN	VT-15	VT-15	7.164	37825.92	
CALEDONIA COUNTY	DANVILLE	VT-15	VT-15	1.837	9699.36	
			VT-15 TOTAL	16.199	85530.72	
CALEDONIA COUNTY	HARDWICK	VT-16	VT-16	4.420	23337.60	
ORLEANS COUNTY	GREENSBORO	VT-16	VT-16	5.790	30571.20	
CALEDONIA COUNTY	WHEELLOCK	VT-16	VT-16	1.261	6658.08	
ORLEANS COUNTY	GLOVER	VT-16	VT-16	6.700	35376.00	
ORLEANS COUNTY	BARTON	VT-16	VT-16	1.429	7545.12	
ORLEANS COUNTY	BARTON	VT-16	VT-16	0.310	1636.80	
ORLEANS COUNTY	BARTON	VT-16	VT-16	0.352	1858.56	
ORLEANS COUNTY	BARTON	TH-2	VT-16	0.630	3326.40	
ORLEANS COUNTY	BARTON	TH-2	VT-16	0.033	174.24	
			VT-16 TOTAL	20.925	110484.00	

COUNTY	TOWN NAME	ROUTE NAME	HIGHWAY SIGN	SEGMENT LENGTH (MI)	SEGMENT LENGTH (LF)	COMMENTS
CALEDONIA COUNTY	WATERFORD	VT-18	VT-18	7.622	40244.16	
CALEDONIA COUNTY	ST. JOHNSBURY	VT-18	VT-18	0.265	1399.20	NHS
			VT-18 TOTAL	7.887	41643.36	
ORANGE COUNTY	BRADFORD	VT-25	VT-25	6.462	34119.36	
ORANGE COUNTY	BRADFORD	VT-25	VT-25	0.570	3009.60	DIVIDED
ORANGE COUNTY	BRADFORD	VT-25	VT-25	0.496	2618.88	
ORANGE COUNTY	CORINTH	VT-25	VT-25	3.963	20924.64	
ORANGE COUNTY	TOPSHAM	VT-25	VT-25	6.438	33992.64	
ORANGE COUNTY	ORANGE	VT-25	VT-25	0.306	1615.68	
			VT-25 TOTAL	18.235	96280.80	
ORANGE COUNTY	FAIRLEE	VT-25A	VT-25A	0.088	464.64	
			VT-25A TOTAL	0.088	464.64	
ORANGE COUNTY	BRADFORD	VT-25B	VT-25B	0.981	5179.68	
			VT-25B TOTAL	0.981	5179.68	
ESSEX COUNTY	LEMINGTON	VT-26	VT-26	0.013	68.64	
			VT-26 TOTAL	0.013	68.64	
ORLEANS COUNTY	LOWELL	VT-58	VT-58	5.096	26906.88	
ORLEANS COUNTY	IRASBURG	VT-58	VT-58	6.547	34568.16	
ORLEANS COUNTY	BARTON	TH-1	VT-58	0.558	2946.24	
ORLEANS COUNTY	BARTON	VT-58	VT-58	0.179	945.12	DIVIDED
ORLEANS COUNTY	BARTON	VT-58	VT-58	0.179	945.12	
ORLEANS COUNTY	BARTON	VT-58	VT-58	2.956	15607.68	
ORLEANS COUNTY	BROWNINGTON	VT-58	VT-58	3.315	17503.20	
ORLEANS COUNTY	BROWNINGTON	VT-58	VT-58	0.047	248.16	RAMP
			VT-58 TOTAL	18.877	99670.56	
WASHINGTON COUNTY	BERLIN	VT-62	VT-62	0.852	4498.56	
WASHINGTON COUNTY	BERLIN	VT-62	VT-62	0.852	4498.56	PRIORITIZED WORK, DIVIDED
WASHINGTON COUNTY	BERLIN	VT-62	VT-62	2.082	10992.96	PRIORITIZED WORK
WASHINGTON COUNTY	BARRE CITY	VT-62	VT-62	1.585	8368.80	PRIORITIZED WORK, DIVIDED
WASHINGTON COUNTY	BARRE CITY	VT-62	VT-62	1.585	8368.80	
			VT-62 TOTAL	6.956	36727.68	
WASHINGTON COUNTY	BERLIN	VT-63	VT-63	0.737	3891.36	
WASHINGTON COUNTY	BERLIN	VT-63	VT-63	0.254	1341.12	DIVIDED
WASHINGTON COUNTY	BERLIN	VT-63	VT-63	0.254	1341.12	
WASHINGTON COUNTY	BARRE TOWN	VT-63	VT-63	2.647	13976.16	
WASHINGTON COUNTY	BARRE TOWN	VT-63	VT-63	0.263	1388.64	DIVIDED
WASHINGTON COUNTY	BARRE TOWN	VT-63	VT-63	0.263	1388.64	
			VT-63 TOTAL	4.418	23327.04	
ORLEANS COUNTY	LOWELL	VT-100	VT-100	7.031	37123.68	
ORLEANS COUNTY	WESTFIELD	VT-100	VT-100	4.942	26093.76	
ORLEANS COUNTY	TROY	VT-100	VT-100	3.122	16484.16	
ORLEANS COUNTY	NEWPORT TOWN	VT-100	VT-100	4.133	21822.24	
			VT-100 TOTAL	19.228	101523.84	
ORLEANS COUNTY	TROY	VT-101	VT-101	4.333	22878.24	
ORLEANS COUNTY	TROY	VT-101	VT-101	0.046	242.88	RAMP
			VT-101 TOTAL	4.379	23121.12	

NSH = NAMED STATE HIGHWAY
 NHS = NATIONAL HIGHWAY SYSTEM.

SIX INCH = ROUTES THAT SHOULD BE MARKED AS SIX INCH LINES. THESE ARE ESTIMATED ROUTES. MARKINGS SHALL MATCH EXISTING OR AS DIRECTED BY THE ENGINEER.

NIGHT WORK = AREAS THAT ARE DESIGNATED FOR NIGHT WORK.
 DIVIDED = AREAS THAT HAVE DIVIDED SEGMENTS. EACH SEGMENT IS MEASURED IN ONE DIRECTION.

ROUNDABOUT = ROUTES THAT HAVE ROUNDABOUTS.

SEGMENT LENGTH IS PROVIDED FOR INFORMATIONAL PURPOSES ONLY. THESE LENGTHS REPRESENT ROAD CENTERLINE LENGTH AND SHALL NOT BE USED FOR MEASURING QUANTITIES FOR PAYMENT.

PROJECT NAME: STATEWIDE NORTHEAST REGION
 PROJECT NUMBER: STPG MARK(310)

FILE NAME: i17+062roadl1st.dgn PLOT DATE: 2/13/2018
 PROJECT LEADER: P. COBURN DRAWN BY: M. BOGACZYK
 DESIGNED BY: M. BOGACZYK CHECKED BY: P. COBURN
 ROAD QUANTITY SHEET 2 SHEET 6 OF 18

SUMMARY BY ROUTE OF STATE HIGHWAYS AND CLASS 1 TOWN HIGHWAYS

COUNTY	TOWN NAME	ROUTE NAME	HIGHWAY SIGN	SEGMENT LENGTH (MI)	SEGMENT LENGTH (LF)	COMMENTS
ESSEX COUNTY	GUILDHALL	VT-102	VT-102	7.748	40909.44	
ESSEX COUNTY	MAIDSTONE	VT-102	VT-102	7.823	41305.44	
ESSEX COUNTY	BRUNSWICK	VT-102	VT-102	7.080	37382.40	
ESSEX COUNTY	BLOOMFIELD	VT-102	VT-102	6.950	36696.00	
ESSEX COUNTY	LEMINGTON	VT-102	VT-102	7.324	38670.72	
ESSEX COUNTY	CANAAN	VT-102	VT-102	6.830	36062.40	
ESSEX COUNTY	GUILDHALL	VT-102	VT-102	0.068	359.04	
			VT-102 TOTAL	43.823	231385.44	
ORLEANS COUNTY	JAY	VT-105	VT-105	8.376	44225.28	
ORLEANS COUNTY	TROY	TH-1	VT-105	0.335	1768.80	
ORLEANS COUNTY	TROY	TH-2	VT-105	0.310	1636.80	
ORLEANS COUNTY	TROY	VT-105	VT-105	5.680	29990.40	
ORLEANS COUNTY	NEWPORT TOWN	VT-105	VT-105	5.628	29715.84	
ORLEANS COUNTY	COVENTRY	VT-105	VT-105	1.117	5897.76	
ORLEANS COUNTY	NEWPORT CITY	TH-2	VT-105	1.387	7323.36	NIGHT WORK
ORLEANS COUNTY	DERBY	VT-105	VT-105	4.839	25549.92	
ORLEANS COUNTY	CHARLESTON	VT-105	VT-105	10.030	52958.40	
ESSEX COUNTY	BRIGHTON	TH-1	VT-105	1.289	6805.92	
ESSEX COUNTY	BRIGHTON	VT-105	VT-105	7.902	41722.56	
ESSEX COUNTY	FERDINAND	VT-105	VT-105	4.834	25523.52	
ESSEX COUNTY	BRUNSWICK	VT-105	VT-105	2.177	11494.56	
ESSEX COUNTY	BLOOMFIELD	VT-105	VT-105	4.262	22503.36	
			VT-105 TOTAL	58.166	307116.48	
ORANGE COUNTY	WASHINGTON	VT-110	VT-110	7.025	37092.00	
ORANGE COUNTY	ORANGE	VT-110	VT-110	1.790	9451.20	
WASHINGTON COUNTY	BARRE TOWN	VT-110	VT-110	1.083	5718.24	
WASHINGTON COUNTY	BARRE TOWN	VT-110	VT-110	0.024	126.72	ROUNDAABOUT
WASHINGTON COUNTY	BARRE TOWN	VT-110	VT-110	0.024	126.72	
			VT-110 TOTAL	9.946	52514.88	
ORLEANS COUNTY	DERBY	VT-111	VT-111	3.775	19932.00	
ORLEANS COUNTY	HOLLAND	VT-111	VT-111	0.138	728.64	
ORLEANS COUNTY	MORGAN	VT-111	VT-111	11.087	58539.36	
ESSEX COUNTY	BRIGHTON	VT-111	VT-111	0.137	723.36	
			VT-111 TOTAL	15.137	79923.36	
CALEDONIA COUNTY	LYNDON	VT-114	VT-114	4.115	21727.20	
CALEDONIA COUNTY	BURKE	VT-114	VT-114	5.013	26468.64	
ESSEX COUNTY	EAST HAVEN	VT-114	VT-114	2.220	11721.60	
CALEDONIA COUNTY	NEWARK	VT-114	VT-114	5.245	27693.60	
ESSEX COUNTY	BRIGHTON	TH-2	VT-114	0.420	2217.60	
ESSEX COUNTY	BRIGHTON	VT-114	VT-114	6.971	36806.88	
ORLEANS COUNTY	MORGAN	VT-114	VT-114	3.082	16272.96	
ESSEX COUNTY	WARREN GORE	VT-114	VT-114	4.793	25307.04	
ESSEX COUNTY	NORTON	VT-114	VT-114	9.982	52704.96	
ESSEX COUNTY	AVERILL	VT-114	VT-114	0.872	4604.16	
ESSEX COUNTY	CANAAN	VT-114	VT-114	8.358	44130.24	
			VT-114 TOTAL	51.071	269654.88	
CALEDONIA COUNTY	LYNDON	VT-122	VT-122	4.353	22983.84	
CALEDONIA COUNTY	WHELELOCK	VT-122	VT-122	1.576	8321.28	
CALEDONIA COUNTY	SHEFFIELD	VT-122	VT-122	7.727	40798.56	
ORLEANS COUNTY	GLOVER	VT-122	VT-122	1.559	8231.52	
			VT-122 TOTAL	15.215	80335.20	
ESSEX COUNTY	CANAAN	VT-141	VT-141	0.493	2603.04	
			VT-141 TOTAL	0.493	2603.04	
ESSEX COUNTY	NORTON	VT-147	VT-147	0.178	939.84	
			VT-147 TOTAL	0.178	939.84	

COUNTY	TOWN NAME	ROUTE NAME	HIGHWAY SIGN	SEGMENT LENGTH (MI)	SEGMENT LENGTH (LF)	COMMENTS
ORLEANS COUNTY	DERBY	VT-191	VT-191	0.418	2207.04	
ORLEANS COUNTY	DERBY	VT-191	VT-191	0.332	1752.96	
ORLEANS COUNTY	DERBY	VT-191	VT-191	0.669	3532.32	
ORLEANS COUNTY	NEWPORT CITY	VT-191	VT-191	1.289	6805.92	
ORLEANS COUNTY	NEWPORT CITY	VT-191	VT-191	0.031	163.68	SB Approach from TH-1
ORLEANS COUNTY	NEWPORT CITY	VT-191	VT-191	0.032	168.96	NB Approach from TH-8
			VT-191 TOTAL	2.771	14630.88	
WASHINGTON COUNTY	PLAINFIELD	VT-214	VT-214	0.662	3495.36	
WASHINGTON COUNTY	MARSHFIELD	VT-214	VT-214	0.011	58.08	
WASHINGTON COUNTY	EAST MONTPELIER	VT-214	VT-214	1.388	7328.64	
			VT-214 TOTAL	2.061	10882.08	
CALEDONIA COUNTY	GROTON	VT-232	VT-232	7.182	37920.96	
CALEDONIA COUNTY	PEACHAM	VT-232	VT-232	1.646	8690.88	
WASHINGTON COUNTY	MARSHFIELD	VT-232	VT-232	4.362	23031.36	
WASHINGTON COUNTY	CABOT	VT-232	VT-232	0.358	1890.24	
			VT-232 TOTAL	13.548	71533.44	
ORLEANS COUNTY	WESTFIELD	VT-242	VT-242	3.652	19282.56	
ORLEANS COUNTY	JAY	VT-242	VT-242	5.092	26885.76	
ORLEANS COUNTY	TROY	VT-242	VT-242	0.318	1679.04	
			VT-242 TOTAL	9.062	47847.36	
ORLEANS COUNTY	TROY	TH-1	VT-243	0.316	1668.48	
ORLEANS COUNTY	TROY	VT-243	VT-243	0.865	4567.20	
			VT-243 TOTAL	1.181	6235.68	
ORANGE COUNTY	FAIRLEE	VT-244	VT-244	2.646	13970.88	
			VT-244 TOTAL	2.646	13970.88	
ESSEX COUNTY	CANAAN	VT-253	VT-253	2.159	11399.52	
			VT-253 TOTAL	2.159	11399.52	

NSH = NAMED STATE HIGHWAY
 NHS = NATIONAL HIGHWAY SYSTEM.

SIX INCH = ROUTES THAT SHOULD BE MARKED AS SIX INCH LINES. THESE ARE ESTIMATED ROUTES. MARKINGS SHALL MATCH EXISTING OR AS DIRECTED BY THE ENGINEER.

NIGHT WORK = AREAS THAT ARE DESIGNATED FOR NIGHT WORK.

DIVIDED = AREAS THAT HAVE DIVIDED SEGMENTS. EACH SEGMENT IS MEASURED IN ONE DIRECTION.

ROUNDAABOUT = ROUTES THAT HAVE ROUNDABOUTS.

SEGMENT LENGTH IS PROVIDED FOR INFORMATIONAL PURPOSES ONLY. THESE LENGTHS REPRESENT ROAD CENTERLINE LENGTH AND SHALL NOT BE USED FOR MEASURING QUANTITIES FOR PAYMENT.

PROJECT NAME: STATEWIDE NORTHEAST REGION
 PROJECT NUMBER: STPG MARK(310)

FILE NAME: i17+062roadlst.dgn PLOT DATE: 2/13/2018
 PROJECT LEADER: P. COBURN DRAWN BY: M. BOGACZYK
 DESIGNED BY: M. BOGACZYK CHECKED BY: P. COBURN
 ROAD QUANTITY SHEET 3 SHEET 7 OF 18

SUMMARY BY ROUTE OF STATE HIGHWAYS AND CLASS 1 TOWN HIGHWAYS

ROUTE	LENGTH (MI)
ALT-5	3.207
ALT-122	1.042
BARNET STATE HIGHWAY	0.806
BERLIN STATE HIGHWAY	2.808
COVENTRY STATE HIGHWAY	2.630
FAIRLEE STATE HIGHWAY	0.197
MAIDSTONE STATE HIGHWAY	0.602
NEWBURY STATE HIGHWAY	0.482
NORTON STATE HIGHWAY	0.037
ST. JOHNSBURY STATE HIGHWAY	1.019
US-2	63.549
US-5	100.547
US-302	35.237
VT-2B	3.459
VT-5A	19.527
VT-12	6.690
VT-14	61.447
VT-15	16.199
VT-16	20.925
VT-18	7.887
VT-25	18.235
VT-25A	0.088
VT-25B	0.981
VT-26	0.013
VT-58	18.877
VT-62	6.956
VT-63	4.418
VT-100	19.228
VT-101	4.379
VT-102	43.823
VT-105	58.166
VT-110	9.946
VT-111	15.137
VT-114	51.071
VT-122	15.215
VT-141	0.493
VT-147	0.178
VT-191	2.771
VT-214	2.061
VT-232	13.548
VT-242	9.062
VT-243	1.181
VT-244	2.646
VT-253	2.159
NORTHEAST TOTAL	648.929

NSH = NAMED STATE HIGHWAY
 NHS = NATIONAL HIGHWAY SYSTEM.

SIX INCH = ROUTES THAT SHOULD BE MARKED AS SIX INCH LINES. THESE ARE ESTIMATED ROUTES. MARKINGS SHALL MATCH EXISTING OR AS DIRECTED BY THE ENGINEER.

NIGHT WORK = AREAS THAT ARE DESIGNATED FOR NIGHT WORK.

DIVIDED = AREAS THAT HAVE DIVIDED SEGMENTS. EACH SEGMENT IS MEASURED IN ONE DIRECTION.

ROUNDAABOUT = ROUTES THAT HAVE ROUNDAABOUTS.

SEGMENT LENGTH IS PROVIDED FOR INFORMATIONAL PURPOSES ONLY. THESE LENGTHS REPRESENT ROAD CENTERLINE LENGTH AND SHALL NOT BE USED FOR MEASURING QUANTITIES FOR PAYMENT.

PROJECT NAME: STATEWIDE NORTHEAST REGION
 PROJECT NUMBER: STPG MARK(310)

FILE NAME: i17+062roadlist.dgn PLOT DATE: 2/13/2018
 PROJECT LEADER: P. COBURN DRAWN BY: M. BOGACZYK
 DESIGNED BY: M. BOGACZYK CHECKED BY: P. COBURN
 ROAD SUMMARY SHEET SHEET 8 OF 18

SUMMARY BY COUNTY OF CLASS 2 TOWN HIGHWAYS

COUNTY	TOWN	TH NUMBER	TH NAME	MILEAGE	LINEAR FEET
CALEDONIA COUNTY	BARNET	TH-1	WEST MAIN ST	1.020	5,385.60
CALEDONIA COUNTY	BARNET	TH-1	WEST BARNET RD	4.020	21,225.60
CALEDONIA COUNTY	BARNET	TH-2	EAST PEACHAM RD	0.030	158.40
CALEDONIA COUNTY	BARNET	TH-3	COMERFORD DAM RD	1.820	9,609.60
CALEDONIA COUNTY	BARNET	TH-4	GROTON RD	1.800	9,504.00
CALEDONIA COUNTY	BARNET	TH-5	JOES BROOK RD	1.615	8,527.20
CALEDONIA COUNTY	BARNET	TH-6	NORTH MONROE RD	0.120	633.60
CALEDONIA COUNTY	BARNET	TH-7	MONROE RD	0.200	1,056.00
CALEDONIA COUNTY	BARNET	TH-8	CHURCH ST	0.300	1,584.00
CALEDONIA COUNTY	BARNET	TH-8	MONUMENT CIR	0.040	211.20
CALEDONIA COUNTY	BARNET	TH-9	BARNET CENTER RD	3.060	16,156.80
CALEDONIA COUNTY	BARNET	TH-10	HARVEY MOUNTAIN RD	1.960	10,348.80
CALEDONIA COUNTY	BARNET	TH-10	ROY MOUNTAIN RD	2.890	15,259.20
CALEDONIA COUNTY	BURKE	TH-1	NEWARK ST	2.380	12,566.40
CALEDONIA COUNTY	BURKE	TH-2	BURKE HOLLOW RD	4.880	25,766.40
CALEDONIA COUNTY	BURKE	TH-2	EAST DARLING HILL RD	0.070	369.60
CALEDONIA COUNTY	BURKE	TH-3	CALENDAR BROOK RD	1.400	7,392.00
CALEDONIA COUNTY	BURKE	TH-4	BURKE HILL RD	1.000	5,280.00
CALEDONIA COUNTY	BURKE	TH-4	DEPOT ST	0.240	1,267.20
CALEDONIA COUNTY	BURKE	TH-5	VICTORY RD	0.560	2,956.80
CALEDONIA COUNTY	BURKE	TH-6	DARLING HILL RD	0.400	2,112.00
CALEDONIA COUNTY	BURKE	TH-6	EAST DARLING HILL RD	0.700	3,696.00
CALEDONIA COUNTY	BURKE	TH-7	MOUNTAIN RD	1.950	10,296.00
CALEDONIA COUNTY	BURKE	TH-8	KIRBY RD	0.800	4,224.00
CALEDONIA COUNTY	DANVILLE	TH-1	BRAINERD ST	0.760	4,012.80
CALEDONIA COUNTY	DANVILLE	TH-1	JOES BROOK RD	2.809	14,831.52
CALEDONIA COUNTY	DANVILLE	TH-1	PARK ST	0.030	158.40
CALEDONIA COUNTY	DANVILLE	TH-2	BRUCE BADGER MEML HWY	4.440	23,443.20
CALEDONIA COUNTY	DANVILLE	TH-2	HILL ST	0.590	3,115.20
CALEDONIA COUNTY	DANVILLE	TH-2	NORTH DANVILLE RD	1.930	10,190.40
CALEDONIA COUNTY	DANVILLE	TH-3	PEACHAM RD	3.260	17,212.80
CALEDONIA COUNTY	GROTON	TH-1	FLAG ST	0.010	52.80
CALEDONIA COUNTY	GROTON	TH-1	POWDER SPRING RD	2.240	11,827.20
CALEDONIA COUNTY	GROTON	TH-2	MINARD HILL RD	2.540	13,411.20
CALEDONIA COUNTY	GROTON	TH-3	BOULDER BEACH RD	0.970	5,121.60
CALEDONIA COUNTY	HARDWICK	TH-1	BELFRY RD	1.050	5,544.00
CALEDONIA COUNTY	HARDWICK	TH-2	EAST CHURCH ST	0.381	2,011.68
CALEDONIA COUNTY	HARDWICK	TH-2	HARDWICK ST	2.369	12,508.32
CALEDONIA COUNTY	HARDWICK	TH-2	MAIN ST	0.090	475.20
CALEDONIA COUNTY	HARDWICK	TH-2	CEDAR ST	0.330	1,742.40
CALEDONIA COUNTY	HARDWICK	TH-3	CENTER RD	4.430	23,390.40
CALEDONIA COUNTY	HARDWICK	TH-3	CHURCH ST	0.140	739.20
CALEDONIA COUNTY	HARDWICK	TH-3	MAPLE ST	0.112	591.36
CALEDONIA COUNTY	HARDWICK	TH-3	NORTH MAIN ST	0.112	591.36
CALEDONIA COUNTY SHEET 1 TOTAL				61.848	326,557.44

SEGMENT LENGTH IS PROVIDED FOR INFORMATIONAL PURPOSES ONLY. THESE LENGTHS REPRESENT ROAD CENTERLINE LENGTH AND SHALL NOT BE USED FOR MEASURING QUANTITIES FOR PAYMENT.

PROJECT NAME:	STATEWIDE NORTHEAST REGION
PROJECT NUMBER:	STPG MARK(310)
FILE NAME: +17+062 Class 2.dgn	PLOT DATE: 2/13/2018
PROJECT LEADER: P. COBURN	DRAWN BY: M. BOGACZYK
DESIGNED BY: M. BOGACZYK	CHECKED BY: P. COBURN
CLASS 2 TH QUANTITY SHEET 1	SHEET 9 OF 18

SUMMARY BY COUNTY OF CLASS 2 TOWN HIGHWAYS

COUNTY	TOWN	TH NUMBER	TH NAME	MILEAGE	LINEAR FEET
CALEDONIA COUNTY	HARDWICK	TH-3	SLAPP HILL	0.411	2,170.08
CALEDONIA COUNTY	HARDWICK	TH-4	STANNARD MOUNTAIN RD	0.100	528.00
CALEDONIA COUNTY	HARDWICK	TH-5	EAST MAIN ST	0.330	1,742.40
CALEDONIA COUNTY	HARDWICK	TH-6	MAIN ST	0.200	1,056.00
CALEDONIA COUNTY	HARDWICK	TH-7	SCHOOL ST	0.340	1,795.20
CALEDONIA COUNTY	HARDWICK	TH-8	MACKVILLE RD	0.950	5,016.00
CALEDONIA COUNTY	KIRBY	TH-1	RIDGE RD	0.510	2,692.80
CALEDONIA COUNTY	LYNDON	TH-1	SOUTH WHEELOCK RD	4.050	21,384.00
CALEDONIA COUNTY	LYNDON	TH-2	RED VILLAGE RD	3.910	20,644.80
CALEDONIA COUNTY	LYNDON	TH-4	CALENDAR BROOK RD	0.600	3,168.00
CALEDONIA COUNTY	LYNDON	TH-5	DARLING HILL RD	1.610	8,500.80
CALEDONIA COUNTY	LYNDON	TH-6	SEVERANCE HILL RD	1.050	5,544.00
CALEDONIA COUNTY	LYNDON	TH-9	COLLEGE RD	0.510	2,692.80
CALEDONIA COUNTY	LYNDON	TH-9	MCGOFF HL	1.000	5,280.00
CALEDONIA COUNTY	LYNDON	TH-9	LOWER CAMPUS DR	0.550	2,904.00
CALEDONIA COUNTY	LYNDON	TH-10	BACK CENTER RD	1.420	7,497.60
CALEDONIA COUNTY	LYNDON	TH-11	LILY POND RD	2.030	10,718.40
CALEDONIA COUNTY	NEWARK	TH-1	NEWARK ST	3.360	17,740.80
CALEDONIA COUNTY	PEACHAM	TH-1	BAYLEY HAZEN RD	1.840	9,715.20
CALEDONIA COUNTY	PEACHAM	TH-1	PEACHAM BARNET RD	0.900	4,752.00
CALEDONIA COUNTY	PEACHAM	TH-1	PEACHAM DANVILLE RD	1.890	9,979.20
CALEDONIA COUNTY	PEACHAM	TH-1	MAIN ST	0.830	4,382.40
CALEDONIA COUNTY	PEACHAM	TH-2	EAST PEACHAM RD	2.230	11,774.40
CALEDONIA COUNTY	PEACHAM	TH-3	PEACHAM GROTON RD	1.140	6,019.20
CALEDONIA COUNTY	RYEGATE	TH-1	EAST RD	2.150	11,352.00
CALEDONIA COUNTY	RYEGATE	TH-1	SOUTH BAYLEY-HAZEN RD	1.440	7,603.20
CALEDONIA COUNTY	RYEGATE	TH-1	BOLTONVILLE RD	1.260	6,652.80
CALEDONIA COUNTY	RYEGATE	TH-1	NORTH BAYLEY-HAZEN RD	0.060	316.80
CALEDONIA COUNTY	RYEGATE	TH-2	CHURCH ST	0.350	1,848.00
CALEDONIA COUNTY	RYEGATE	TH-3	PAPERMILL RD	0.180	950.40
CALEDONIA COUNTY	RYEGATE	TH-4	PEACHAM RD	2.320	12,249.60
CALEDONIA COUNTY	RYEGATE	TH-5	CREAMERY RD	1.730	9,134.40
CALEDONIA COUNTY	RYEGATE	TH-6	WITHERSPOON RD	4.470	23,601.60
CALEDONIA COUNTY	ST. JOHNSBURY	TH-4	CONCORD AVE	1.770	9,345.60
CALEDONIA COUNTY	ST. JOHNSBURY	TH-4	DANIELS FARM RD	0.010	52.80
CALEDONIA COUNTY	ST. JOHNSBURY	TH-5	MAPLE ST	0.210	1,108.80
CALEDONIA COUNTY	ST. JOHNSBURY	TH-6	BREEZY HILL RD	1.970	10,401.60
CALEDONIA COUNTY	ST. JOHNSBURY	TH-6	PLEASANT ST	0.730	3,854.40
CALEDONIA COUNTY	ST. JOHNSBURY	TH-7	NORTH DANVILLE RD	1.400	7,392.00
CALEDONIA COUNTY	ST. JOHNSBURY	TH-8	SEVERANCE HILL RD	3.530	18,638.40
CALEDONIA COUNTY	ST. JOHNSBURY	TH-9	OLD CENTER RD	1.080	5,702.40
CALEDONIA COUNTY	ST. JOHNSBURY	TH-10	HOSPITAL DR	0.500	2,640.00
CALEDONIA COUNTY	SUTTON	TH-1	CALENDAR BROOK RD	2.560	13,516.80
CALEDONIA COUNTY	SUTTON	TH-1	UNDERPASS RD	5.260	27,772.80
CALEDONIA COUNTY SHEET 2 TOTAL				64.741	341,832.48

SEGMENT LENGTH IS PROVIDED FOR INFORMATIONAL PURPOSES ONLY. THESE LENGTHS REPRESENT ROAD CENTERLINE LENGTH AND SHALL NOT BE USED FOR MEASURING QUANTITIES FOR PAYMENT.

PROJECT NAME:	STATEWIDE NORTHEAST REGION
PROJECT NUMBER:	STPG MARK(310)
FILE NAME: +17+062 Class 2.dgn	PLOT DATE: 2/13/2018
PROJECT LEADER: P. COBURN	DRAWN BY: M. BOGACZYK
DESIGNED BY: M. BOGACZYK	CHECKED BY: P. COBURN
CLASS 2 TH QUANTITY SHEET 2	SHEET 10 OF 18

SUMMARY BY COUNTY OF CLASS 2 TOWN HIGHWAYS

COUNTY	TOWN	TH NUMBER	TH NAME	MILEAGE	LINEAR FEET
CALEDONIA COUNTY	SUTTON	TH-2	BURKE RD	1.880	9,926.40
CALEDONIA COUNTY	SUTTON	TH-2	UNDERPASS RD FRK	0.020	105.60
CALEDONIA COUNTY	SUTTON	TH-3	CENTER ST	0.140	739.20
CALEDONIA COUNTY	SUTTON	TH-3	SHEFFIELD RD	0.133	702.24
CALEDONIA COUNTY	WALDEN	TH-1	CABOT RD	1.590	8,395.20
CALEDONIA COUNTY	WALDEN	TH-3	ROUTE 215	0.950	5,016.00
CALEDONIA COUNTY	WATERFORD	TH-1	CROSS RD	0.320	1,689.60
CALEDONIA COUNTY	WATERFORD	TH-2	LOWER WATERFORD RD	2.609	13,775.52
CALEDONIA COUNTY	WATERFORD	TH-2	LOWER WATERFORD RD FRK	0.021	110.88
CALEDONIA COUNTY	WATERFORD	TH-3	DUCK POND RD	3.040	16,051.20
CALEDONIA COUNTY	WATERFORD	TH-4	DANIELS FARM RD	1.356	7,159.68
CALEDONIA COUNTY	WHEELOCK	TH-1	SOUTH WHEELOCK RD	0.448	2,365.44
CALEDONIA COUNTY SHEET 3 TOTAL				12.507	66,036.96
CALEDONIA COUNTY SHEET 1 TOTAL				61.848	326,557.44
CALEDONIA COUNTY SHEET 2 TOTAL				64.741	341,832.48
CALEDONIA COUNTY SHEET 3 TOTAL				12.507	66,036.96
CALEDONIA COUNTY TOTAL				139.096	734,426.88

SEGMENT LENGTH IS PROVIDED FOR INFORMATIONAL PURPOSES ONLY. THESE LENGTHS REPRESENT ROAD CENTERLINE LENGTH AND SHALL NOT BE USED FOR MEASURING QUANTITIES FOR PAYMENT.

PROJECT NAME: STATEWIDE NORTHEAST REGION	PLOT DATE: 2/13/2018
PROJECT NUMBER: STPG MARK(310)	
FILE NAME: +17+062 Class 2.dgn	DRAWN BY: M. BOGACZYK
PROJECT LEADER: P. COBURN	CHECKED BY: P. COBURN
DESIGNED BY: M. BOGACZYK	
CLASS 2 TH QUANTITY SHEET 3	SHEET II OF 18

SUMMARY BY COUNTY OF CLASS 2 TOWN HIGHWAYS

COUNTY	TOWN	TH NUMBER	TH NAME	MILEAGE	LINEAR FEET
ESSEX COUNTY	BRIGHTON	TH-3	NEWARK RD	0.830	4,382.40
ESSEX COUNTY	BRIGHTON	TH-4	MIDDLE ST FRK	0.020	105.60
ESSEX COUNTY	BRIGHTON	TH-4	MOUNTAIN ST	0.032	168.96
ESSEX COUNTY	BRIGHTON	TH-4	SOUTH ST	0.145	765.60
ESSEX COUNTY	BRIGHTON	TH-4	MIDDLE ST	0.548	2,893.44
ESSEX COUNTY	BRIGHTON	TH-5	LAKESHORE DR	1.600	8,448.00
ESSEX COUNTY	BRIGHTON	TH-5	PLEASANT ST	1.550	8,184.00
ESSEX COUNTY	CANAAN	TH-1	RIVER RD	2.350	12,408.00
ESSEX COUNTY	CONCORD	TH-1	VICTORY RD	2.620	13,833.60
ESSEX COUNTY	CONCORD	TH-2	BEACH DR	0.860	4,540.80
ESSEX COUNTY	CONCORD	TH-3	SHADOW LAKE RD	0.070	369.60
ESSEX COUNTY	CONCORD	TH-4	OREGON RD	3.560	18,796.80
ESSEX COUNTY	CONCORD	TH-5	SHADOW LAKE RD	0.060	316.80
ESSEX COUNTY	EAST HAVEN	TH-1	SCHOOL ST	0.670	3,537.60
ESSEX COUNTY	GUILDHALL	TH-1	GRANBY RD	0.893	4,715.04
ESSEX COUNTY	GUILDHALL	TH-2	BRIDGE ST	0.070	369.60
ESSEX COUNTY	GUILDHALL	TH-2	BRIDGE ST FRK	0.030	158.40
ESSEX COUNTY	LUNENBURG	TH-1	BEECH ST	0.130	686.40
ESSEX COUNTY	LUNENBURG	TH-1	COMMERCIAL AVE	0.180	950.40
ESSEX COUNTY	LUNENBURG	TH-1	EAST CONCORD RD	1.030	5,438.40
ESSEX COUNTY	LUNENBURG	TH-1	RIVER RD	5.280	27,878.40
ESSEX COUNTY	LUNENBURG	TH-1	RIVERSIDE AVE	0.630	3,326.40
ESSEX COUNTY	LUNENBURG	TH-2	POND HILL RD	0.760	4,012.80
ESSEX COUNTY	LUNENBURG	TH-2	SOUTH LUNENBURG RD	1.900	10,032.00
ESSEX COUNTY	LUNENBURG	TH-2	BOBBIN MILL RD	0.450	2,376.00
ESSEX COUNTY	LUNENBURG	TH-3	TOWN HIGHWAY 3	0.040	211.20
ESSEX COUNTY	LUNENBURG	TH-4	TOWN HIGHWAY 4	0.040	211.20
ESSEX COUNTY	VICTORY	TH-1	GRANBY RD	0.434	2,291.52
ESSEX COUNTY	VICTORY	TH-2	VICTORY RD	0.290	1,531.20
ESSEX COUNTY TOTAL				27.072	142,940.16

SEGMENT LENGTH IS PROVIDED FOR INFORMATIONAL PURPOSES ONLY. THESE LENGTHS REPRESENT ROAD CENTERLINE LENGTH AND SHALL NOT BE USED FOR MEASURING QUANTITIES FOR PAYMENT.

PROJECT NAME:	STATEWIDE NORTHEAST REGION
PROJECT NUMBER:	STPG MARK(310)
FILE NAME: +17+062 Class 2.dgn	PLOT DATE: 2/13/2018
PROJECT LEADER: P. COBURN	DRAWN BY: M. BOGACZYK
DESIGNED BY: M. BOGACZYK	CHECKED BY: P. COBURN
CLASS 2 TH QUANTITY SHEET 4	SHEET 12 OF 18

SUMMARY BY COUNTY OF CLASS 2 TOWN HIGHWAYS

COUNTY	TOWN	TH NUMBER	TH NAME	MILEAGE	LINEAR FEET
ORANGE COUNTY	BRADFORD	TH-1	CHELSEA RD	1.820	9,609.60
ORANGE COUNTY	BRADFORD	TH-2	ROWELL BROOK RD	2.550	13,464.00
ORANGE COUNTY	BRADFORD	TH-2	SOUTH RD	0.090	475.20
ORANGE COUNTY	BRADFORD	TH-3	FAIRGROUND RD	2.990	15,787.20
ORANGE COUNTY	BRADFORD	TH-4	SOUTH RD	3.520	18,585.60
ORANGE COUNTY	CORINTH	TH-1	VILLAGE RD	1.100	5,808.00
ORANGE COUNTY	CORINTH	TH-2	BROOK RD	0.380	2,006.40
ORANGE COUNTY	CORINTH	TH-2	COOKEVILLE RD	2.893	15,275.04
ORANGE COUNTY	CORINTH	TH-2	GOOSE GREEN RD	2.810	14,836.80
ORANGE COUNTY	CORINTH	TH-3	CHELSEA RD	5.710	30,148.80
ORANGE COUNTY	CORINTH	TH-4	BROOK RD	3.970	20,961.60
ORANGE COUNTY	CORINTH	TH-6	EAGLE HOLLOW RD	0.740	3,907.20
ORANGE COUNTY	CORINTH	TH-7	SOUTH RD	0.060	316.80
ORANGE COUNTY	FAIRLEE	TH-1	LAKE MOREY RD	5.560	29,356.80
ORANGE COUNTY	NEWBURY	TH-1	SNAKE RD	3.150	16,632.00
ORANGE COUNTY	NEWBURY	TH-1	TYLER FARM RD	1.620	8,553.60
ORANGE COUNTY	NEWBURY	TH-2	SWAMP RD	1.222	6,452.16
ORANGE COUNTY	NEWBURY	TH-3	BOLTONVILLE RD	0.290	1,531.20
ORANGE COUNTY	NEWBURY	TH-4	CHAPEL ST	0.230	1,214.40
ORANGE COUNTY	NEWBURY	TH-4	SCOTCH HOLLOW RD	6.620	34,953.60
ORANGE COUNTY	ORANGE	TH-1	RESERVOIR RD	4.950	26,136.00
ORANGE COUNTY	ORANGE	TH-2	TUCKER RD	1.910	10,084.80
ORANGE COUNTY	TOPSHAM	TH-1	POWDER SPRING RD	5.330	28,142.40
ORANGE COUNTY	TOPSHAM	TH-1	TOPSHAM CORINTH RD	3.780	19,958.40
ORANGE COUNTY	TOPSHAM	TH-2	SWAMP RD	2.090	11,035.20
ORANGE COUNTY	TOPSHAM	TH-3	EAST ORANGE RD	0.980	5,174.40
ORANGE COUNTY TOTAL				66.365	350,407.20

SEGMENT LENGTH IS PROVIDED FOR INFORMATIONAL PURPOSES ONLY. THESE LENGTHS REPRESENT ROAD CENTERLINE LENGTH AND SHALL NOT BE USED FOR MEASURING QUANTITIES FOR PAYMENT.

PROJECT NAME: STATEWIDE NORTHEAST REGION
PROJECT NUMBER: STPG MARK(310)

FILE NAME: +17+062 Class 2.dgn PLOT DATE: 2/13/2018
PROJECT LEADER: P. COBURN DRAWN BY: M. BOGACZYK
DESIGNED BY: M. BOGACZYK CHECKED BY: P. COBURN
CLASS 2 TH QUANTITY SHEET 5 SHEET 13 OF 18

SUMMARY BY COUNTY OF CLASS 2 TOWN HIGHWAYS

COUNTY	TOWN	TH NUMBER	TH NAME	MILEAGE	LINEAR FEET
ORLEANS COUNTY	ALBANY	TH-1	CREEK RD	2.710	14,308.80
ORLEANS COUNTY	ALBANY	TH-3	WATER ST	0.480	2,534.40
ORLEANS COUNTY	BARTON	TH-1	WILLOUGHBY LAKE RD	5.570	29,409.60
ORLEANS COUNTY	BARTON	TH-2	MAPLE ST	0.512	2,703.36
ORLEANS COUNTY	BARTON	TH-2	MEMORIAL SQ	0.038	200.64
ORLEANS COUNTY	BARTON	TH-2	ROARING BROOK RD	1.900	10,032.00
ORLEANS COUNTY	BARTON	TH-3	EAST ST	0.378	1,995.84
ORLEANS COUNTY	BARTON	TH-3	MAPLE ST	0.350	1,848.00
ORLEANS COUNTY	BARTON	TH-3	EASTERN AVE	0.740	3,907.20
ORLEANS COUNTY	BARTON	TH-4	ROARING BROOK RD	0.560	2,956.80
ORLEANS COUNTY	BARTON	TH-4	TARBOX HILL RD	0.520	2,745.60
ORLEANS COUNTY	BARTON	TH-5	CENTER RD	0.500	2,640.00
ORLEANS COUNTY	BARTON	TH-5	ELM ST	0.640	3,379.20
ORLEANS COUNTY	BARTON	TH-6	LAKE REGION RD	0.920	4,857.60
ORLEANS COUNTY	BARTON	TH-7	BURTON HILL RD	0.950	5,016.00
ORLEANS COUNTY	BARTON	TH-8	MAPLE HILL RD	3.530	18,638.40
ORLEANS COUNTY	BROWNINGTON	TH-1	CENTER RD	1.400	7,392.00
ORLEANS COUNTY	BROWNINGTON	TH-2	FROG POND RD	1.190	6,283.20
ORLEANS COUNTY	BROWNINGTON	TH-2	HINMAN SETTLER RD	0.450	2,376.00
ORLEANS COUNTY	BROWNINGTON	TH-2	HUNT HILL RD	0.386	2,038.08
ORLEANS COUNTY	BROWNINGTON	TH-2	OLD STONE HOUSE RD	0.252	1,330.56
ORLEANS COUNTY	BROWNINGTON	TH-2	SCHOOLHOUSE RD	0.400	2,112.00
ORLEANS COUNTY	CHARLESTON	TH-1	HUDSON RD	0.830	4,382.40
ORLEANS COUNTY	CHARLESTON	TH-2	DURGIN RD	0.800	4,224.00
ORLEANS COUNTY	CHARLESTON	TH-3	CHURCH HILL RD	0.445	2,349.60
ORLEANS COUNTY	COVENTRY	TH-2	AIRPORT RD	1.360	7,180.80
ORLEANS COUNTY	COVENTRY	TH-4	ALDERBROOK RD	1.950	10,296.00
ORLEANS COUNTY	CRAFTSBURY	TH-1	NORTH CRAFTSBURY RD	3.670	19,377.60
ORLEANS COUNTY	CRAFTSBURY	TH-1	SOUTH CRAFTSBURY RD	1.780	9,398.40
ORLEANS COUNTY	CRAFTSBURY	TH-2	EAST CRAFTSBURY RD	2.180	11,510.40
ORLEANS COUNTY	CRAFTSBURY	TH-3	WILD BRANCH RD	3.320	17,529.60
ORLEANS COUNTY	DERBY	TH-1	CASWELL AVE	0.080	422.40
ORLEANS COUNTY	DERBY	TH-1	HOLLAND RD	2.160	11,404.80
ORLEANS COUNTY	DERBY	TH-2	ELM ST	1.890	9,979.20
ORLEANS COUNTY	DERBY	TH-3	BAXTER AV	0.500	2,640.00
ORLEANS COUNTY	DERBY	TH-3	BEEBE RD	3.160	16,684.80
ORLEANS COUNTY	DERBY	TH-4	DARLING HILL RD	4.780	25,238.40
ORLEANS COUNTY	DERBY	TH-5	HINMAN SETTLER RD	2.400	12,672.00
ORLEANS COUNTY	DERBY	TH-6	NORTH DERBY RD	4.320	22,809.60
ORLEANS COUNTY	DERBY	TH-7	SHATTUCK HILL RD	1.300	6,864.00
ORLEANS COUNTY	DERBY	TH-8	SCHULER RD	1.130	5,966.40
ORLEANS COUNTY	GLOVER	TH-1	COUNTY RD	2.090	11,035.20
ORLEANS COUNTY SHEET 1 TOTAL				64.521	340,670.88

SEGMENT LENGTH IS PROVIDED FOR INFORMATIONAL PURPOSES ONLY. THESE LENGTHS REPRESENT ROAD CENTERLINE LENGTH AND SHALL NOT BE USED FOR MEASURING QUANTITIES FOR PAYMENT.

PROJECT NAME:	STATEWIDE NORTHEAST REGION
PROJECT NUMBER:	STPG MARK(310)
FILE NAME: +17+062 Class 2.dgn	PLOT DATE: 2/13/2018
PROJECT LEADER: P. COBURN	DRAWN BY: M. BOGACZYK
DESIGNED BY: M. BOGACZYK	CHECKED BY: P. COBURN
CLASS 2 TH QUANTITY SHEET 6	SHEET 14 OF 18

SUMMARY BY COUNTY OF CLASS 2 TOWN HIGHWAYS

COUNTY	TOWN	TH NUMBER	TH NAME	MILEAGE	LINEAR FEET
ORLEANS COUNTY	GLOVER	TH-2	SHADOW LAKE RD	2.680	14,150.40
ORLEANS COUNTY	GLOVER	TH-3	BEAN HILL RD	2.600	13,728.00
ORLEANS COUNTY	GLOVER	TH-3	ROARING BROOK RD	0.280	1,478.40
ORLEANS COUNTY	GREENSBORO	TH-1	WILSON ST	0.160	844.80
ORLEANS COUNTY	GREENSBORO	TH-1	CRAFTSBURY RD	4.940	26,083.20
ORLEANS COUNTY	GREENSBORO	TH-1	EAST ST	0.060	316.80
ORLEANS COUNTY	GREENSBORO	TH-1	THE BEND RD	2.650	13,992.00
ORLEANS COUNTY	GREENSBORO	TH-2	HARDWICK ST	0.700	3,696.00
ORLEANS COUNTY	GREENSBORO	TH-2	BREEZY AVE	0.840	4,435.20
ORLEANS COUNTY	GREENSBORO	TH-3	CENTER RD	0.520	2,745.60
ORLEANS COUNTY	GREENSBORO	TH-4	MAIN ST	1.370	7,233.60
ORLEANS COUNTY	HOLLAND	TH-1	VALLEY RD	6.350	33,528.00
ORLEANS COUNTY	IRASBURG	TH-1	CREEK RD	2.500	13,200.00
ORLEANS COUNTY	IRASBURG	TH-1	PARK AV	0.160	844.80
ORLEANS COUNTY	IRASBURG	TH-3	RIVER RD	0.505	2,666.40
ORLEANS COUNTY	IRASBURG	TH-4	BURTON HILL RD	0.830	4,382.40
ORLEANS COUNTY	IRASBURG	TH-5	LAKE REGION RD	1.130	5,966.40
ORLEANS COUNTY	JAY	TH-1	CROSS RD	3.310	17,476.80
ORLEANS COUNTY	JAY	TH-2	JAY PEAK RD	0.790	4,171.20
ORLEANS COUNTY	JAY	TH-3	STONEY PATH RD	0.560	2,956.80
ORLEANS COUNTY	JAY	TH-4	STATESIDE RD	0.020	105.60
ORLEANS COUNTY	LOWELL	TH-1	HAZEN NOTCH RD	1.890	9,979.20
ORLEANS COUNTY	LOWELL	TH-2	LOWER VILLAGE RD	0.480	2,534.40
ORLEANS COUNTY	LOWELL	TH-2	LOWER VILLAGE RD FRK	0.020	105.60
ORLEANS COUNTY	LOWELL	TH-3	MINES RD	5.200	27,456.00
ORLEANS COUNTY	MORGAN	TH-1	VALLEY RD	1.600	8,448.00
ORLEANS COUNTY	MORGAN	TH-2	GORE RD SOUTH	1.400	7,392.00
ORLEANS COUNTY	MORGAN	TH-3	MORGAN CHARLESTON RD	0.363	1,916.64
ORLEANS COUNTY	NEWPORT CITY	TH-3	LAKE RD	2.234	11,795.52
ORLEANS COUNTY	NEWPORT CITY	TH-3	MAIN ST	0.277	1,462.56
ORLEANS COUNTY	NEWPORT CITY	TH-4	GLEN RD	1.205	6,362.40
ORLEANS COUNTY	NEWPORT CITY	TH-4	WESTERN AVE	0.386	2,038.08
ORLEANS COUNTY	NEWPORT CITY	TH-6	SIAS AVE	0.519	2,740.32
ORLEANS COUNTY	NEWPORT CITY	TH-8	WESTERN AVE	0.300	1,584.00
ORLEANS COUNTY	NEWPORT CITY	TH-9	ALDERBROOK RD	0.240	1,267.20
ORLEANS COUNTY	NEWPORT CITY	TH-10	BLUFF RD	0.945	4,989.60
ORLEANS COUNTY	NEWPORT CITY	TH-10	UNION ST	0.354	1,869.12
ORLEANS COUNTY	NEWPORT CITY	TH-11	RAILROAD SQUARE	0.180	950.40
ORLEANS COUNTY	NEWPORT TOWN	TH-1	CROSS RD	2.750	14,520.00
ORLEANS COUNTY	NEWPORT TOWN	TH-2	LAKE RD	3.320	17,529.60
ORLEANS COUNTY SHEET 2 TOTAL				56.618	298,943.04

SEGMENT LENGTH IS PROVIDED FOR INFORMATIONAL PURPOSES ONLY. THESE LENGTHS REPRESENT ROAD CENTERLINE LENGTH AND SHALL NOT BE USED FOR MEASURING QUANTITIES FOR PAYMENT.

PROJECT NAME:	STATEWIDE NORTHEAST REGION
PROJECT NUMBER:	STPG MARK(310)
FILE NAME: +17+062 Class 2.dgn	PLOT DATE: 2/13/2018
PROJECT LEADER: P. COBURN	DRAWN BY: M. BOGACZYK
DESIGNED BY: M. BOGACZYK	CHECKED BY: P. COBURN
CLASS 2 TH QUANTITY SHEET 7	SHEET 15 OF 18

SUMMARY BY COUNTY OF CLASS 2 TOWN HIGHWAYS

COUNTY	TOWN	TH NUMBER	TH NAME	MILEAGE	LINEAR FEET
ORLEANS COUNTY	NEWPORT TOWN	TH-3	VANCE HILL RD	3.400	17,952.00
ORLEANS COUNTY	NEWPORT TOWN	TH-4	CITY FARM RD	1.450	7,656.00
ORLEANS COUNTY	TROY	TH-1	SOUTH PLEASANT ST	0.320	1,689.60
ORLEANS COUNTY	TROY	TH-2	EAST HILL	5.700	30,096.00
ORLEANS COUNTY	TROY	TH-3	ELM ST	0.198	1,045.44
ORLEANS COUNTY	TROY	TH-3	HIGHLAND AVE	0.092	485.76
ORLEANS COUNTY	WESTFIELD	TH-1	NORTH HILL RD	2.700	14,256.00
ORLEANS COUNTY	WESTFIELD	TH-3	KENNISON RD	2.350	12,408.00
ORLEANS COUNTY	WESTMORE	TH-1	NORTH BEACH RD	0.290	1,531.20
ORLEANS COUNTY	WESTMORE	TH-1	WILLOUGHBY LAKE RD	0.460	2,428.80
ORLEANS COUNTY SHEET 3 TOTAL				16.960	89,548.80
ORLEANS COUNTY SHEET 1 TOTAL				64.521	340,670.88
ORLEANS COUNTY SHEET 2 TOTAL				56.618	298,943.04
ORLEANS COUNTY SHEET 3 TOTAL				16.960	89,548.80
ORLEANS COUNTY TOTAL				138.099	729,162.72

SEGMENT LENGTH IS PROVIDED FOR INFORMATIONAL PURPOSES ONLY. THESE LENGTHS REPRESENT ROAD CENTERLINE LENGTH AND SHALL NOT BE USED FOR MEASURING QUANTITIES FOR PAYMENT.

PROJECT NAME: STATEWIDE NORTHEAST REGION	PLOT DATE: 2/13/2018
PROJECT NUMBER: STPG MARK(310)	
FILE NAME: +17+062 Class 2.dgn	DRAWN BY: M. BOGACZYK
PROJECT LEADER: P. COBURN	CHECKED BY: P. COBURN
DESIGNED BY: M. BOGACZYK	
CLASS 2 TH QUANTITY SHEET 8	SHEET 16 OF 18

SUMMARY BY COUNTY OF CLASS 2 TOWN HIGHWAYS

COUNTY	TOWN	TH NUMBER	TH NAME	MILEAGE	LINEAR FEET
WASHINGTON COUNTY	BARRE CITY	TH-4	MERCHANT ST	0.760	4,012.80
WASHINGTON COUNTY	BARRE CITY	TH-5	HILL ST	0.810	4,276.80
WASHINGTON COUNTY	BARRE CITY	TH-6	QUARRY ST	0.270	1,425.60
WASHINGTON COUNTY	BARRE CITY	TH-7	PROSPECT ST	1.450	7,656.00
WASHINGTON COUNTY	BARRE CITY	TH-8	BERLIN ST	0.710	3,748.80
WASHINGTON COUNTY	BARRE TOWN	TH-1	COGSWELL ST	0.200	1,056.00
WASHINGTON COUNTY	BARRE TOWN	TH-1	GRANITEVILLE RD	2.540	13,411.20
WASHINGTON COUNTY	BARRE TOWN	TH-1	QUARRY HILL RD	1.110	5,860.80
WASHINGTON COUNTY	BARRE TOWN	TH-2	MILL ST	0.160	844.80
WASHINGTON COUNTY	BARRE TOWN	TH-2	WEBSTERVILLE RD	2.500	13,200.00
WASHINGTON COUNTY	BARRE TOWN	TH-3	CHURCH HILL RD	1.270	6,705.60
WASHINGTON COUNTY	BARRE TOWN	TH-4	MIDDLE RD	1.550	8,184.00
WASHINGTON COUNTY	BARRE TOWN	TH-4	MIDDLE RD FORK	0.040	211.20
WASHINGTON COUNTY	BARRE TOWN	TH-5	PLAINFIELD BROOK RD	1.580	8,342.40
WASHINGTON COUNTY	BARRE TOWN	TH-6	AIRPORT RD	0.900	4,752.00
WASHINGTON COUNTY	BARRE TOWN	TH-6	MILLER RD	0.360	1,900.80
WASHINGTON COUNTY	BARRE TOWN	TH-6	UPPER PROSPECT ST	0.250	1,320.00
WASHINGTON COUNTY	BARRE TOWN	TH-7	BRIDGE ST	0.650	3,432.00
WASHINGTON COUNTY	BARRE TOWN	TH-7	MORRISON RD	0.800	4,224.00
WASHINGTON COUNTY	BARRE TOWN	TH-8	CUMMINGS RD	0.780	4,118.40
WASHINGTON COUNTY	BARRE TOWN	TH-8	HILL ST	0.280	1,478.40
WASHINGTON COUNTY	BARRE TOWN	TH-8	WINDY WOOD RD	2.260	11,932.80
WASHINGTON COUNTY	BARRE TOWN	TH-9	MILLER RD	1.550	8,184.00
WASHINGTON COUNTY	BARRE TOWN	TH-9	MILLER RD EXT	0.030	158.40
WASHINGTON COUNTY	BARRE TOWN	TH-9	WEST RD	0.570	3,009.60
WASHINGTON COUNTY	BARRE TOWN	TH-10	BAPTIST ST	0.540	2,851.20
WASHINGTON COUNTY	BARRE TOWN	TH-12	FARWELL ST	1.640	8,659.20
WASHINGTON COUNTY	BERLIN	TH-1	CROSTOWN RD	0.380	2,006.40
WASHINGTON COUNTY	BERLIN	TH-1	PAINE TPKE N	2.140	11,299.20
WASHINGTON COUNTY	BERLIN	TH-1	PAINE TRNPK S	0.040	211.20
WASHINGTON COUNTY	BERLIN	TH-2	JUNCTION RD	0.550	2,904.00
WASHINGTON COUNTY	BERLIN	TH-3	COX BROOK RD	0.870	4,593.60
WASHINGTON COUNTY	BERLIN	TH-4	AIRPORT RD	1.390	7,339.20
WASHINGTON COUNTY	BERLIN	TH-5	SCOTT HILL RD	1.900	10,032.00
WASHINGTON COUNTY	BERLIN	TH-6	FISHER RD	0.520	2,745.60
WASHINGTON COUNTY	BERLIN	TH-7	THREE MILE BRIDGE RD	0.030	158.40
WASHINGTON COUNTY	CABOT	TH-1	MAIN ST	1.060	5,596.80
WASHINGTON COUNTY	CABOT	TH-1	ROUTE 215 NORTH	3.350	17,688.00
WASHINGTON COUNTY	CABOT	TH-1	ROUTE 215 SOUTH	2.400	12,672.00
WASHINGTON COUNTY	CABOT	TH-2	SOUTH WALDEN RD	3.850	20,328.00
WASHINGTON COUNTY	CALAIS	TH-1	COUNTY RD	3.120	16,473.60
WASHINGTON COUNTY	CALAIS	TH-4	MARSHFIELD RD	0.450	2,376.00
WASHINGTON COUNTY SHEET 1 TOTAL				47.610	251,380.80

SEGMENT LENGTH IS PROVIDED FOR INFORMATIONAL PURPOSES ONLY. THESE LENGTHS REPRESENT ROAD CENTERLINE LENGTH AND SHALL NOT BE USED FOR MEASURING QUANTITIES FOR PAYMENT.

PROJECT NAME:	STATEWIDE NORTHEAST REGION
PROJECT NUMBER:	STPG MARK(310)
FILE NAME: +17+062 Class 2.dgn	PLOT DATE: 2/13/2018
PROJECT LEADER: P. COBURN	DRAWN BY: M. BOGACZYK
DESIGNED BY: M. BOGACZYK	CHECKED BY: P. COBURN
CLASS 2 TH QUANTITY SHEET 9	SHEET 17 OF 18

SUMMARY BY COUNTY OF CLASS 2 TOWN HIGHWAYS

COUNTY	TOWN	TH NUMBER	TH NAME	MILEAGE	LINEAR FEET
WASHINGTON COUNTY	CALAIS	TH-5	MOSCOW WOODS RD	0.140	739.20
WASHINGTON COUNTY	CALAIS	TH-7	LIGHTENING RIDGE RD	0.330	1,742.40
WASHINGTON COUNTY	EAST MONTPELIER	TH-1	COUNTY RD	4.830	25,502.40
WASHINGTON COUNTY	EAST MONTPELIER	TH-2	TOWNE HILL RD	2.390	12,619.20
WASHINGTON COUNTY	EAST MONTPELIER	TH-3	CENTER RD	1.669	8,812.32
WASHINGTON COUNTY	EAST MONTPELIER	TH-5	GALLISON HILL RD	0.700	3,696.00
WASHINGTON COUNTY	EAST MONTPELIER	TH-6	MUDDY BROOK RD	0.450	2,376.00
WASHINGTON COUNTY	EAST MONTPELIER	TH-7	QUAKER HILL RD	0.810	4,276.80
WASHINGTON COUNTY	EAST MONTPELIER	TH-7	VINCENT FLATS RD	1.000	5,280.00
WASHINGTON COUNTY	MARSHFIELD	TH-1	CABOT RD	1.400	7,392.00
WASHINGTON COUNTY	MARSHFIELD	TH-2	CREAMERY ST	0.550	2,904.00
WASHINGTON COUNTY	MARSHFIELD	TH-3	NASMITH BROOK RD	0.140	739.20
WASHINGTON COUNTY	MARSHFIELD	TH-4	HOLLISTER HILL RD	0.160	844.80
WASHINGTON COUNTY	PLAINFIELD	TH-1	MILL ST	0.150	792.00
WASHINGTON COUNTY	PLAINFIELD	TH-1	MIDDLE RD	0.137	723.36
WASHINGTON COUNTY	PLAINFIELD	TH-1	BARRE HILL	0.490	2,587.20
WASHINGTON COUNTY	PLAINFIELD	TH-1	MAIN ST	0.030	158.40
WASHINGTON COUNTY	PLAINFIELD	TH-2	BROOK RD	1.398	7,381.44
WASHINGTON COUNTY	PLAINFIELD	TH-3	MAIN ST	0.180	950.40
WASHINGTON COUNTY	WOODBURY	TH-1	FOSTER HILL RD	0.300	1,584.00
WASHINGTON COUNTY	WOODBURY	TH-2	CABOT RD	0.380	2,006.40
WASHINGTON COUNTY SHEET 2 TOTAL				17.634	93,107.52
WASHINGTON COUNTY SHEET 1 TOTAL				47.610	251,380.80
WASHINGTON COUNTY SHEET 2 TOTAL				17.634	93,107.52
WASHINGTON COUNTY TOTAL				65.244	344,488.32

SEGMENT LENGTH IS PROVIDED FOR INFORMATIONAL PURPOSES ONLY. THESE LENGTHS REPRESENT ROAD CENTERLINE LENGTH AND SHALL NOT BE USED FOR MEASURING QUANTITIES FOR PAYMENT.

PROJECT NAME:	STATEWIDE NORTHEAST REGION
PROJECT NUMBER:	STPG MARK(310)
FILE NAME: +17+062 Class 2.dgn	PLOT DATE: 2/13/2018
PROJECT LEADER: P. COBURN	DRAWN BY: M. BOGACZYK
DESIGNED BY: M. BOGACZYK	CHECKED BY: P. COBURN
CLASS 2 TH QUANTITY SHEET 10	SHEET 18 OF 18