

**INDEX OF SHEETS**

- 1 TITLE SHEET
- 2 QUANTITY SHEET
- 3 TRAFFIC CONTROL PLAN
- 4 MISCELLANEOUS DETAILS SHEET
- 5-7 ROAD QUANTITY SHEETS 1-3
- 8 ROAD SUMMARY SHEET
- 9-17 CLASS 2 TOWN HIGHWAY QUANTITIES SHEET 1-9

**VTRANS STANDARDS**

E-192	PAVEMENT MARKING DETAILS	10/12/2000
E-193	PAVEMENT MARKING DETAILS	08/18/1995
T-1	TRAFFIC CONTROL GENERAL NOTES	04/25/2016
T-11	CONSTRUCTION APPROACH SIGNING DIVIDED HIGHWAY ONE LANE CLOSED	08/06/2012
T-12	TRAFFIC CONTROL DIVIDED HIGHWAY ONE LANE CLOSED	08/06/2012
T-22	TRAFFIC CONTROL FOR PAVEMENT MARKING ON DIVIDED HIGHWAY	08/06/2012
T-23	TRAFFIC CONTROL FOR PAVEMENT MARKING ON DIVIDED HIGHWAY	08/06/2012
T-24	TRAFFIC CONTROL FOR MAINTENANCE PAVEMENT MARKING OPERATION	08/06/2012
T-28	CONSTRUCTION SIGN DETAILS	08/06/2012
T-29	CONSTRUCTION SIGN DETAILS	08/06/2012
T-31	CONSTRUCTION SIGN DETAILS	08/06/2012


# STATE OF VERMONT AGENCY OF TRANSPORTATION



## PROPOSED IMPROVEMENT STATEWIDE - SOUTHWEST REGION VARIOUS FUNCTIONAL CLASSIFICATIONS OF STATE ROADS, CLASS 1 & CLASS 2 TOWN HIGHWAYS

APPLICATION OF CENTER LINE, EDGE LINE AND LANE LINE MARKINGS ON NATIONAL HIGHWAY AND STATE SYSTEM ROADS. APPLICATION OF CENTER LINE MARKINGS ONLY ON CLASS 1 AND CLASS 2 TOWN HIGHWAYS WITHIN THE SOUTHWEST REGION (DISTRICT #1, DISTRICT #3).

LENGTH OF PROJECT 969.504 MI = 5,118,981.12 LF

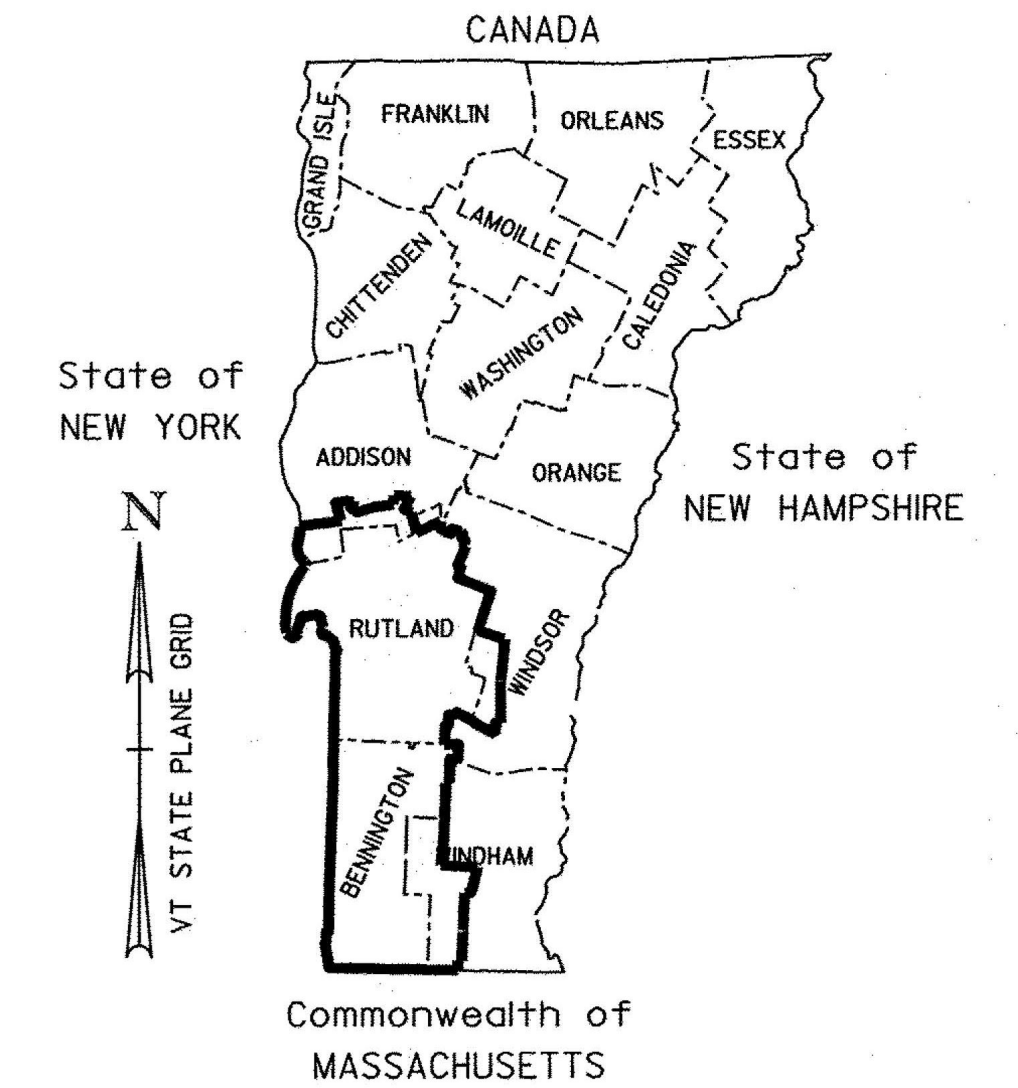

**Record Plans**



Contractor: HI-WAY SAFETY SYSTEMS, INC.  
Resident Engineer: JUDY GILMORE  
Construction Began: MAY 31, 2018  
Construction Complete: SEPTEMBER 28, 2019  
Record Plans By: JUDY GILMORE

I hereby certify that all construction required by this set of drawings has been accomplished as indicated herein.

E-SIGNED by Judy Gilmore  
on 2021-01-07 16:13:58 GMT Resident Engineer

Date: January 07, 2021

NOTE: Any further information concerning final quantities, amounts or other details relative to this project may be found at Central Files in the electronic archives.

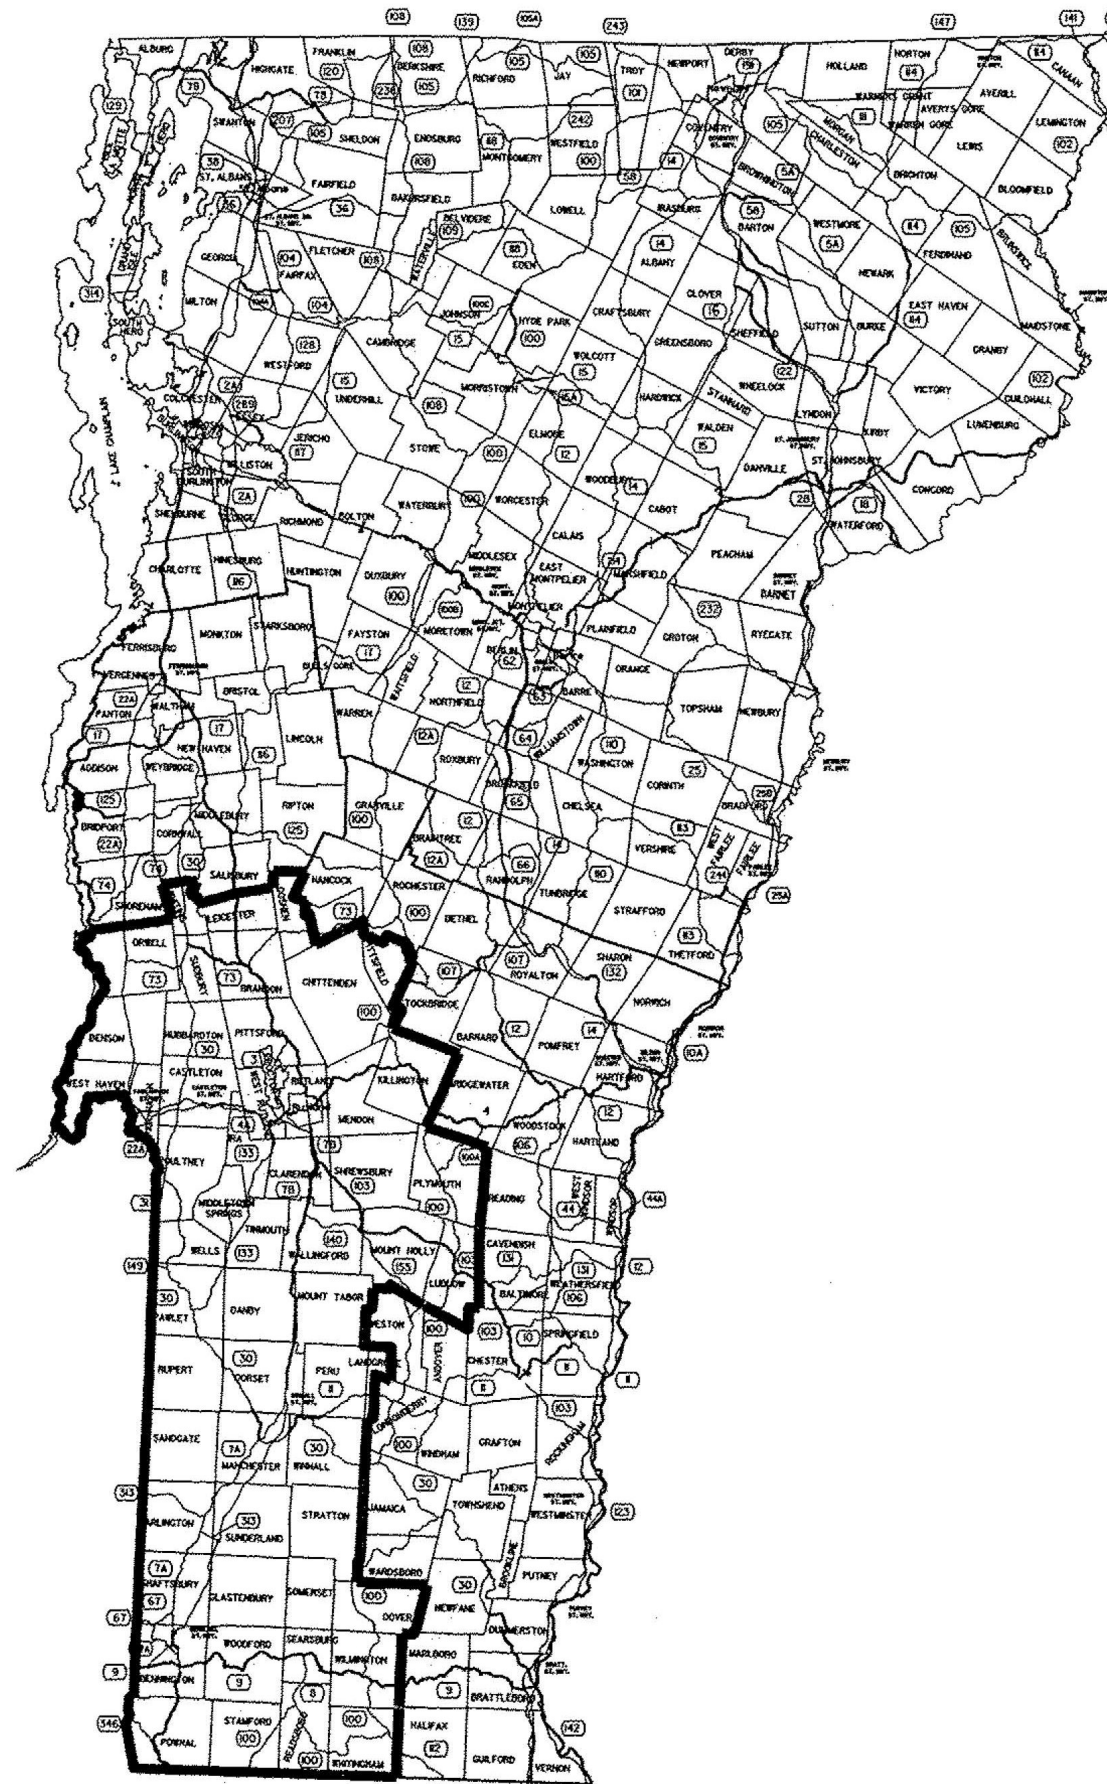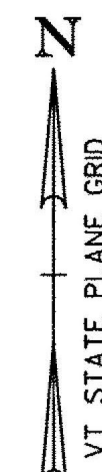

CONSTRUCTION IS TO BE CARRIED ON IN ACCORDANCE WITH THESE PLANS AND THE STANDARD SPECIFICATIONS FOR CONSTRUCTION DATED 2011, AS APPROVED BY THE FEDERAL HIGHWAY ADMINISTRATION ON JULY 20, 2011 FOR USE ON THIS PROJECT, INCLUDING ALL SUBSEQUENT REVISIONS AND SUCH REVISED SPECIFICATIONS AND SPECIAL PROVISIONS AS ARE INCORPORATED IN THESE PLANS.

QUALITY ASSURANCE PROGRAM : LEVEL 1	
SURVEYED BY :	N/A
SURVEYED DATE :	N/A
DATUM	
VERTICAL	N/A
HORIZONTAL	N/A

**Record Plans**

DIRECTOR OF PROJECT DELIVERY	
APPROVED <i>[Signature]</i>	DATE 2/16/2018
PROJECT MANAGER : PATRICIA COBURN P.E.	
PROJECT NAME : STATEWIDE-SOUTHWEST REGION	
PROJECT NUMBER : STPG MARK(313)	
SHEET 1 OF 17 SHEETS	