

INDEX OF SHEETS

1. TITLE SHEET
2. DETAIL SHEET
3. QUANTITY SHEET
4. CLRS LOCATIONS & INTERSECTION GAPS
5. LINE STRIPING LOCATIONS SHEET

VAOT STANDARD DRAWINGS

E-191 - PAVEMENT MARKING DETAILS	- 2/1/1999
E-192 - PAVEMENT MARKING DETAILS	- 10/12/2000
E-193 - PAVEMENT MARKING DETAILS	- 8/18/1995
T-1 - TRAFFIC CONTROL GENERAL NOTES	- 4/25/2016
T-10 - CONVENTIONAL ROADS CONSTRUCTION APPROACH SIGNING	- 8/6/2012
T-17 - TRAFFIC CONTROL MISCELLANEOUS DETAILS	- 8/6/2012
T-22 - TRAFFIC CONTROL FOR PAVEMENT MARKING ON DIVIDED HIGHWAY	- 8/6/2012
T-23 - TRAFFIC CONTROL FOR PAVEMENT MARKING ON DIVIDED HIGHWAY	- 8/6/2012
T-24 - TRAFFIC CONTROL FOR MAINTENANCE PAVEMENT MARKING OPERATION	- 8/6/2012
T-28 - CONSTRUCTION SIGN DETAILS	- 8/6/2012
T-29 - CONSTRUCTION SIGN DETAILS	- 8/6/2012
T-30 - CONSTRUCTION SIGN DETAILS	- 8/6/2012
T-31 - CONSTRUCTION SIGN DETAILS	- 8/6/2012
T-33 - MISCELLANEOUS SIGN DETAILS	- 8/6/2012

HIGHWAY SAFETY AND DESIGN SHEETS

HSD - 213.02 - MILLED RUMBLE STRIPS (CENTERLINE) - 9/28/2017

STATE OF VERMONT AGENCY OF TRANSPORTATION




PROPOSED IMPROVEMENT STATEWIDE COUNTIES OF BENNINGTON, RUTLAND, ADDISON CHITTENDEN, AND FRANKLIN US ROUTE 7

PROJECT LOCATION: BEGINNING IN THE TOWN OF POWNAL ON U.S. ROUTE 7 AT MM 0.000 AND EXTENDING NORTHERLY 176.328 MILES TO MM 6.209 IN THE TOWN OF HIGHGATE.

RUMBLE STRIP LENGTHS BY TOWN:				
POWNAL	3010	FEET	0.570	MILES
BENNINGTON	1262	FEET	0.239	MILES
SHAFTSBURY	28317	FEET	5.363	MILES
GLASTENBURY	9414	FEET	1.783	MILES
SUNDERLAND	34114	FEET	6.461	MILES
MANCHESTER	36749	FEET	6.960	MILES
DORSET	28118	FEET	5.325	MILES
MOUNT TABOR	20904	FEET	3.959	MILES
DANBY	10354	FEET	1.961	MILES
WALLINGFORD	13775	FEET	2.609	MILES
BRANDON	5512	FEET	1.044	MILES
CHARLOTTE	28673	FEET	5.430	MILES
SHELBURNE	2703	FEET	0.512	MILES
COLCHESTER	12530	FEET	4.190	MILES
MILTON	7434	FEET	2.373	MILES
GEORGIA	1072	FEET	0.203	MILES
ST. ALBANS TOWN	1320	FEET	0.250	MILES
SWANTON	1077	FEET	0.204	MILES
HIGHGATE	4367	FEET	0.827	MILES
	250700	FEET	47.481	MILES

PROJECT DESCRIPTION: THE PROJECT SHALL CONSIST OF THE INSTALLATION OF NEW 12" CENTERLINE RUMBLE STRIPS AND PAVEMENT MARKINGS.

END HES RMBL(4)
HIGHGATE (MM 6.209)

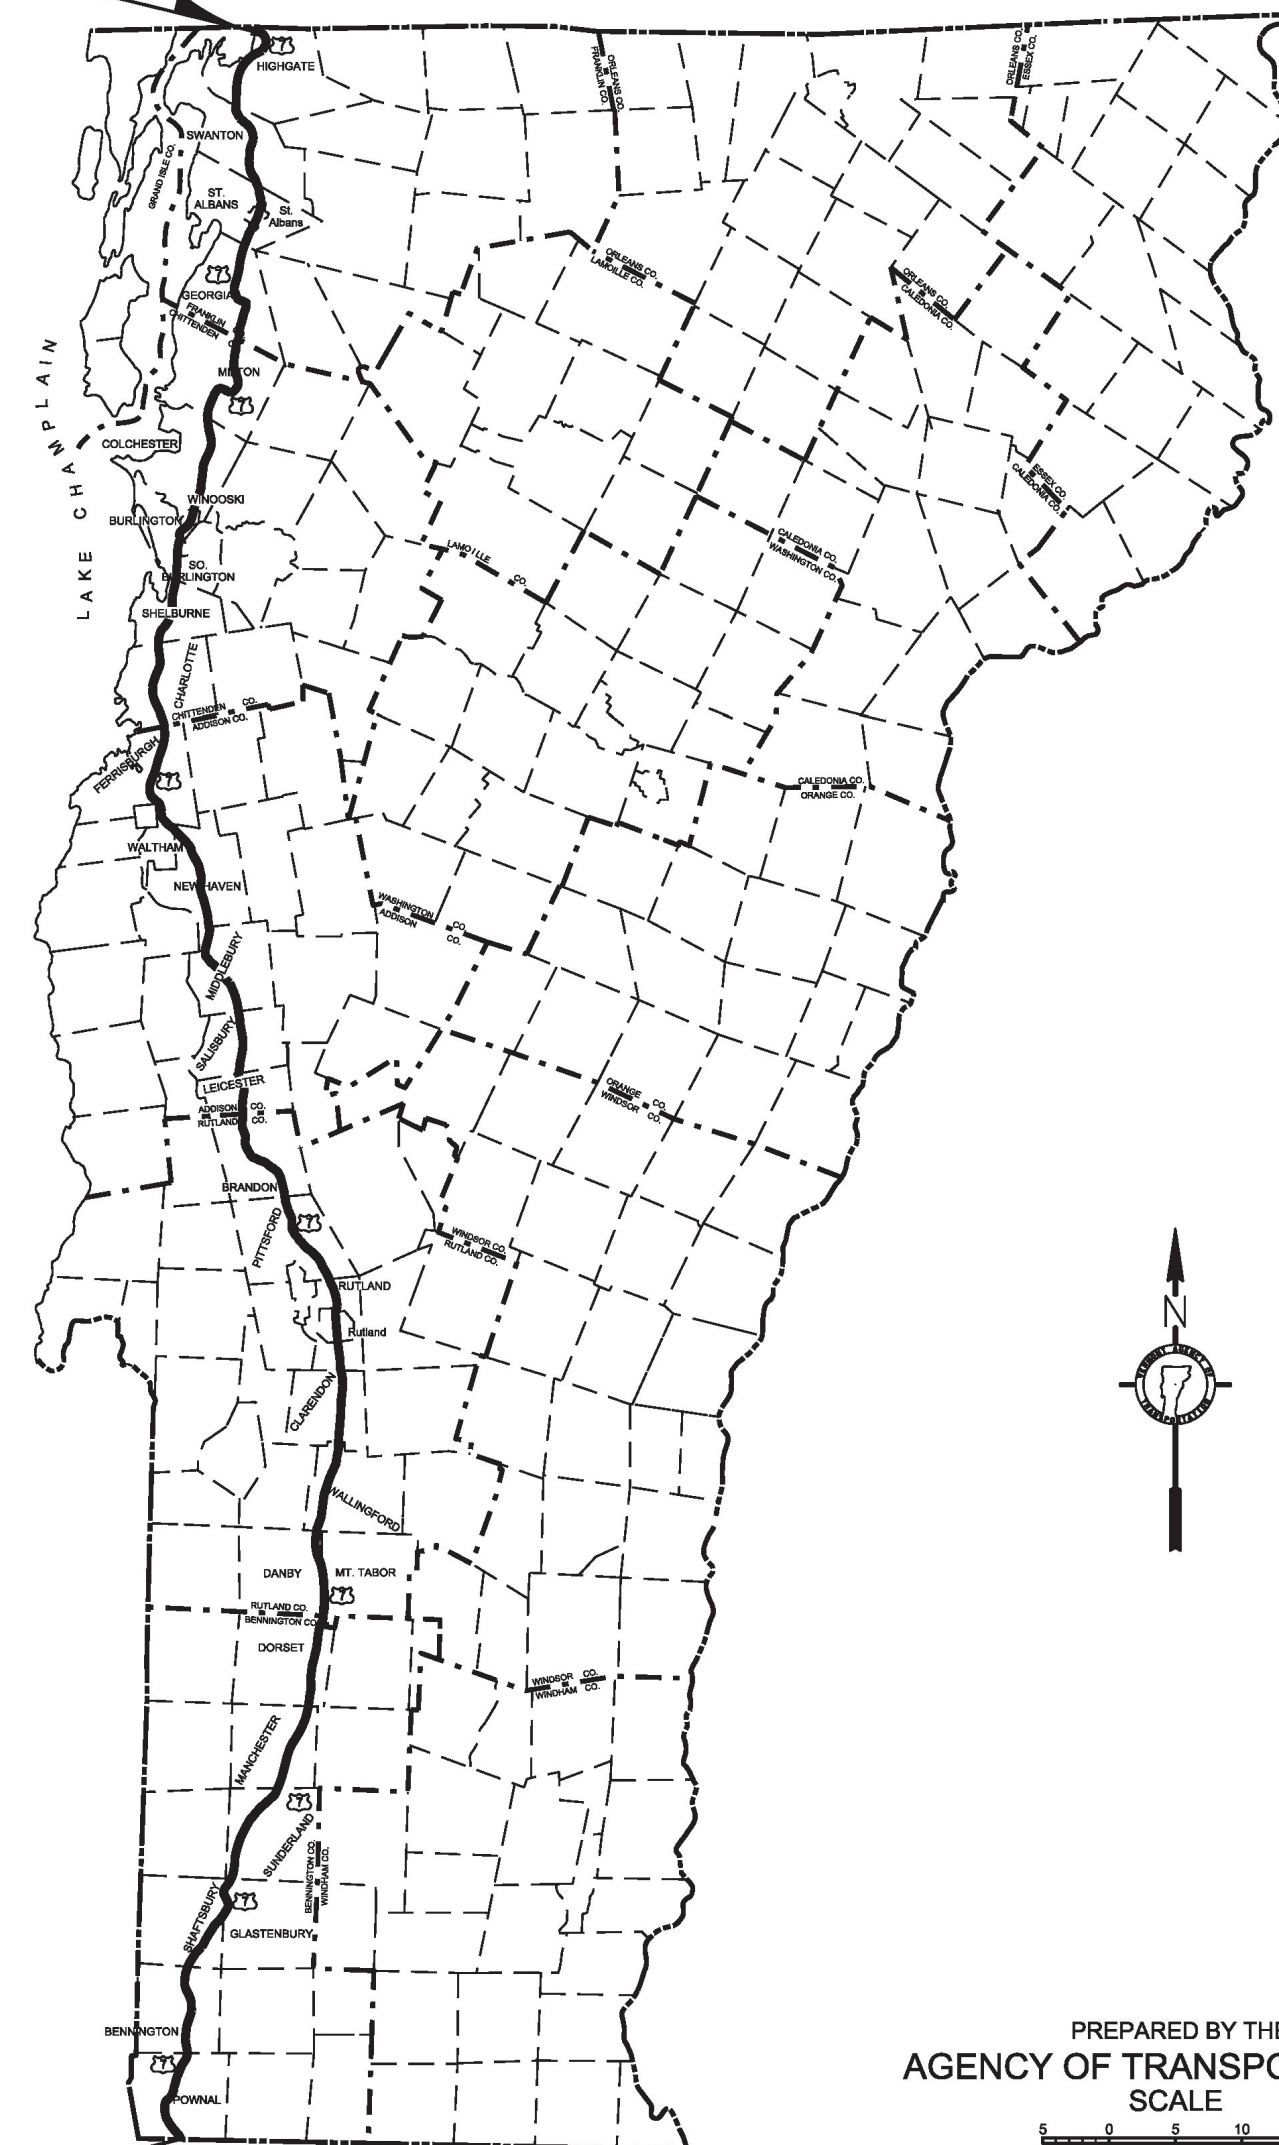

BEGIN HES RMBL(4)
POWNAL (MM 0.000)

Record Plans

Contractor: L & D SAFETY MARKING CORPORATION
Resident Engineer: CHRIS LAVALETTE
Construction Began: SEPTEMBER 6, 2018
Construction Complete: AUGUST 1, 2019
Record Plans By: CHRIS LAVALETTE & JESSE IVES

I hereby certify that all construction required by this set of drawings has been accomplished as indicated herein.

E-SIGNED by Chris Lavalette
on 2020-02-27 19:42:52 GMT Resident Engineer

Date: February 27, 2020

NOTE: Any further information concerning final quantities, amounts or other details relative to this project may be found at Central Files in the electronic archives.

CONSTRUCTION IS TO BE CARRIED ON IN ACCORDANCE WITH THESE PLANS AND THE STANDARD SPECIFICATION FOR CONSTRUCTION DATES 2011, AS APPROVED BY THE FEDERAL HIGHWAY ADMINISTRATION ON JULY 20, 2011 FOR USE ON THIS PROJECT, INCLUDING ALL SUBSEQUENT REVISIONS AND SUCH REVISED SPECIFICATION AND SPECIAL PROVISIONS AS ARE INCORPORATED IN THESE PLANS.

QUALITY ASSURANCE PROGRAM: LEVEL 1	
SURVEYED BY:	N/A
SURVEYED DATE:	N/A
DATUM	
VERTICAL	N/A
HORIZONTAL	N/A

DIRECTOR OF PROJECT DELIVERY	
APPROVED	<u>Kenneth A. Robie</u> DATE <u>Jun 25, 2018</u>
PROJECT MANAGER:	MATTHEW BOGACZYK
PROJECT NAME:	STATEWIDE
PROJECT NUMBER:	HES RMBL(4)
SHEET 1 OF 5 SHEETS	