

**Record Plans**  
 Contractor: **PIKE INDUSTRIES, INC.**  
 Resident Engineer: **THOMAS A. CHASE**  
 Construction Began: **07/12/2018**  
 Construction Complete: **07/24/2019**  
 Record Plans By: **THOMAS A. CHASE**

I hereby certify that all construction required by this set of drawings has been accomplished as indicated herein.

E-SIGNED by Thomas Chase  
 on 2020-01-13 16:25:10 GMT Resident Engineer

Date: January 13, 2020

NOTE: Any further information concerning final quantities, amounts or other details relative to this project may be found at Central Files in the electronic archives.

# STATE OF VERMONT AGENCY OF TRANSPORTATION



## COMPOSITE PROPOSED IMPROVEMENT TOWNS OF CAVENDISH, READING, WEATHERSFIELD, WEST WINDSOR AND WINDSOR COUNTY OF WINDSOR

### VERMONT ROUTE 44, 44A & 106 (MAJOR COLLECTORS)

READING-WINDSOR  
 STP FPAV(II)  
 VT ROUTE 44  
 SHEET #9

BEGINNING AT THE VT. ROUTE 106/VT. ROUTE 44 INTERSECTION  
 (MM 0.000) IN THE TOWN OF READING AND EXTENDING  
 APPROXIMATELY 6.853 MILES EASTERLY ALONG  
 VT. ROUTE 44 TO MM 1.607 IN THE TOWN OF WINDSOR.

LENGTH OF ROADWAY = 6.853 MILES (36,183.84 FEET)  
 LENGTH OF PROJECT = 6.853 MILES (36,183.84 FEET)

WEATHERSFIELD-READING  
 STP FPAV(II)  
 VT ROUTE 106  
 SHEET #26

BEGINNING ON VT. ROUTE 106 IN WEATHERSFIELD AT  
 MM 4.290 AND EXTENDING NORTHERLY ALONG  
 VT. ROUTE 106 A DISTANCE OF 10.624 MILES  
 (56,189.76 FT) TO MM 7.277 IN THE TOWN OF READING.

LENGTH OF ROADWAY = 10.624 MILES (56,189.76 FT)  
 LENGTH OF PROJECT = 10.624 MILES (56,189.76 FT)



WEATHERSFIELD-WINDSOR  
 STP FPAV(III)  
 VT ROUTE 44A  
 SHEET #37

BEGINNING AT THE U.S. ROUTE 5 AND VT. ROUTE 44A  
 INTERSECTION (MM 0.000) IN THE TOWN OF WEATHERSFIELD  
 AND EXTENDING NORTHERLY APPROXIMATELY 2.994 MILES  
 ALONG VT. ROUTE 44A TO MM 2.493 AT THE INTERSECTION  
 OF VT. ROUTE 44A AND VT. ROUTE 44 IN THE TOWN OF WINDSOR.

LENGTH OF ROADWAY = 2.994 MILES (15,808.32 FEET)  
 LENGTH OF PROJECT = 2.994 MILES (15,808.32 FEET)

TOTAL LENGTH OF PROJECTS = 20.471 MILES (108,086.880 FEET)

WORK TO BE PERFORMED UNDER THESE PROJECTS INCLUDES PAVING THE EXISTING  
 HIGHWAY, GUARDRAIL, PAVEMENT MARKINGS AND OTHER HIGHWAY RELATED ITEMS.

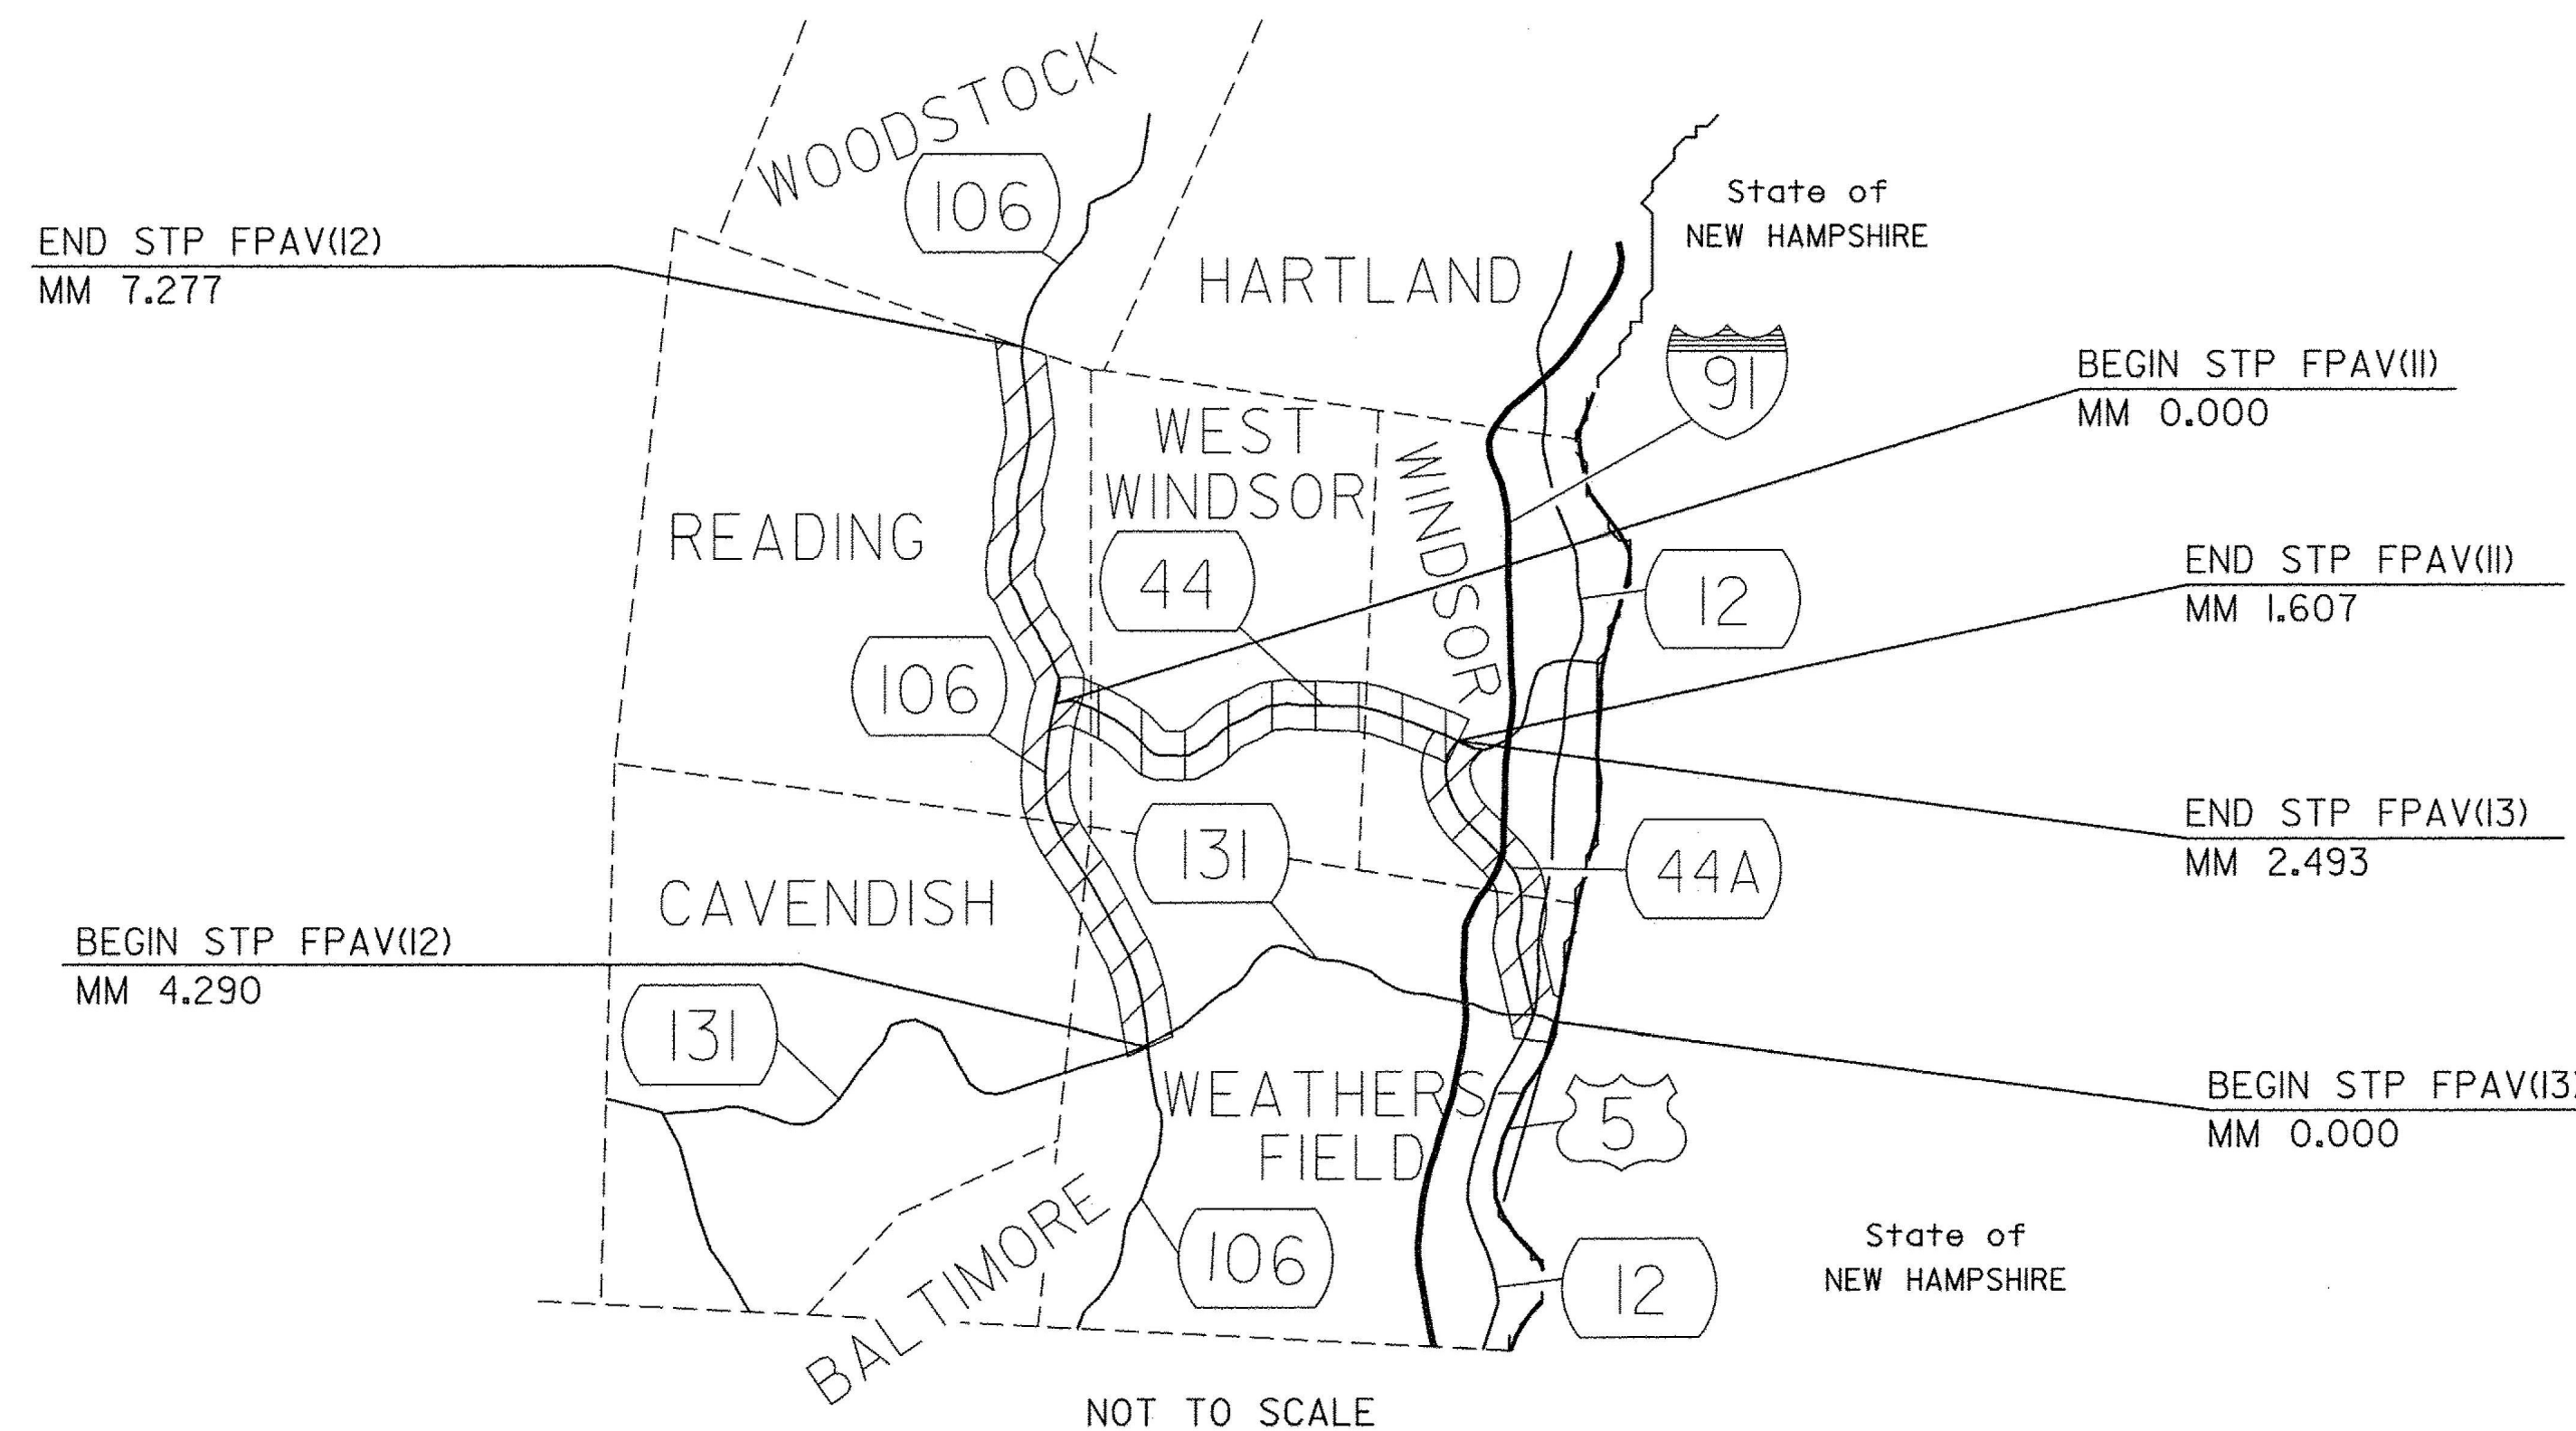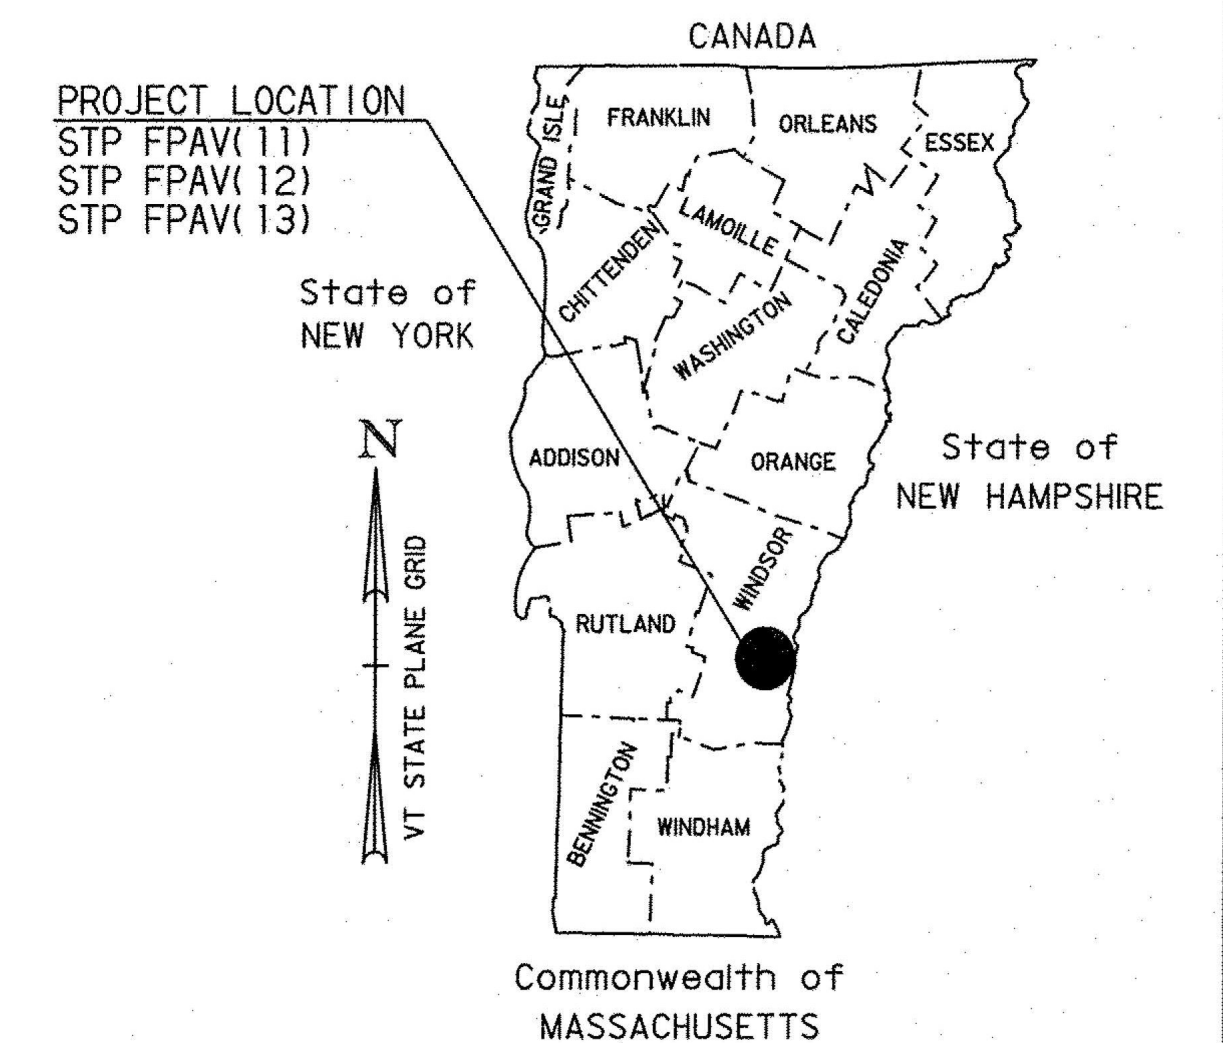


NOT TO SCALE

CONSTRUCTION IS TO BE CARRIED ON IN ACCORDANCE  
 WITH THESE PLANS AND THE STANDARD SPECIFICATIONS  
 FOR CONSTRUCTION DATED 2011, AS APPROVED BY THE  
 FEDERAL HIGHWAY ADMINISTRATION ON JULY 20, 2011  
 FOR USE ON THIS PROJECT, INCLUDING ALL SUBSEQUENT  
 REVISIONS AND SUCH REVISED SPECIFICATIONS AND  
 SPECIAL PROVISIONS AS ARE INCORPORATED IN THESE  
 PLANS.

QUALITY ASSURANCE PROGRAM : LEVEL 3

SURVEYED BY : N/A  
 SURVEYED DATE : N/A

DATUM  
 VERTICAL : N/A  
 HORIZONTAL : N/A

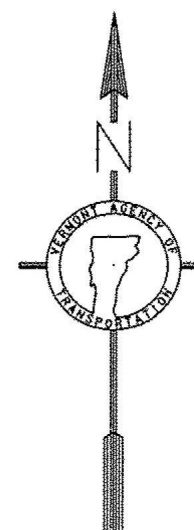

DIRECTOR OF PROJECT DELIVERY	
APPROVED <i>[Signature]</i>	DATE 3/29/2018
PROJECT MANAGER : BRANDON W. KIPP, P.E.	
PROJECT NAME : READING-WINDSOR, WEATHERSFIELD-READING & WEATHERSFIELD-WINDSOR	
PROJECT NUMBER : STP FPAV (II) , STP FPAV (III) & STP FPAV (I3)	
SHEET 1	OF 53 SHEETS