



TEMPORARY 4 INCH WHITE LINE, PAINT &
 DURABLE 4 INCH WHITE LINE (OPTION BID ITEM)
 (ALL LINES WILL INCLUDE EDGE LINE BREAKS AND
 RADIUS FOR TOWN HIGHWAYS)
 READING:
 MM 0.003 - MM 0.202 SOLID LT & RT
 WEST WINDSOR:
 WW MM 0.000 - WW MM 0.800 SOLID LT & RT

TEMPORARY 4 INCH YELLOW LINE, PAINT &
 DURABLE 4 INCH YELLOW LINE (OPTION BID ITEM)
 (ALL LINES WILL INCLUDE C/L BREAKS FOR
 TOWN HIGHWAYS)
 READING:
 MM 0.003 - MM 0.202 SOLID LT & RT
 WEST WINDSOR:
 WW MM 0.000 - WW MM 0.800 SOLID LT & RT

TEMPORARY LETTER OR SYMBOL, PAINT
 DURABLE LETTER OR SYMBOL (OPTION BID ITEM)
 READING:
 MM 0.003 LT - "STOP"
 MM 0.135 LT - "AHEAD"
 MM 0.149 LT - "STOP"

TEMPORARY 24 INCH STOP BAR, PAINT
 DURABLE 24 INCH STOP BAR (OPTION BID ITEM)
 READING:
 MM 0.003 LT

CHANGING ELEVATION OF DROP INLETS,
 CATCH BASINS, OR MANHOLES
 READING:
 MM 0.129 RT
 MM 0.156 RT

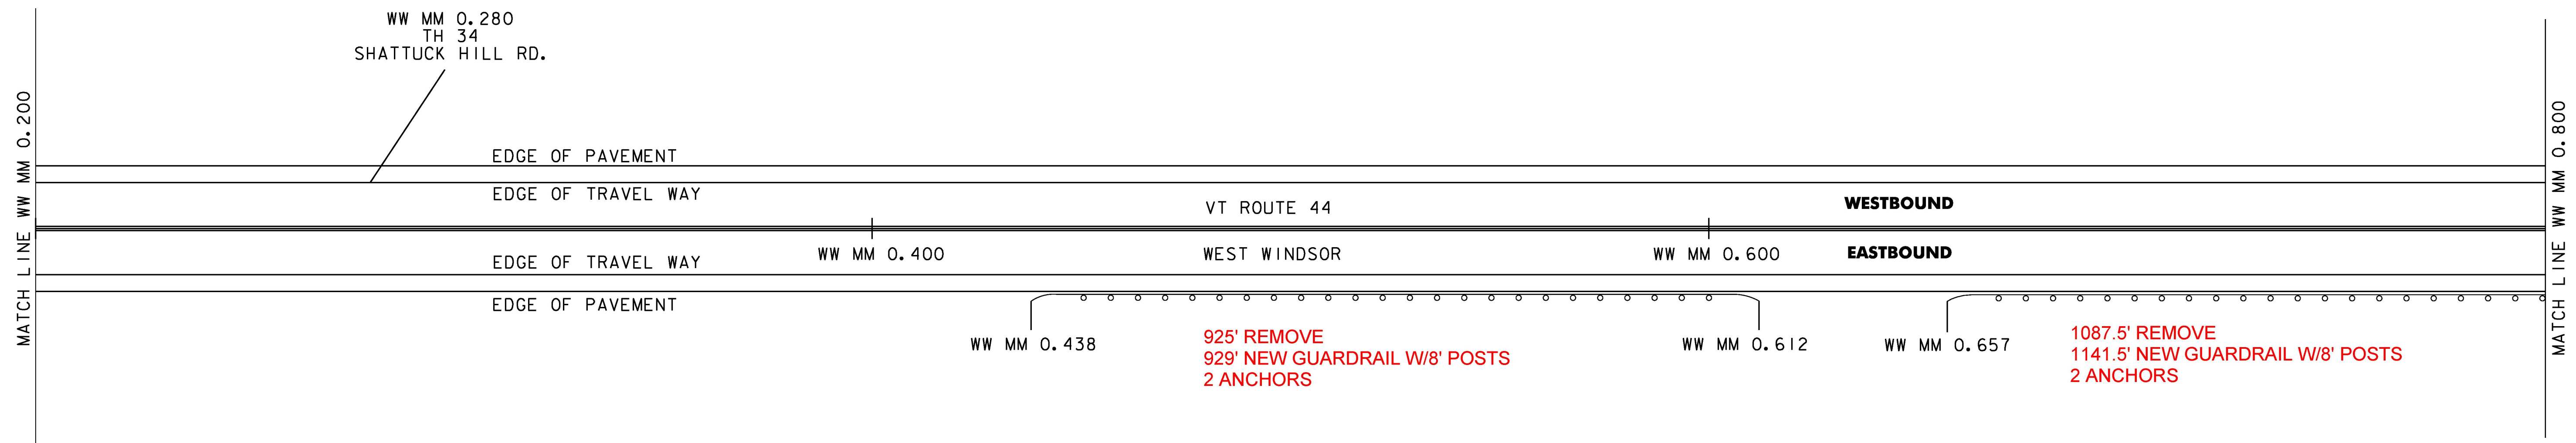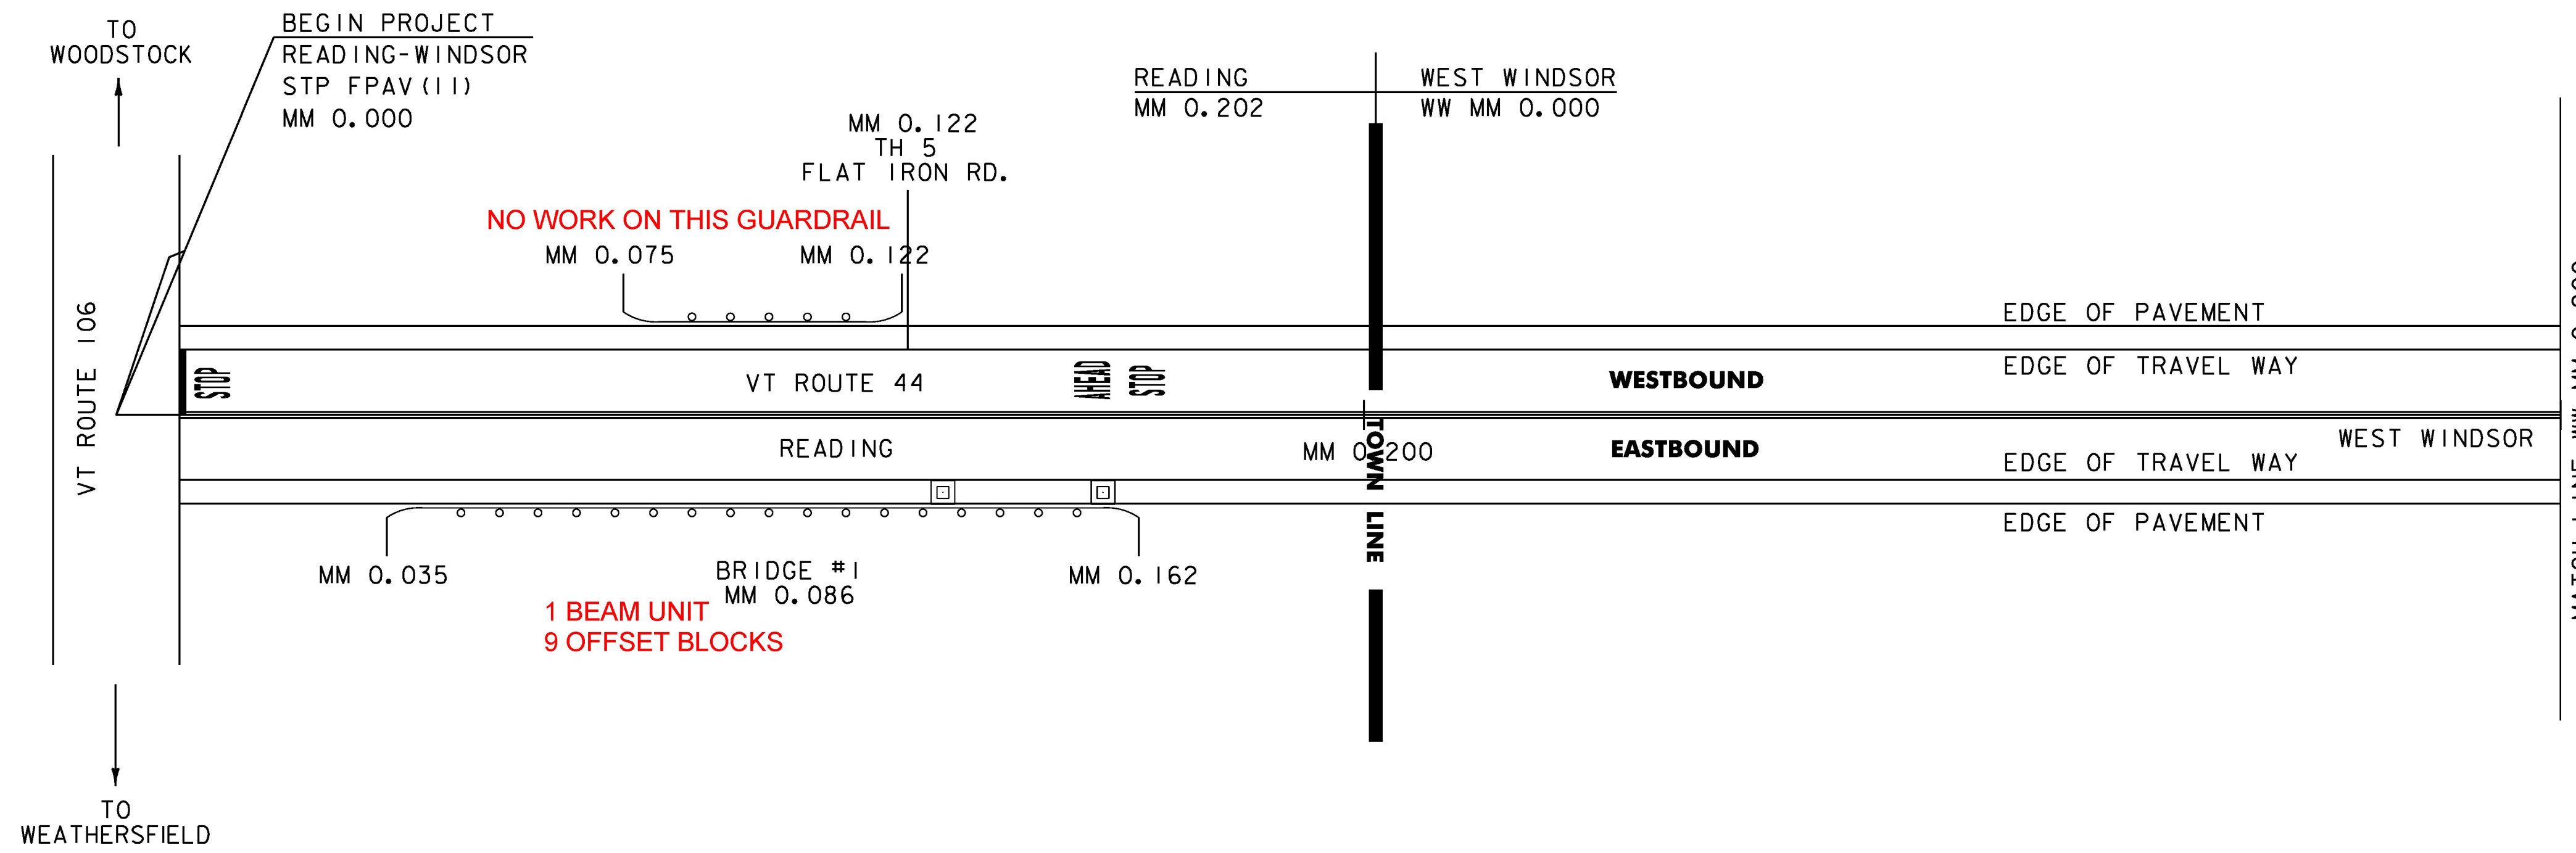

NOT TO SCALE

PROJECT NAME:	READING-WINDSOR
PROJECT NUMBER:	STP FPAV(II)
FILE NAME: COMP, STP FPAV(II),(I2) & (I3).dgn	PLOT DATE: 04-APR-2018
PROJECT LEADER: B. KIPP	DRAWN BY: L. BULLOCK
DESIGNED BY: L. BULLOCK	CHECKED BY: B. KIPP
PLAN SHEET I	SHEET 19 OF 53