


TEMPORARY 4 INCH WHITE LINE, PAINT &  
 DURABLE 4 INCH WHITE LINE (OPTION BID ITEM)  
 (ALL LINES WILL INCLUDE EDGE LINE BREAKS AND  
 RADIUS FOR TOWN HIGHWAYS)  
 WEST WINDSOR:  
 WW MM 0.800 - WW MM 2.000 SOLID LT & RT

TEMPORARY 4 INCH YELLOW LINE, PAINT &  
 DURABLE 4 INCH YELLOW LINE (OPTION BID ITEM)  
 (ALL LINES WILL INCLUDE C/L BREAKS FOR  
 TOWN HIGHWAYS)  
 WEST WINDSOR:  
 WW MM 0.800 - WW MM 2.000 SOLID LT & RT

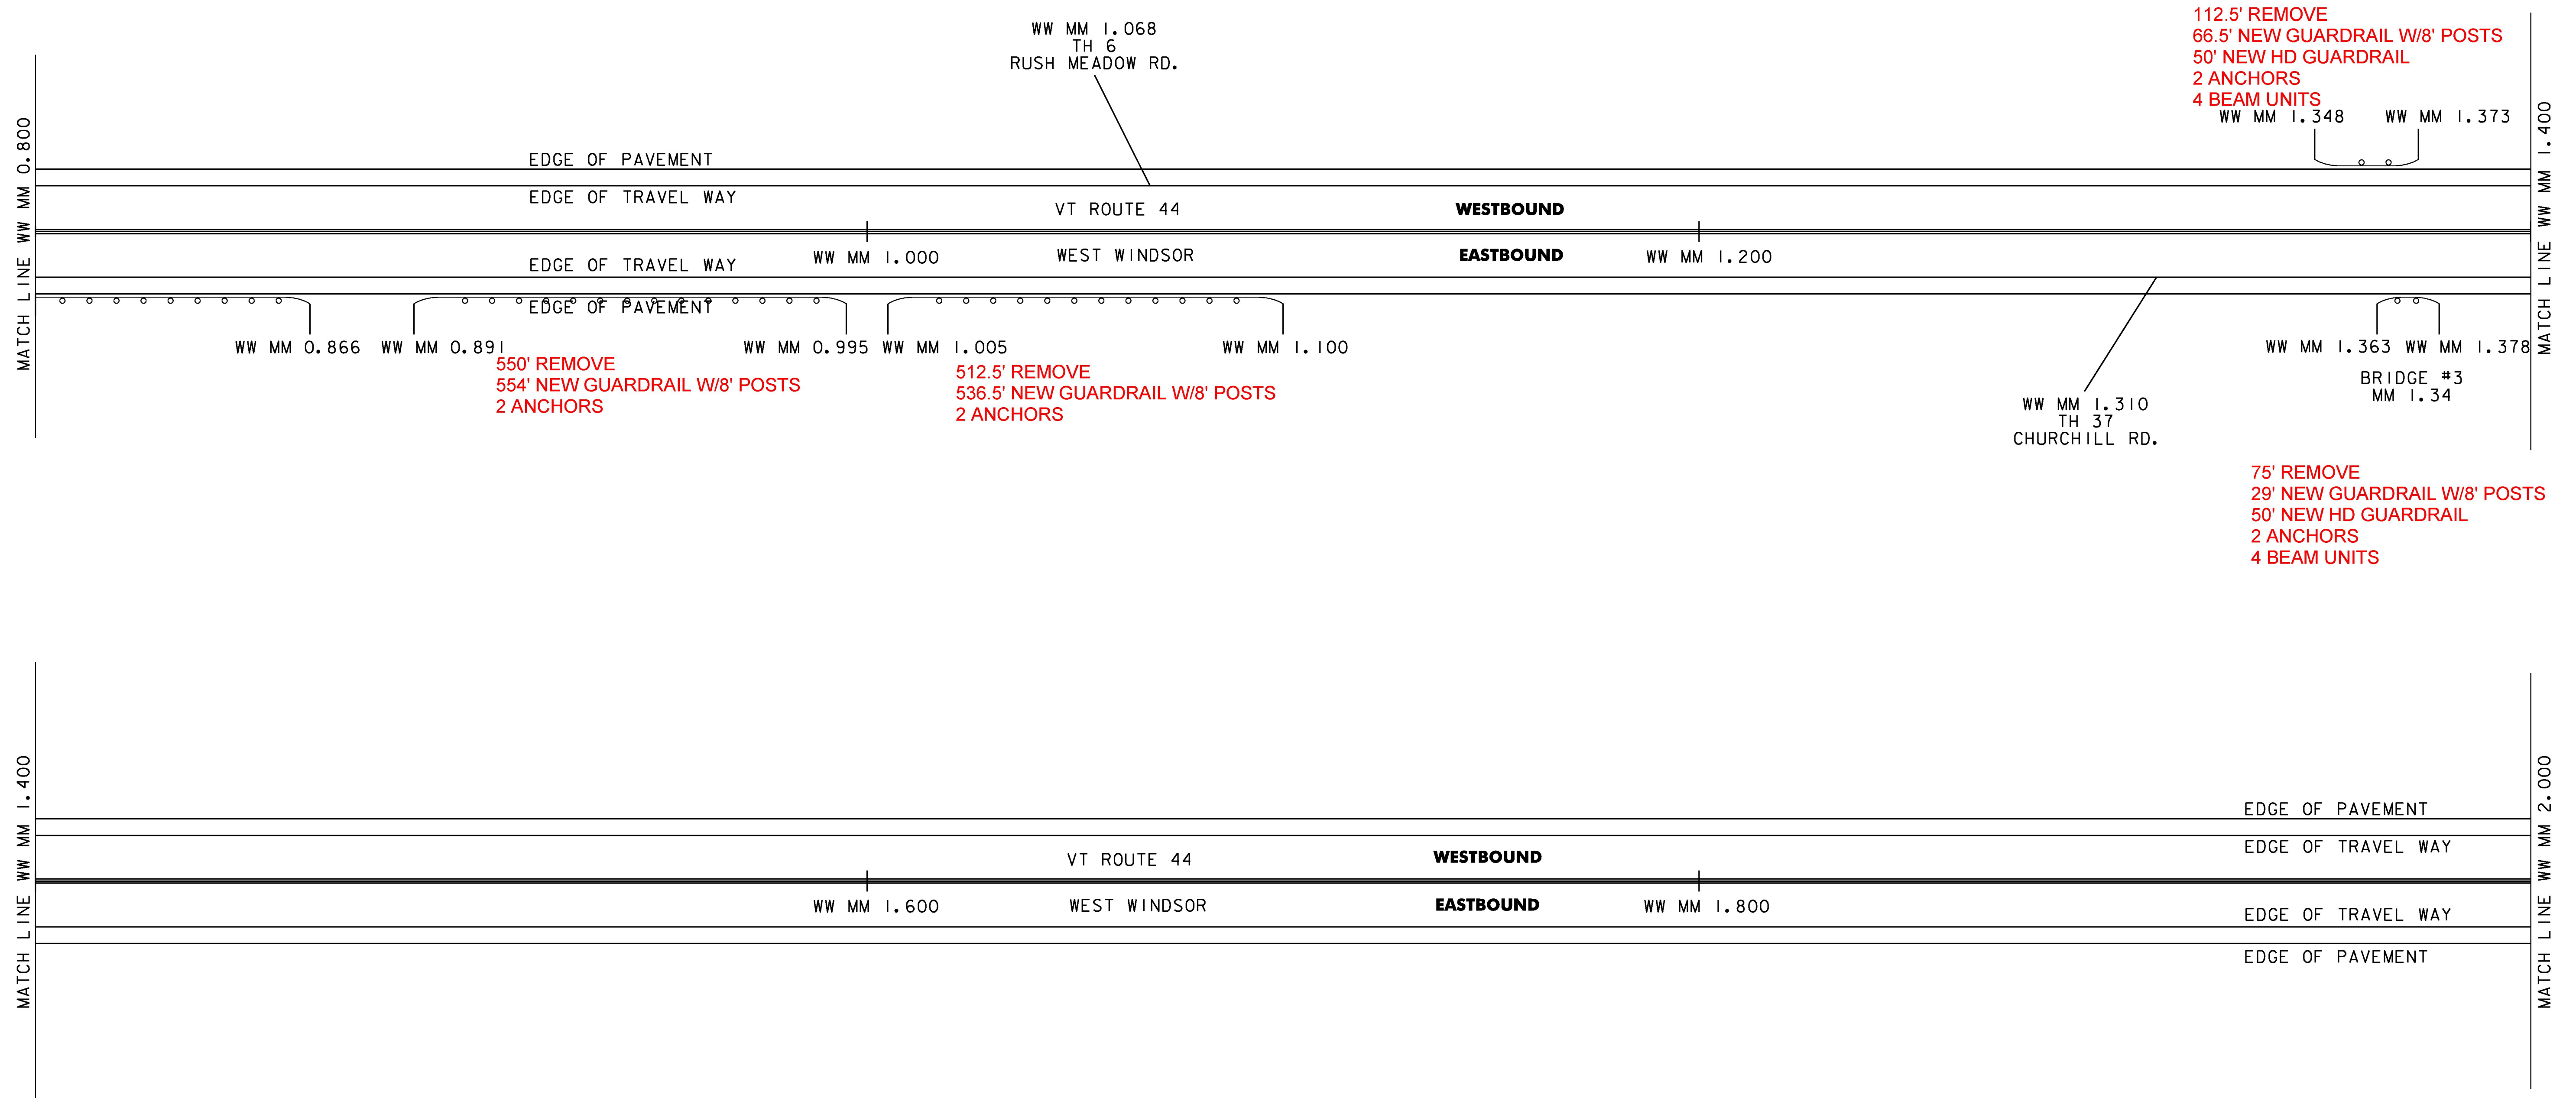

NOT TO SCALE

PROJECT NAME:	READING-WINDSOR
PROJECT NUMBER:	STP FPAV(II)
FILE NAME: COMP, STP FPAV(II),(I2) & (I3).dgn	PLOT DATE: 04-APR-2018
PROJECT LEADER: B. KIPP	DRAWN BY: L. BULLOCK
DESIGNED BY: L. BULLOCK	CHECKED BY: B. KIPP
PLAN SHEET 2	SHEET 20 OF 53