


CHANGING ELEVATION OF SEWER MANHOLES
(NON FED./STATE PARTICIPATING)
WEST WINDSOR:
WW MM 3.993 RT.
WW MM 4.024 RT.

TEMPORARY 4 INCH WHITE LINE, PAINT &
DURABLE 4 INCH WHITE LINE (OPTION BID ITEM)
(ALL LINES WILL INCLUDE EDGE LINE BREAKS AND
RADIUS FOR TOWN HIGHWAYS)
WEST WINDSOR:
WW MM 3.200 - WW MM 4.400 SOLID LT & RT

TEMPORARY 4 INCH YELLOW LINE, PAINT
DURABLE 4 INCH YELLOW LINE (OPTION BID ITEM)
(ALL LINES WILL INCLUDE C/L BREAKS FOR
TOWN HIGHWAYS)
WEST WINDSOR:
WW MM 3.200 - WW MM 4.400 SOLID LT & RT

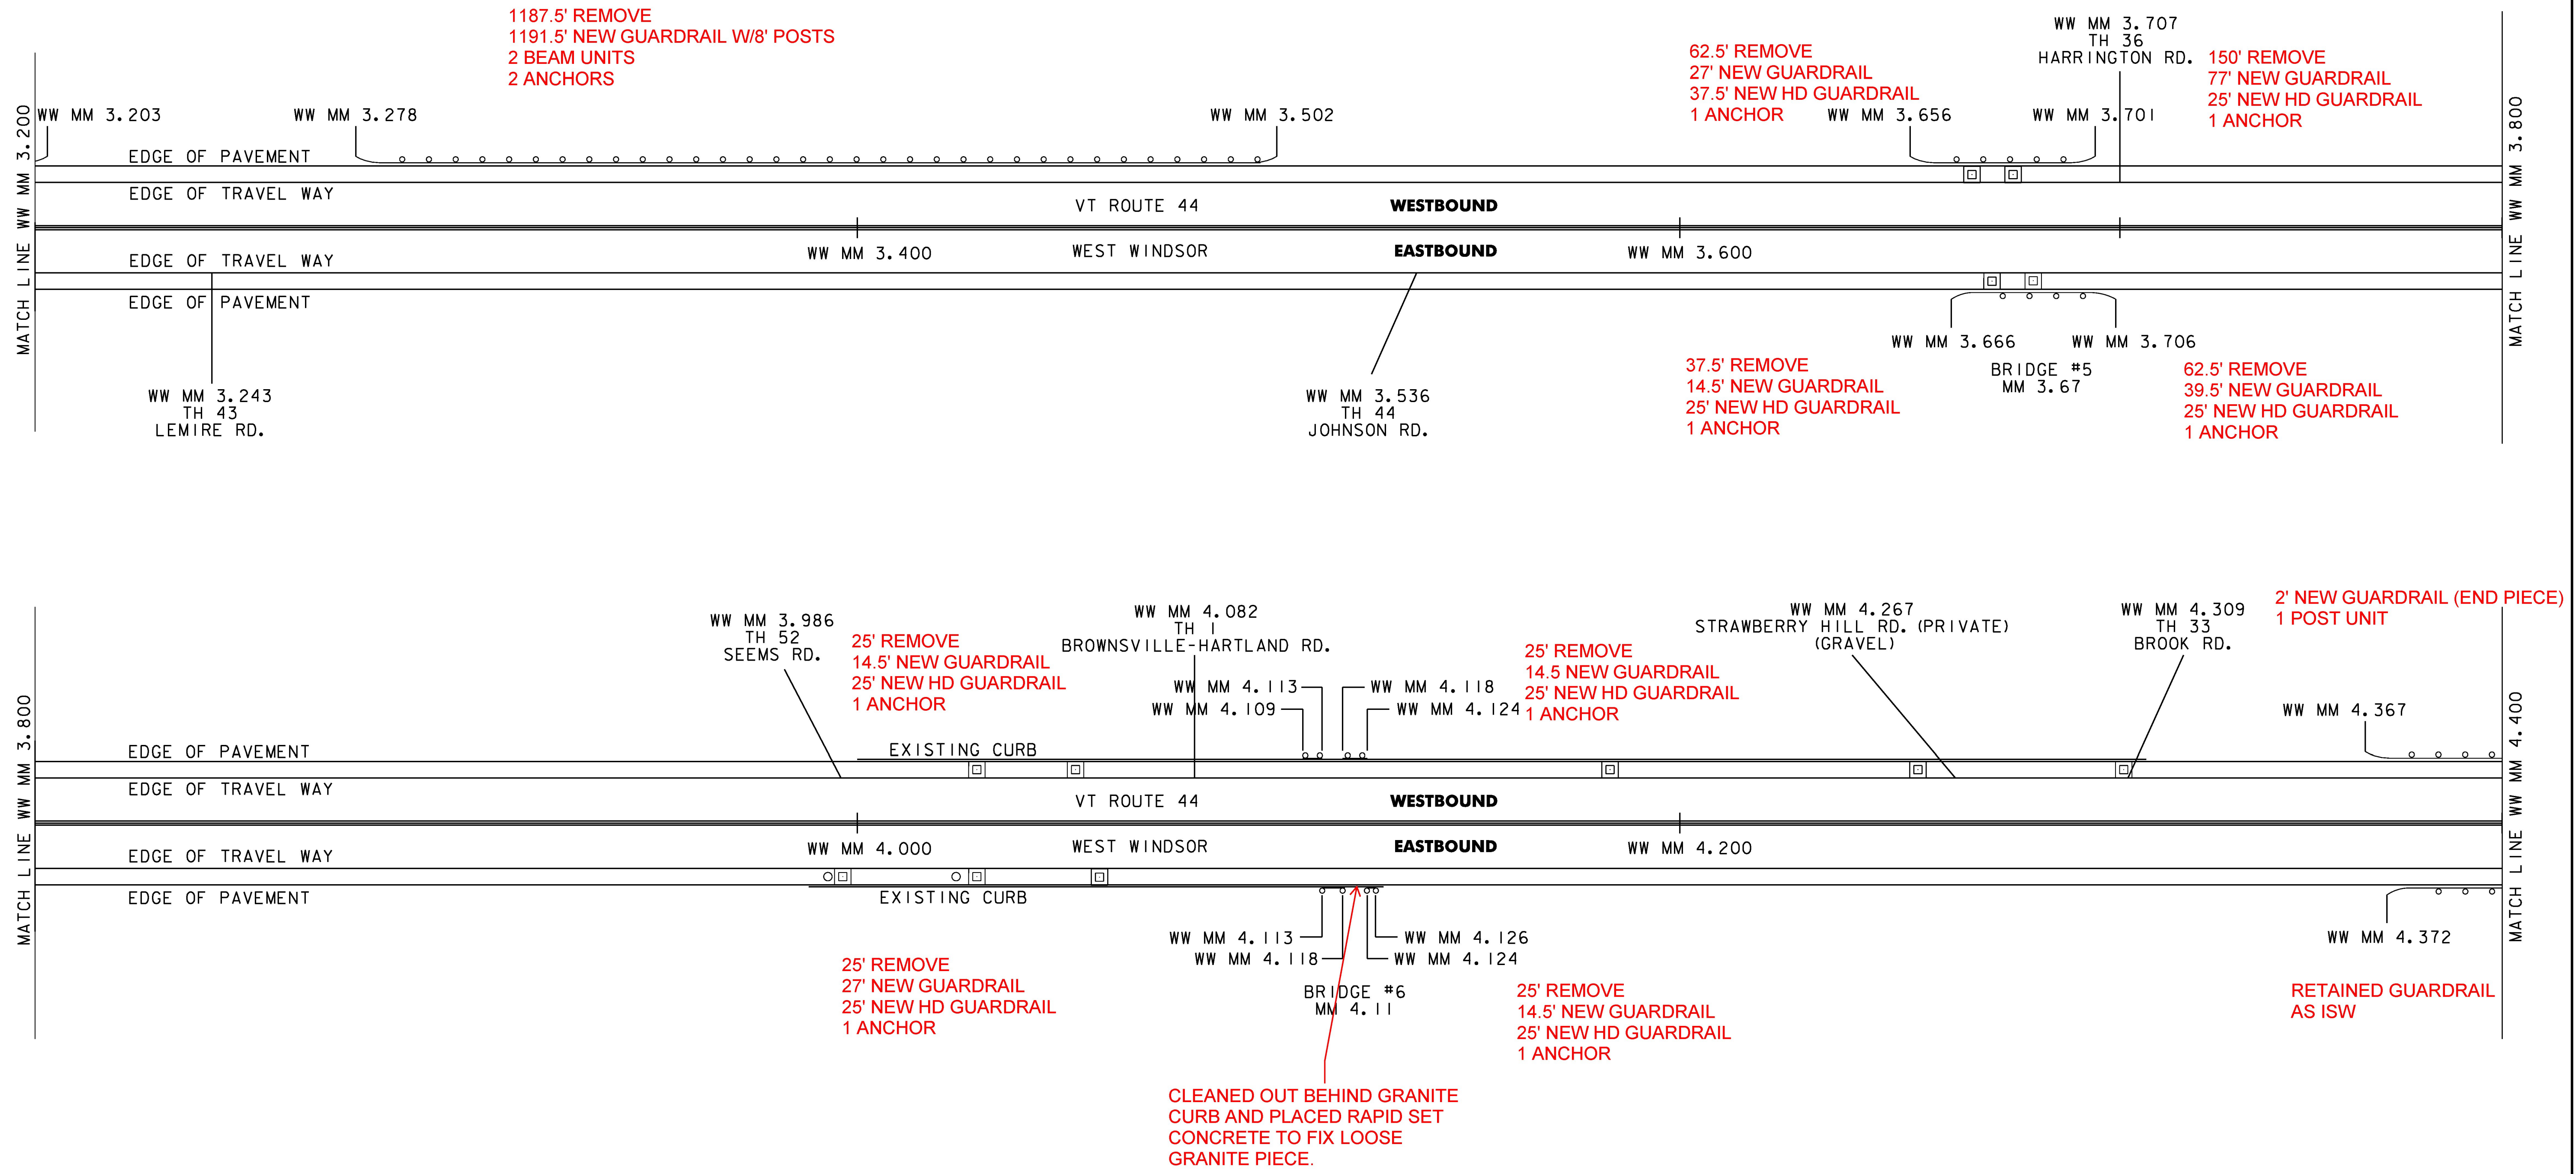

NOT TO SCALE

PROJECT NAME:	READING-WINDSOR
PROJECT NUMBER:	STP FPAV(II)
FILE NAME: COMP, STP FPAV(II),(I2) & (I3).dgn	PLOT DATE: 04-APR-2018
PROJECT LEADER: B. KIPP	DRAWN BY: L. BULLOCK
DESIGNED BY: L. BULLOCK	CHECKED BY: B. KIPP
PLAN SHEET 4	SHEET 22 OF 53