
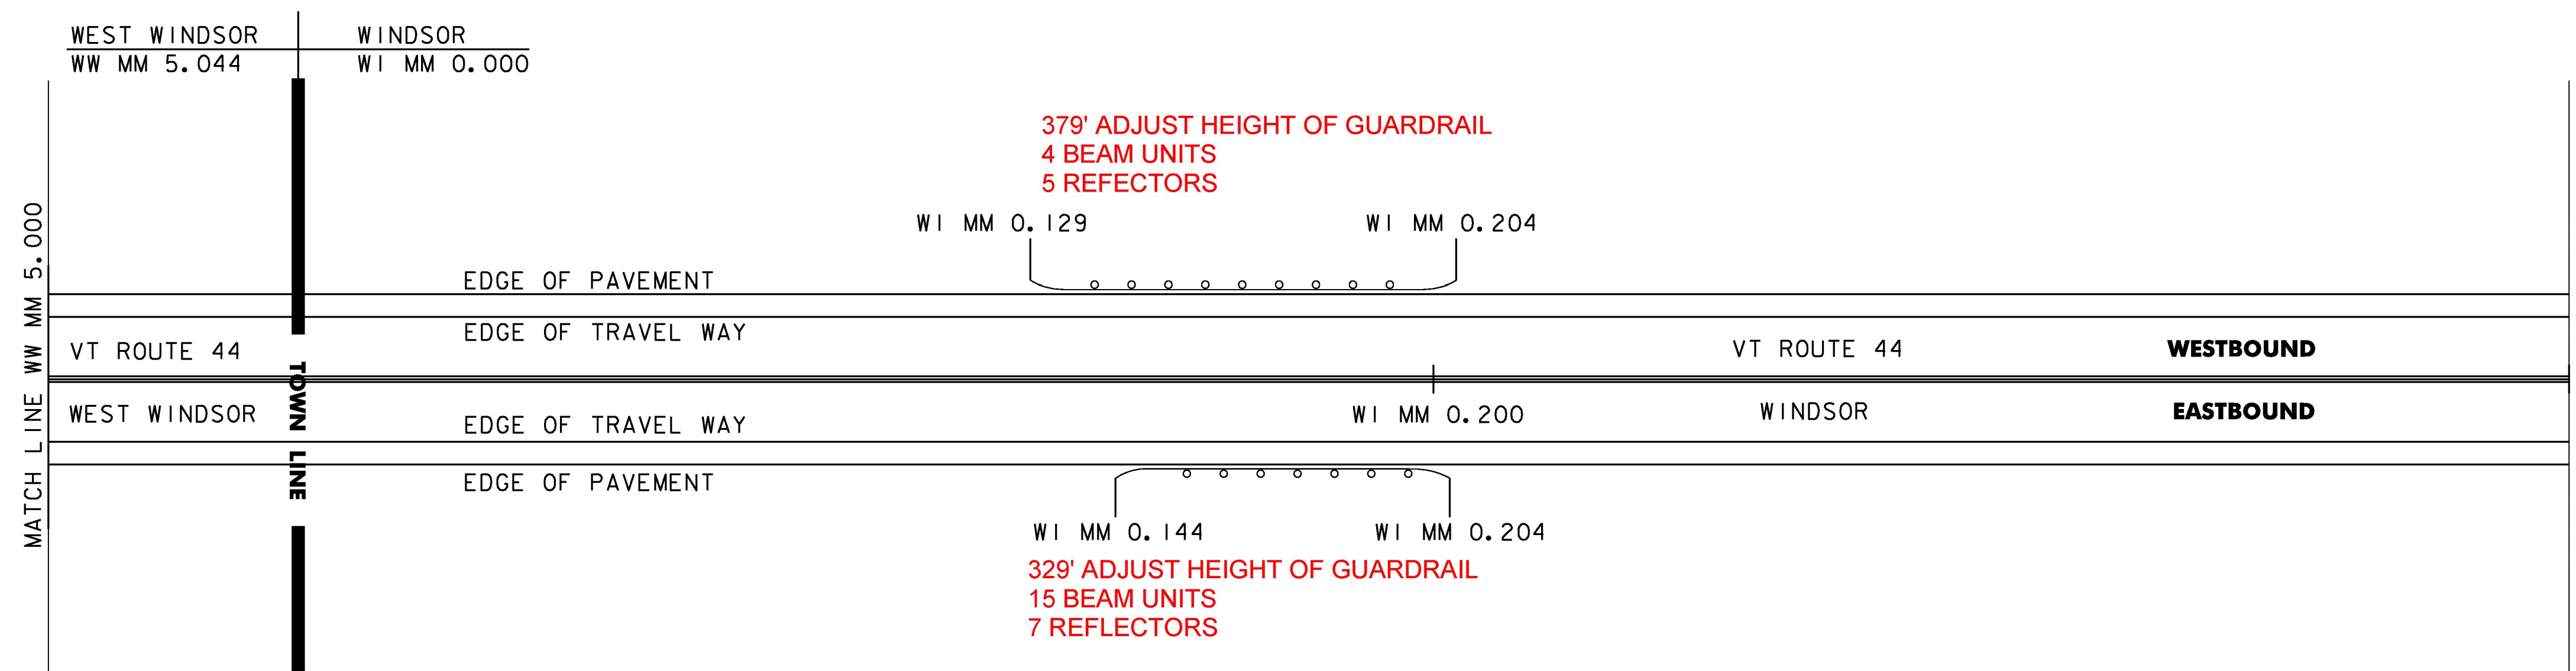


TEMPORARY 4 INCH WHITE LINE, PAINT &  
 DURABLE 4 INCH WHITE LINE (OPTION BID ITEM)  
 (ALL LINES WILL INCLUDE EDGE LINE BREAKS AND  
 RADIUS FOR TOWN HIGHWAYS)  
 WEST WINDSOR:  
 WW MM 4.400 - WW MM 5.044 SOLID LT  
 WW MM 4.400 - WW MM 4.616 SOLID RT  
 WW MM 4.616 - WW MM 4.633 DOTTED RT  
 WW MM 4.633 - WW MM 5.044 SOLID RT  
 WW MM 4.616 - WW MM 4.661 SOLID RT  
 WINDSOR:  
 WIMM 0.000 - WIMM 0.400 SOLID LT & RT

TEMPORARY 4 INCH YELLOW LINE, PAINT  
 DURABLE 4 INCH YELLOW LINE (OPTION BID ITEM)  
 (ALL LINES WILL INCLUDE C/L BREAKS FOR  
 TOWN HIGHWAYS)  
 WEST WINDSOR:  
 WW MM 4.400 - WW MM 5.044 SOLID LT & RT  
 WINDSOR:  
 WIMM 0.000 - WIMM 0.400 SOLID LT & RT

TEMPORARY LETTER OR SYMBOL, PAINT  
 DURABLE LETTER OR SYMBOL (OPTION BID ITEM)  
 WINDSOR:  
 MM 4.634 RT - "R"  
 MM 4.648 LT - "ONLY"  
 MM 4.661 LT - "R"

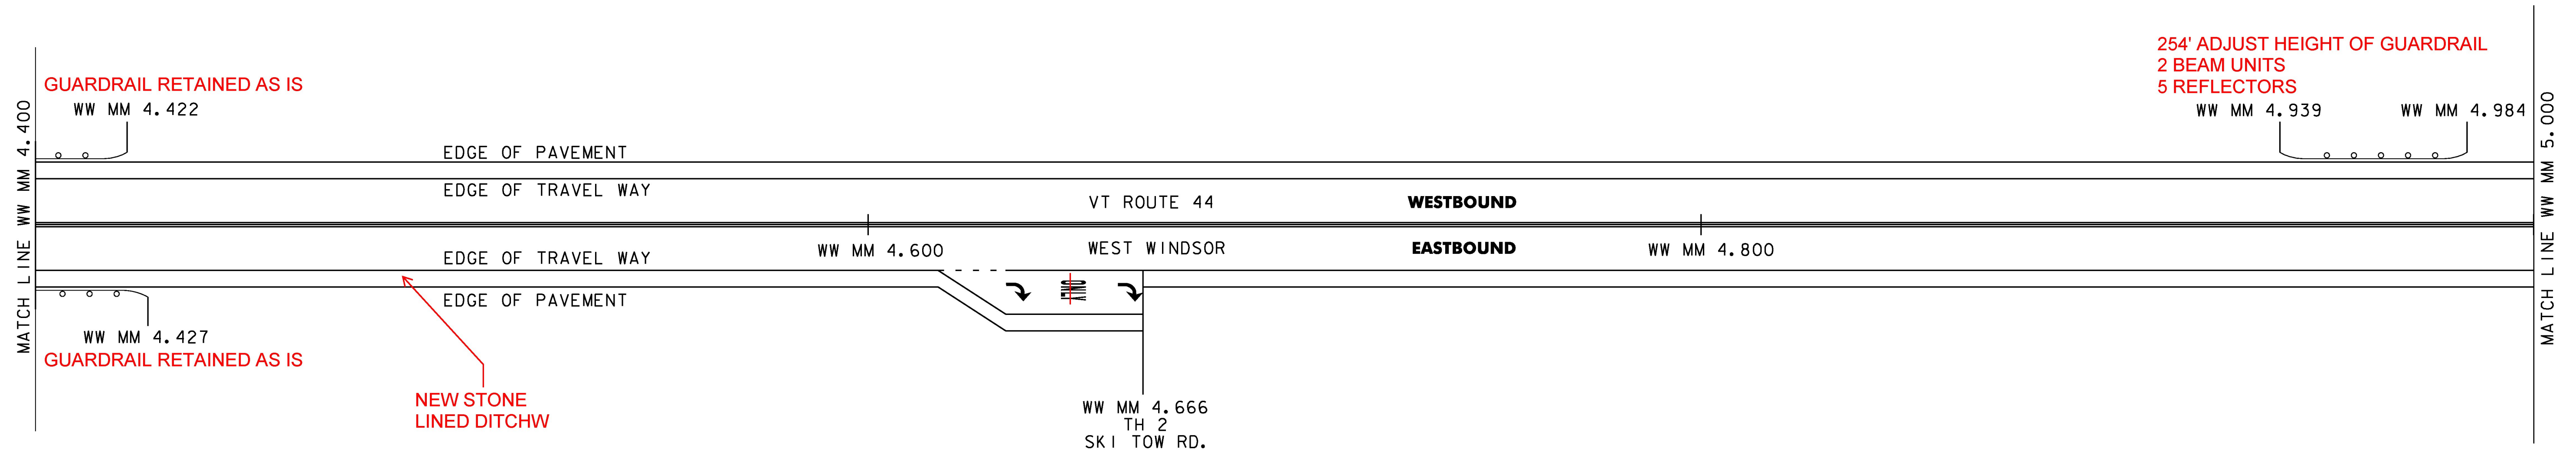

NOT TO SCALE

PROJECT NAME:	READING-WINDSOR
PROJECT NUMBER:	STP FPAV(II)
FILE NAME: COMP, STP FPAV(II),(I2) & (I3).dgn	PLOT DATE: 04-APR-2018
PROJECT LEADER: B. KIPP	DRAWN BY: L. BULLOCK
DESIGNED BY: L. BULLOCK	CHECKED BY: B. KIPP
PLAN SHEET 5	SHEET 23 OF 53