



TEMPORARY 4 INCH WHITE LINE, PAINT & DURABLE 4 INCH WHITE LINE (OPTION BID ITEM) (ALL LINES WILL INCLUDE EDGE LINE BREAKS AND RADIUS FOR TOWN HIGHWAYS)
 MM 0.000 - MM 0.429 LT & RT

TEMPORARY 4 INCH YELLOW LINE, PAINT & DURABLE 4 INCH YELLOW LINE (OPTION BID ITEM) (ALL LINES WILL INCLUDE C/L BREAKS FOR TOWN HIGHWAYS)
 MM 0.000 - MM 0.080 SOLID LT & DASHED RT
 MM 0.080 - 0.220 MM DASHED LT & SOLID RT
 MM 0.220 - MM 0.429 SOLID LT & RT
 MM 0.000 - MM 2.500 SOLID LT & RT

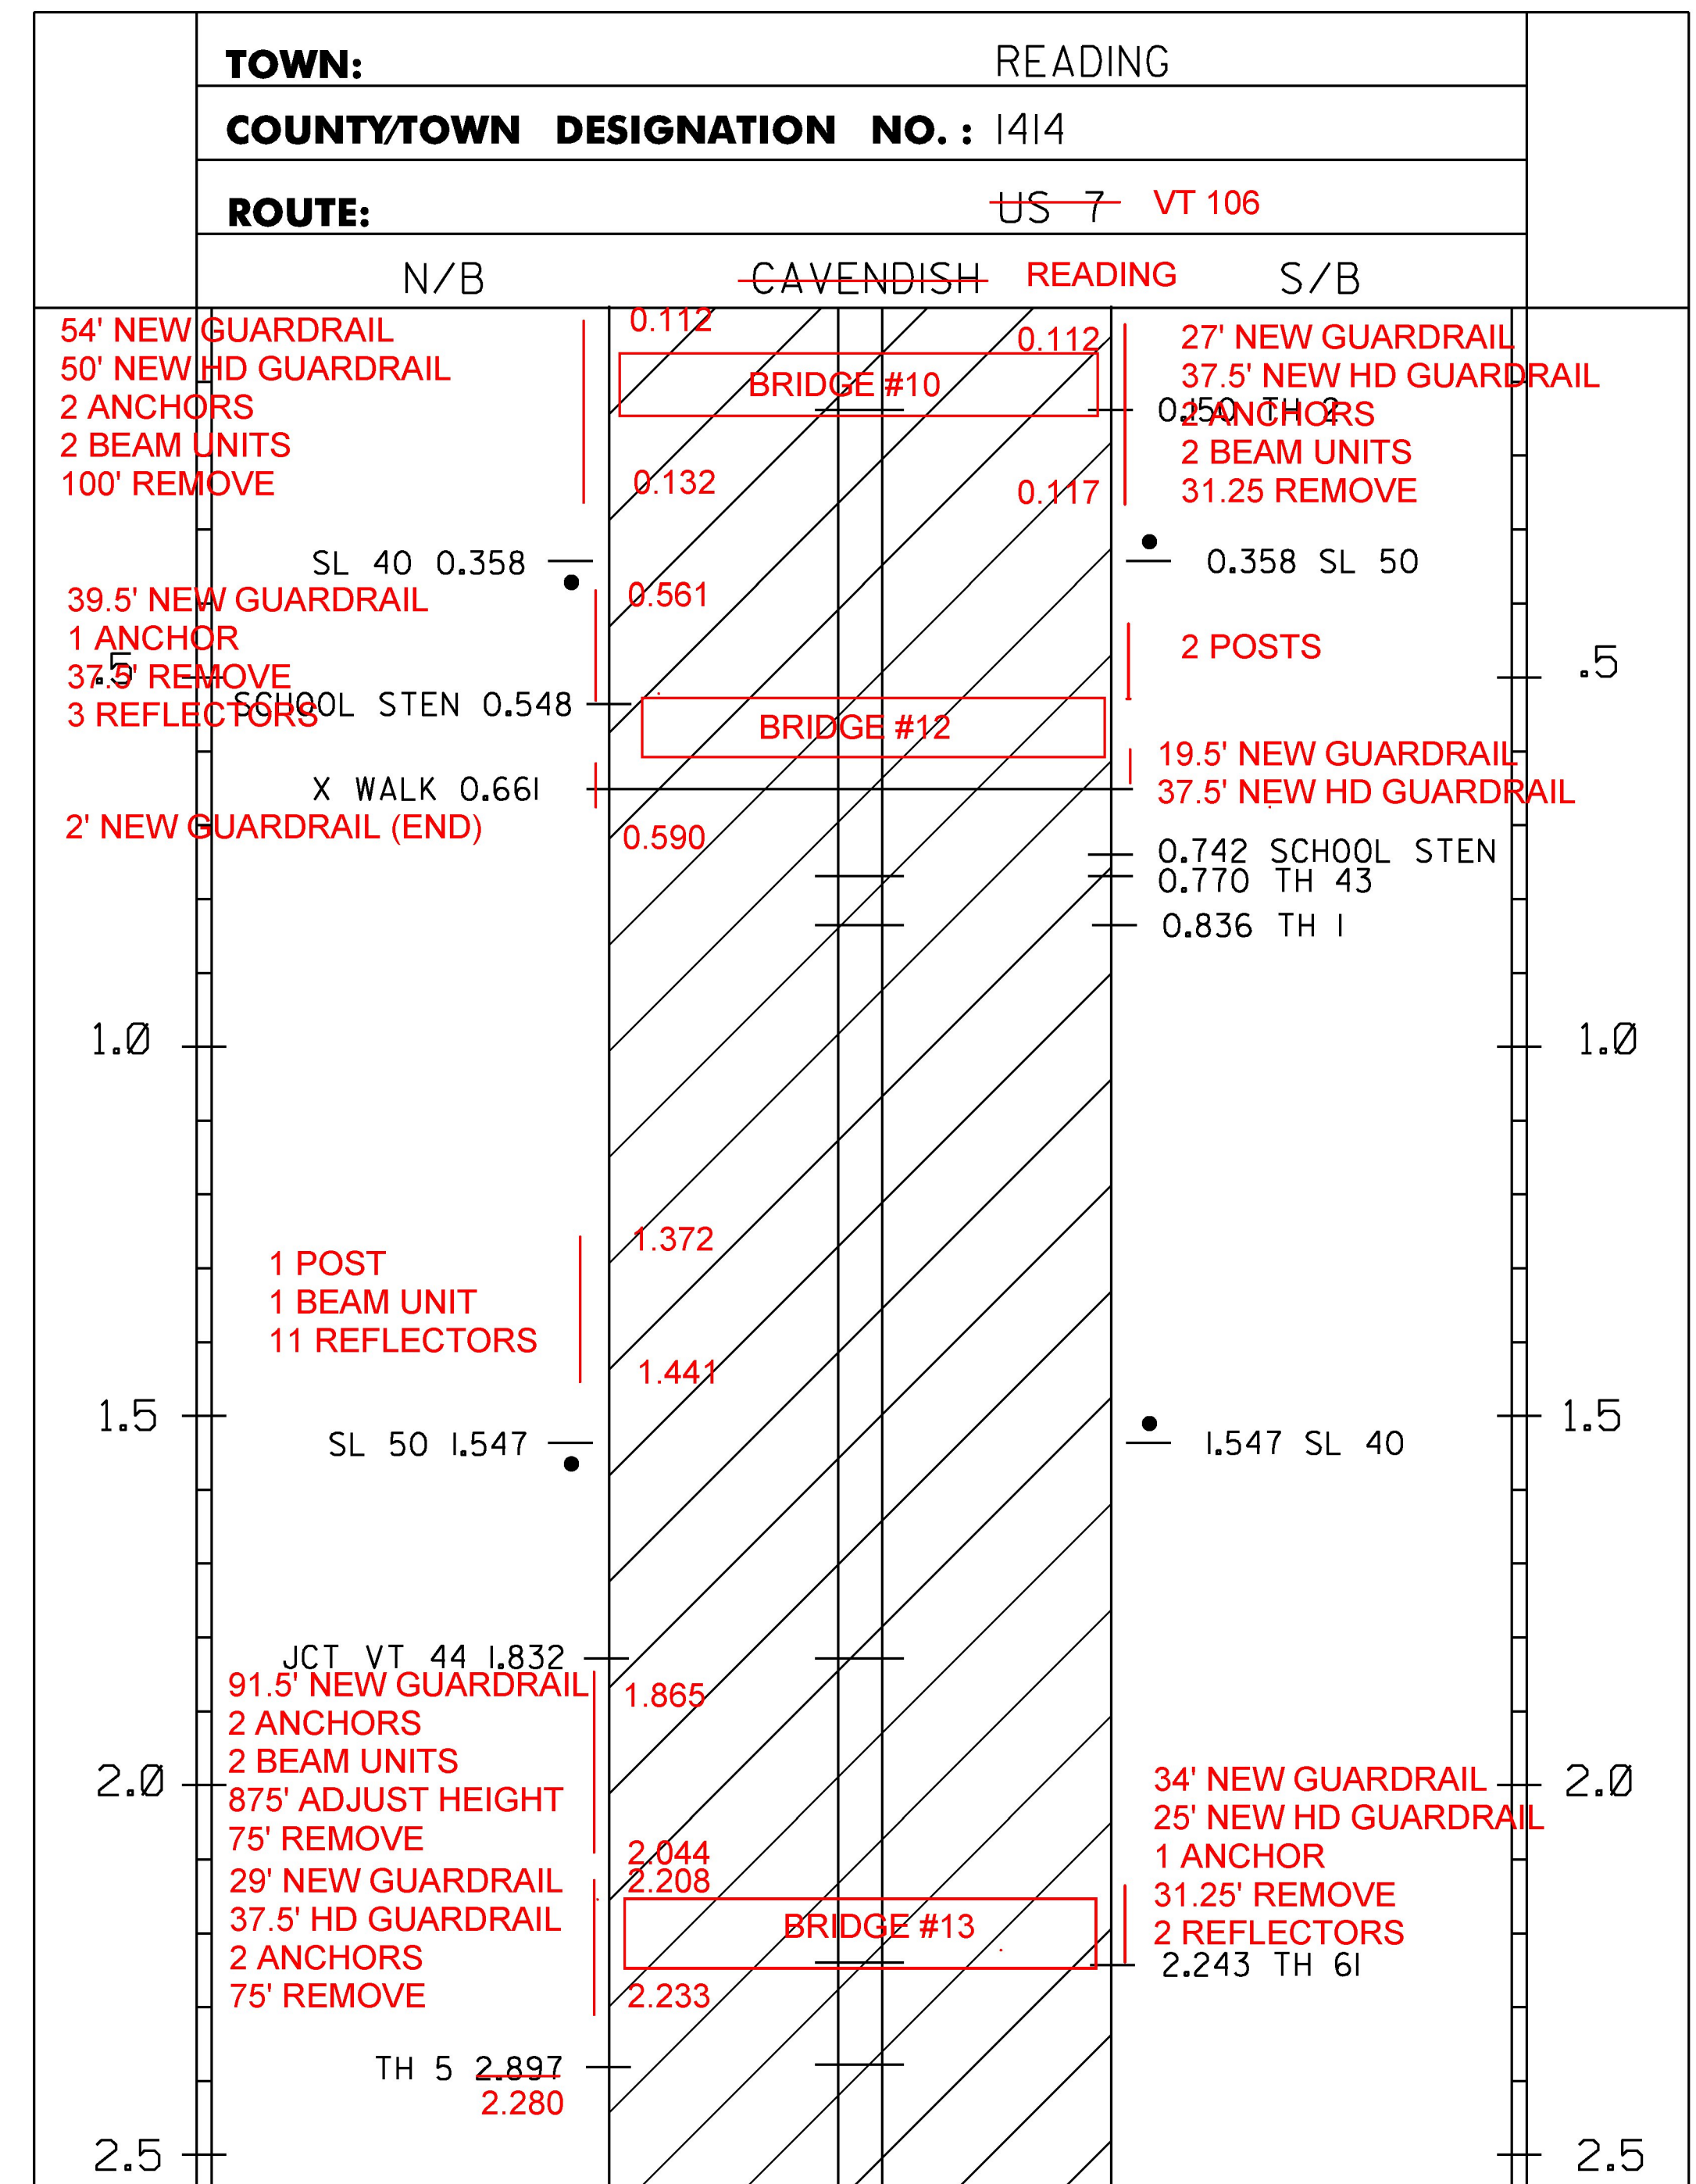

LEGEND
 TWBH-THROUGHWAY BEGINS HERE
 TWEH-THROUGHWAY ENDS HERE
 SHB-STATE HIGHWAY BEGINS
 SHE-STATE HIGHWAY ENDS
 SL-SPEED LIMIT
 SM-SPECIAL MARKINGS
 T/L-TOWN LINE

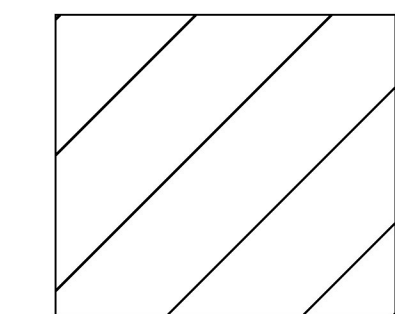

PROJECT AREA

NOTES:
 THIS SHEET TO BE USED FOR THE LAYOUT OF ALL CENTERLINE PAVEMENT MARKINGS.
 THE ENGINEER MAY CONTACT KEITH SWEET, PAVEMENT MARKING SUPERVISOR AT
 (802) 828-5573 FOR ASSISTANCE LAYING OUT THE CENTERLINE DURING CONSTRUCTION.

NOT TO SCALE

PROJECT NAME:	WEATHERSFIELD-READING
PROJECT NUMBER:	STP FPAV(I2)
FILE NAME: COMP. STP FPAV(I1),(I2) & (I3).dgn	PLOT DATE: 04-APR-2018
PROJECT LEADER: B. KIPP	DRAWN BY: N. PAPPAS
DESIGNED BY: N. PAPPAS	CHECKED BY: B. KIPP
PLAN SHEET 2	SHEET 39 OF 53