

TEMPORARY 4 INCH WHITE LINE, PAINT & DURABLE 4 INCH WHITE LINE (OPTION BID ITEM)
 (ALL LINES WILL INCLUDE EDGE LINE BREAKS AND RADIUS FOR TOWN HIGHWAYS)
 MM 2.500 - MM 7.277 LT & RT

TEMPORARY 4 INCH YELLOW LINE, PAINT & DURABLE 4 INCH YELLOW LINE (OPTION BID ITEM)
 (ALL LINES WILL INCLUDE C/L BREAKS FOR TOWN HIGHWAYS)
 MM 2.500 - MM 4.275 SOLID LT & RT
 MM 4.275 - MM 4.440 SOLID LT & DASHED RT
 MM 4.440 - MM 4.650 DASHED RT
 MM 4.650 - MM 4.781 DASHED LT & SOLID RT
 MM 4.781 - MM 6.150 SOLID LT & RT
 MM 6.150 - MM 6.290 SOLID LT & DASHED RT
 MM 6.290 - MM 6.375 DASHED RT
 MM 6.375 - MM 6.525 DASHED LT & SOLID RT
 MM 6.525 - MM 7.195 SOLID LT & RT
 MM 7.195 - MM 7.277 SOLID LT & DASHED RT

914.5' NEW GUARDRAIL W/8' POSTS
 77' NEW GUARDRAIL
 2 ANCHORS
 2 BEAM UNITS
 987.5' REMOVE

79' NEW GUARDRAIL
 2 ANCHORS
 650' ADJUST HEIGHT
 75' REMOVE
 21 REFLECTORS

79' NEW GUARDRAIL
 2 ANCHORS
 2 BEAM UNITS
 375' ADJUST HEIGHT
 75' REMOVE
 12 REFLECTORS

39.5' NEW GUARDRAIL
 1 ANCHOR
 587.5' ADJUST HEIGHT
 37.5' REMOVE
 18 REFLECTORS

1 POST
 2 BEAM UNITS
 75' ADJUST HEIGHT
 1 REFLECTOR

2' NEW GUARDRAIL
 6 BEAM UNITS
 12 REFLECTORS

1 POST
 4 BEAM UNITS
 15 REFLECTORS

8 BEAM UNITS
 1462.5' ADJUST HEIGHT
 46 REFLECTORS

41.5' NEW GUARDRAIL
 1 ANCHOR
 4 POSTS
 5 BEAM UNITS
 612.5' ADJUST HEIGHT
 37.5' REMOVE
 20 REFLECTORS

79' NEW GUARDRAIL
 2 ANCHORS
 3 BEAM UNITS
 362.5' ADJUST HEIGHT
 75' REMOVE
 12 REFLECTORS

262.5' ADJUST HEIGHT
 8 REFLECTORS


79' NEW GUARDRAIL
 2 ANCHORS
 3 BEAM UNITS
 237.5' ADJUST HEIGHT
 87.5' REMOVE
 6 REFLECTORS

341.5' NEW GUARDRAIL
 50' NEW HD GUARDRAIL
 2 ANCHORS
 387.5' REMOVE

39.5' NEW GUARDRAIL
 1 ANCHOR
 3 BEAM UNITS
 1 POST
 1275' ADJUST HEIGHT
 37.5' REMOVE
 40 REFLECTORS

2 BEAM UNITS
 612.5' ADJUST HEIGHT
 20 REFLECTORS

3 POSTS
 8 BEAMS UNITS
 850' ADJUST HEIGHT
 26 REFLECTORS

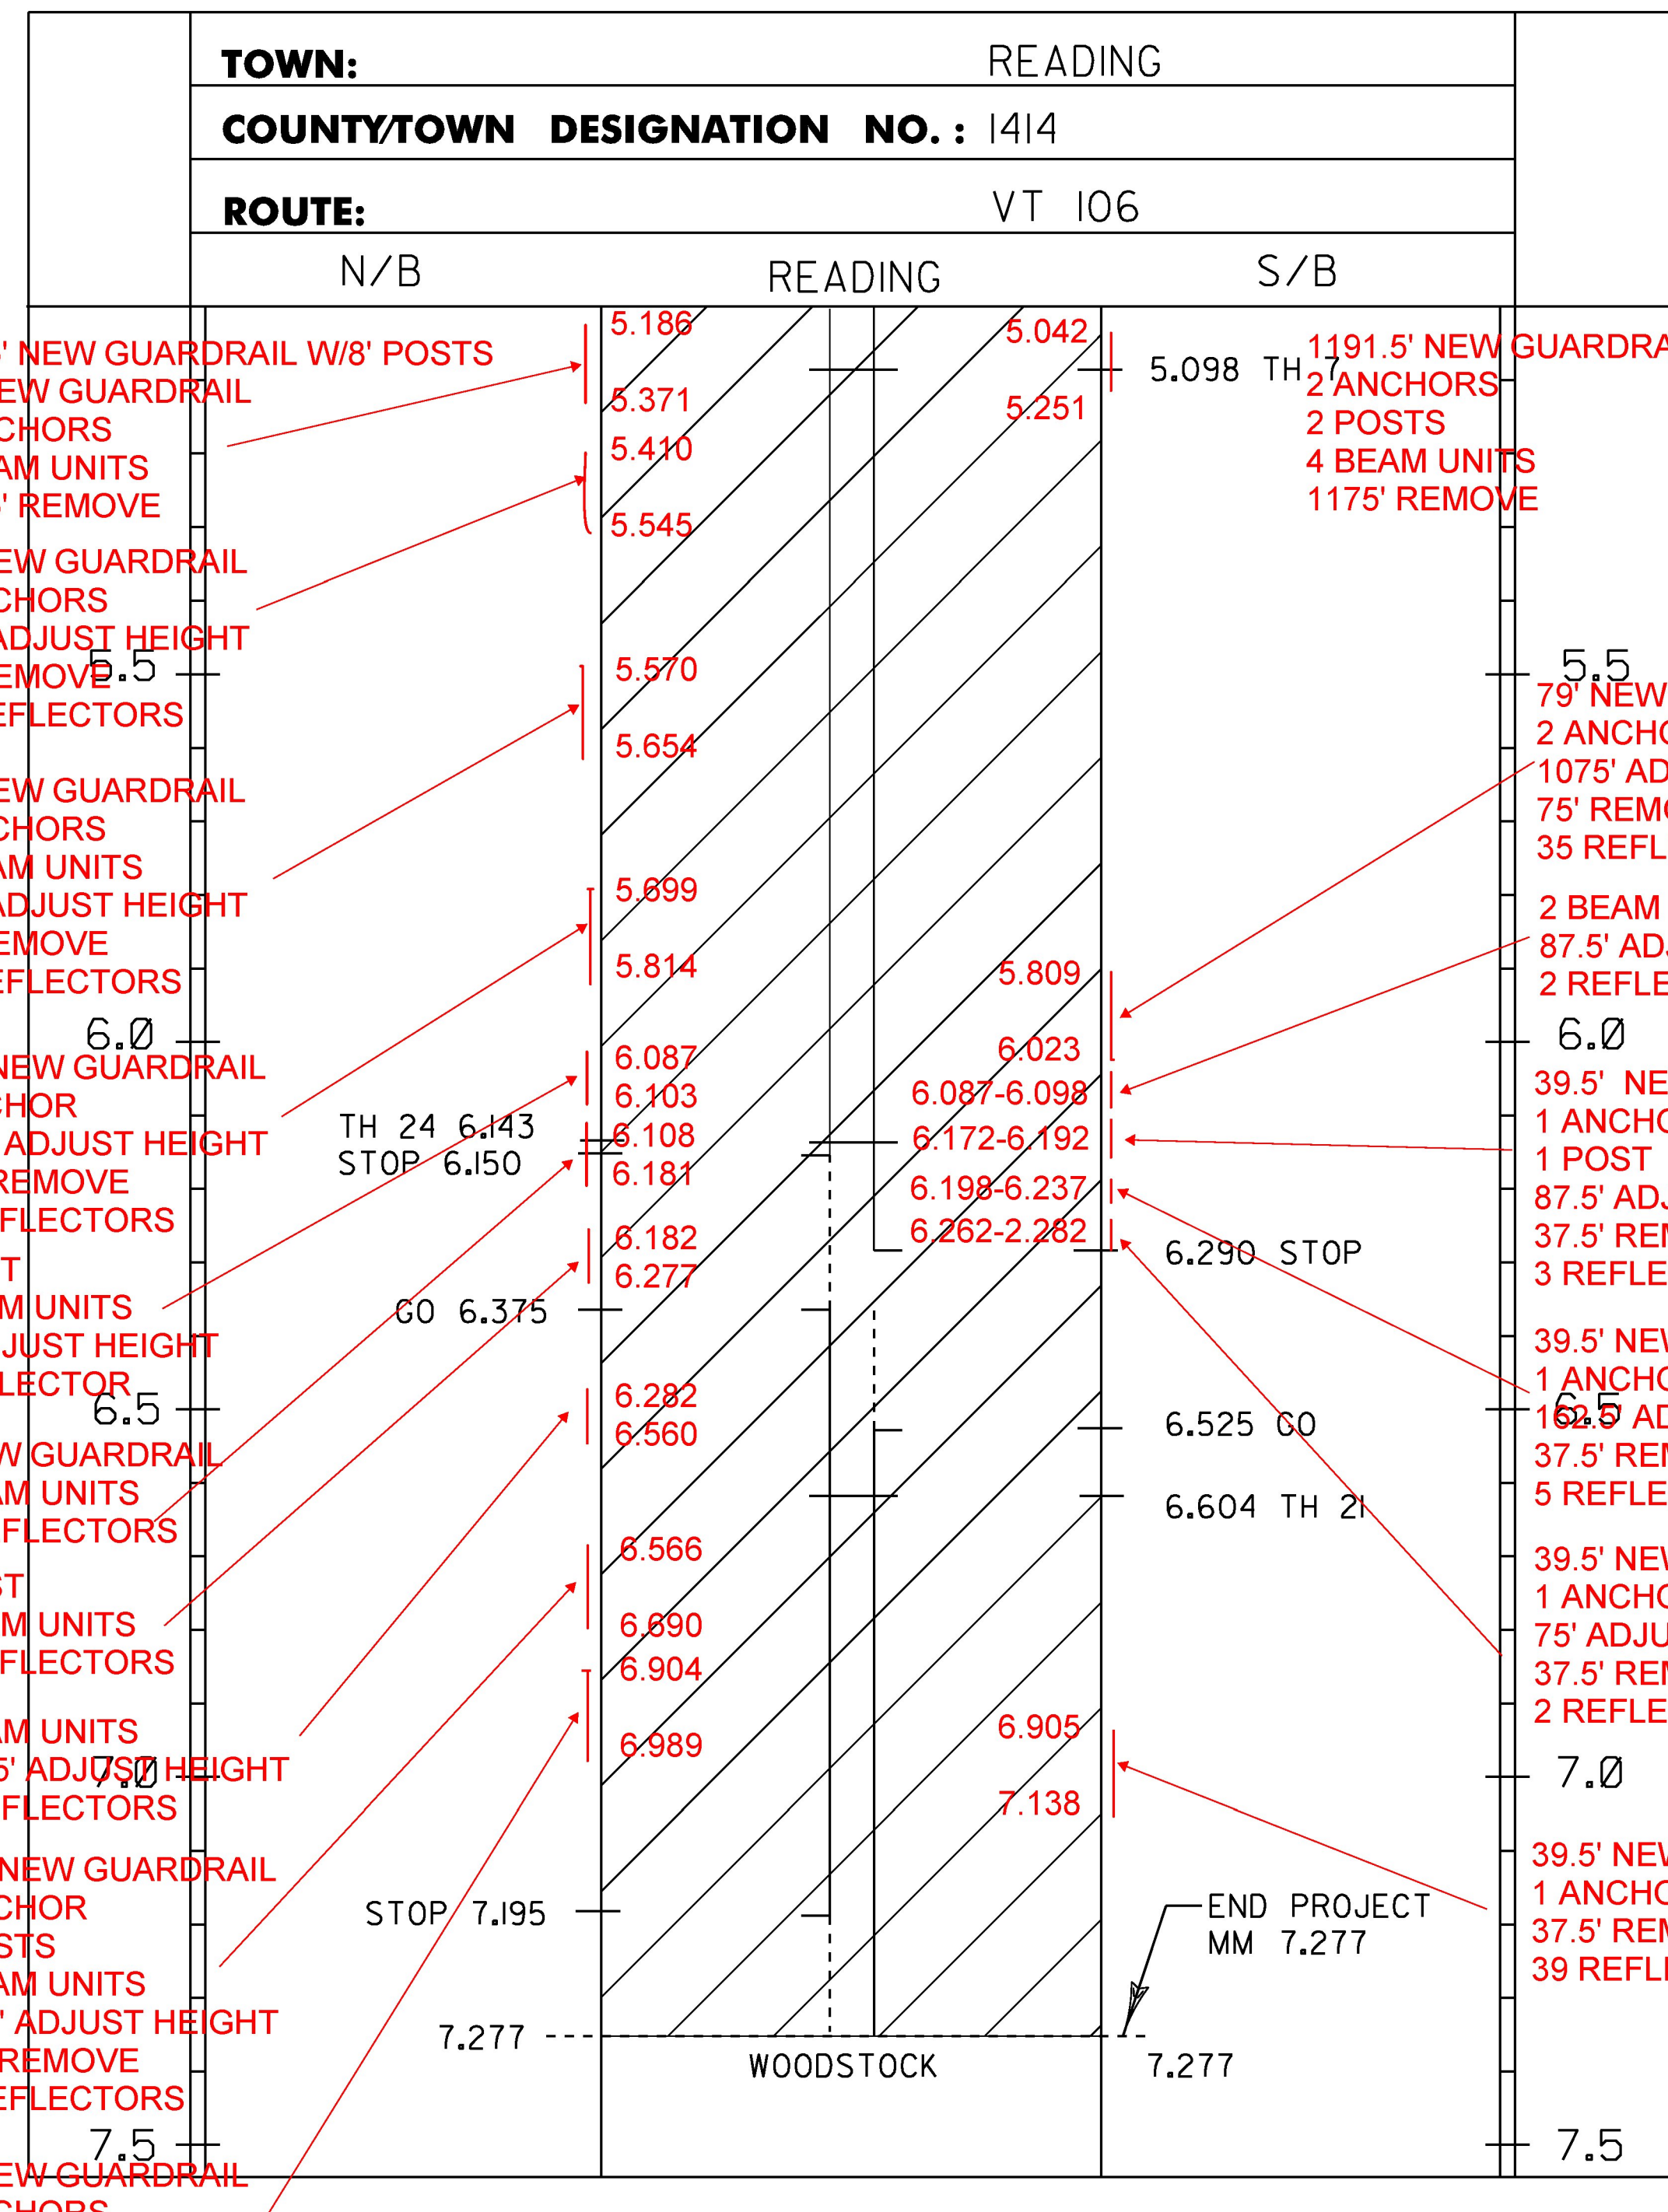

1191.5' NEW GUARDRAIL W/8' POSTS
 2 ANCHORS
 2 POSTS
 4 BEAM UNITS
 1175' REMOVE

79' NEW GUARDRAIL
 2 ANCHORS
 1075' ADJUST HEIGHT
 75' REMOVE
 35 REFLECTORS

2 BEAM UNITS
 87.5' ADJUST HEIGHT
 2 REFLECTORS


39.5' NEW GUARDRAIL
 1 ANCHOR
 1 POST
 87.5' ADJUST HEIGHT
 37.5' REMOVE
 3 REFLECTORS

39.5' NEW GUARDRAIL
 1 ANCHOR
 162.5' ADJUST HEIGHT
 37.5' REMOVE
 5 REFLECTORS

39.5' NEW GUARDRAIL
 1 ANCHOR
 75' ADJUST HEIGHT
 37.5' REMOVE
 2 REFLECTORS

39.5' NEW GUARDRAIL
 1 ANCHOR
 37.5' REMOVE
 39 REFLECTORS

LEGEND
 TWBH-THROUGHWAY BEGINS HERE
 TWEH-THROUGHWAY ENDS HERE
 SHB-STATE HIGHWAY BEGINS
 SHE-STATE HIGHWAY ENDS
 SL-SPEED LIMIT
 SM-SPECIAL MARKINGS
 T/L-TOWN LINE

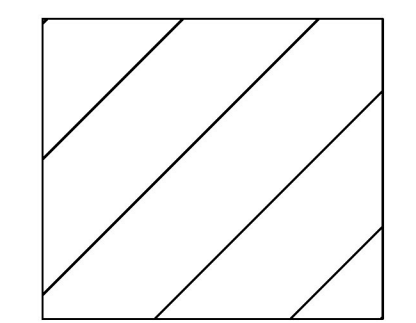

PROJECT AREA

NOTES:
 THIS SHEET TO BE USED FOR THE LAYOUT OF ALL CENTERLINE PAVEMENT MARKINGS.
 THE ENGINEER MAY CONTACT KEITH SWEET, PAVEMENT MARKING SUPERVISOR AT
 (802) 828-5573 FOR ASSISTANCE LAYING OUT THE CENTERLINE DURING CONSTRUCTION.

NOT TO SCALE

PROJECT NAME:	WEATHERSFIELD-READING
PROJECT NUMBER:	STP FPAV(I2)
FILE NAME: COMP. STP FPAV(I1),(I2) & (I3).dgn	PLOT DATE: 04-APR-2018
PROJECT LEADER: B. KIPP	DRAWN BY: N. PAPPAS
DESIGNED BY: N. PAPPAS	CHECKED BY: B. KIPP
PLAN SHEET 3	SHEET 40 OF 53