


TEMPORARY 4 INCH WHITE LINE, PAINT &  
 DURABLE 4 INCH WHITE LINE (OPTION BID ITEM)  
 (ALL LINES WILL INCLUDE EDGE LINE BREAKS AND  
 RADIUS FOR TOWN HIGHWAYS)  
 WEATHERSFIELD:  
 MM 0.003 - MM 0.501 LT & RT  
 WINDSOR:  
 WIN MM 0.000 - WIN MM 0.600 LT & RT

TEMPORARY 4 INCH YELLOW LINE, PAINT &  
 DURABLE 4 INCH YELLOW LINE (OPTION BID ITEM)  
 (ALL LINES WILL INCLUDE C/L BREAKS FOR  
 TOWN HIGHWAYS)  
 WEATHERSFIELD:  
 MM 0.003 - MM 0.501 LT & RT  
 WINDSOR:  
 WIN MM 0.000 - WIN MM 0.600 LT & RT

TEMPORARY LETTER OR SYMBOL, PAINT  
 DURABLE LETTER OR SYMBOL (OPTION BID ITEM)  
 WEATHERSFIELD:  
 MM 0.003 LT - "STOP"  
 MM 0.154 LT - "AHEAD"  
 MM 0.163 LT - "STOP"

TEMPORARY 24 INCH STOP BAR, PAINT  
 DURABLE 24 INCH STOP BAR (OPTION BID ITEM)  
 WEATHERSFIELD:  
 MM 0.003 LT

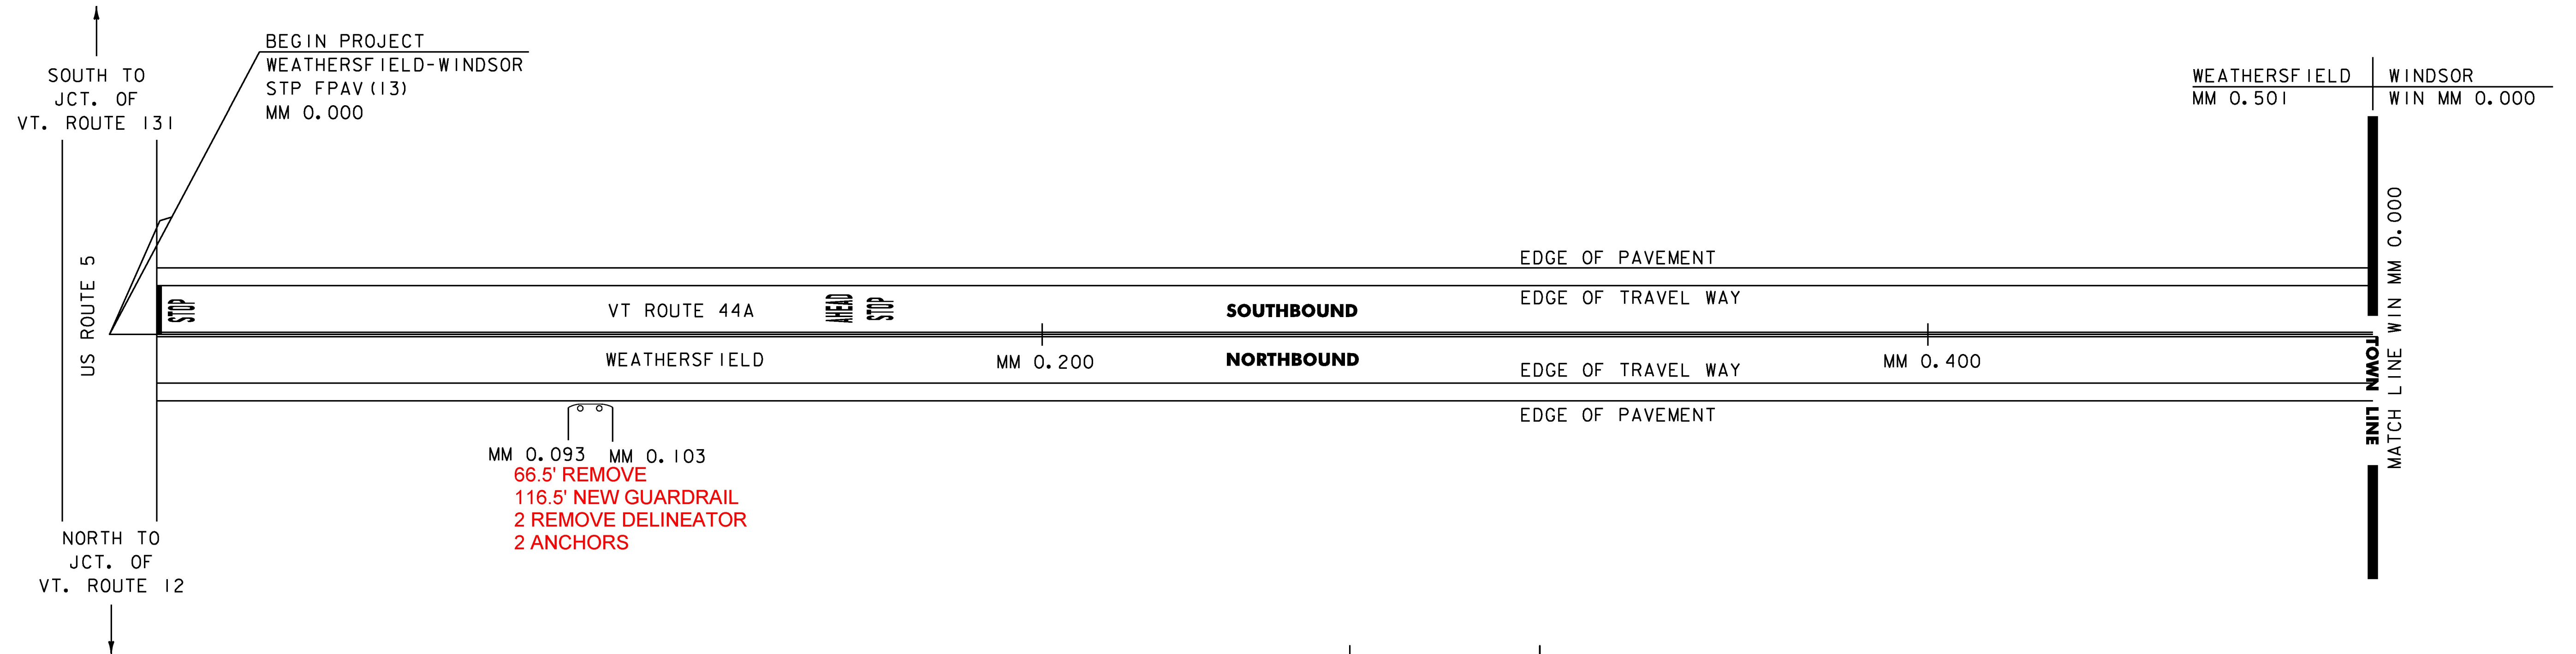

MM 0.093 MM 0.103  
 66.5' REMOVE  
 116.5' NEW GUARDRAIL  
 2 REMOVE DELINEATOR  
 2 ANCHORS

377.5' REMOVE  
 300' NEW GUARDRAIL W/8' POSTS  
 52' NEW GUARDRAIL  
 25' NEW HD GUARDRAIL  
 1 ANCHOR WIN MM 0.272

127' REMOVE  
 102' NEW GUARDRAIL  
 25' NEW HD GUARDRAIL  
 1 ANCHOR WIN MM 0.438

514.5' REMOVE  
 489.5' NEW GUARDRAIL  
 25' NEW HD GUARDRAIL  
 1 ANCHOR WIN MM 0.257

89.5' REMOVE  
 64.5' NEW GUARDRAIL  
 300' NEW GUARDRAIL W/8' POSTS  
 25' NEW HD GUARDRAIL  
 1 ANCHOR WIN MM 0.438

404' ADJUST HEIGHT  
 8 REFLECTORS WIN MM 0.480 WIN MM 0.560

BR#1  
 OVER  
 I-91

MATCH LINE WIN MM 0.000

MATCH LINE WIN MM 0.600

NOT TO SCALE

PROJECT NAME:	WEATHERSFIELD-WINDSOR
PROJECT NUMBER:	STP FPAV(I3)
FILE NAME: COMP, STP FPAV(I1),(I2) & (I3).dgn	PLOT DATE: 04-APR-2018
PROJECT LEADER: B. KIPP	DRAWN BY: L. BULLOCK
DESIGNED BY: L. BULLOCK	CHECKED BY: B. KIPP
PLAN SHEET 1	SHEET 49 OF 53