


INDEX OF SHEETS

SHEET NO.	TITLE PAGE
2	TYPICAL CROSS-SECTION OF IMPROVEMENT (CONCRETE PAVEMENT)
3	" " " " (BITUMINOUS MACADAM)
4	PLAN AND PROFILE STA. 474+00 TO STA. 485+00
5	" " " " 485+00 " " 500+00
6	" " " " 500+00 " " 515+00
7	" " " " 515+00 " " 530+00
8	" " " " 530+00 " " 545+00
9	" " " " 545+00 " " 560+00
10	" " " " 560+00 " " 575+00
11	" " " " 575+00 " " 590+00
12	" " " " 590+00 " " 605+00
13	" " " " 605+00 " " 621+00
14	" " " " 621+00 " " 637+00
15	" " " " 637+00 " " 652+00
16	" " " " 652+00 " " 668+00
17	" " " " 668+00 " " 682+00
18	" " " " 682+00 " " 698+00
19	" " " " 698+00 " " 713+00
20	" " " " 713+00 " " 726+00
21	" " " " 726+00 " " 740+00
22	" " " " 740+00 " " 754+00
23	" " " " 754+00 " " 770+00
24	" " " " 770+00 " " 786+00
25	" " " " 786+00 " " 802+00
26	" " " " 802+00 " " 818+00
27	" " " " 818+00 " " 834+00
28	" " " " 834+00 " " 850+00
29	" " " " 850+00 " " 866+00
30	" " " " 866+00 " " 882+00
31	" " " " 882+00 " " 898+00
32	" " " " 898+00 " " 914+00
33	" " " " 914+00 " " 927+33.4

ST
PLAN
TO

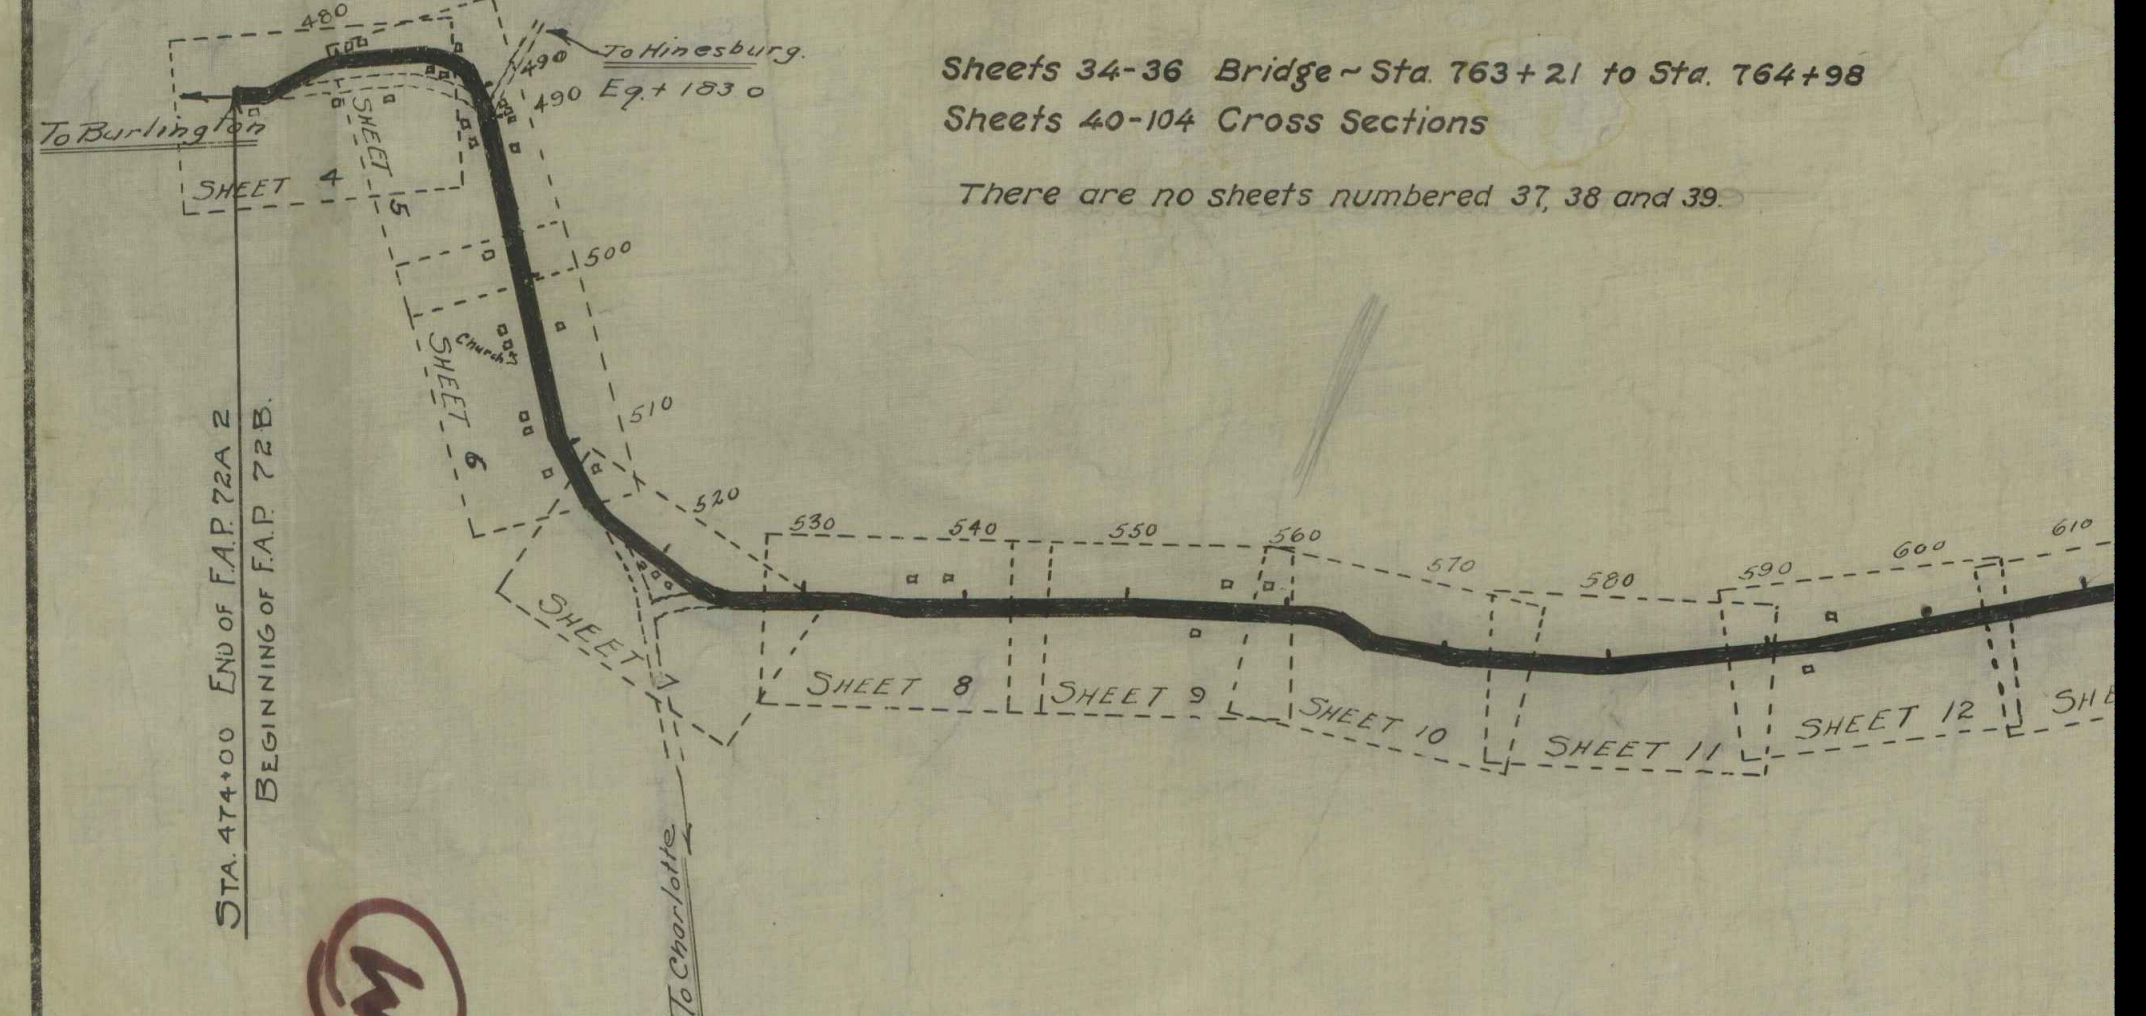

Sheets 34-36 Bridge - Sta. 763+21 to Sta. 764+98
 Sheets 40-104 Cross Sections
 There are no sheets numbered 37, 38 and 39.

CONVENTIONAL SIGNS

COUNTY LINE	GROUND ELEVATION	DATUM 126.5	LINE
TOWN LINE	GRADE ELEVATION	DATUM 127.5	LINE
FENCE LINE			
STONE WALL			
UNFENCED PROPERTY			
GUARD RAIL			
TRAVELED WAY			
RAILROAD			
RETAINING WALL			
CENTER LINE			
SURVEY LINE			
CULVERT			
DROP INLET			
TROLLEY POLE			
POWER POLE			
TELEPHONE POLE			
TREES			
HEDGE			

CHARLOTTE-FERRISBURG F 72 B
 RECORD PLANS
 CONTER-CARLO BLANCHI CO., INC.
 FISCAL YEAR 1928

CURVE DATA
 DEFLECTION ANGLE Δ
 DEGREE OF CURVE D.
 RADIUS OF CURVE R.
 TANGENT DISTANCE T.
 LENGTH OF CURVE L.
 EXTERNAL DISTANCE E.
 POINT OF INTERSECTION P. I.
 POINT OF CURVE P. C.
 POINT OF TANGENT P. T.

This project
 standard
 of Public
 Bidmipous
 Specification
 All struc
 in accord
 structur

THESE PLANS
 BE REQUIRE
 OR THE CHI