



WOOD GUARD RAIL REQUIRED

<u>LEFT</u>			
Sta	Start	End	Length
550+36	550+60		24 ft. ✓
"	554+38	555+22	" 24 " ✓
"	558+26	558+50	" 24 " ✓
"	559+20	560+00	" 20 " ✓

<u>RIGHT</u>			
Sta	Start	End	Length
550+36	550+60		24 ft. ✓
"	554+38	555+22	" 24 " ✓
"	558+26	558+50	" 24 " ✓
"	559+20	560+00	" 20 " ✓

NEW CULVERTS REQUIRED

Sta 550+48	18" Rein. Concrete Pipe Culvert
	Concrete Class $\frac{A}{2}$ (1-2) ✓
	Reinforcing Steel
Sta 555+10	24" Rein. Concrete Pipe Culvert
	Concrete Class $\frac{A}{2}$ (1-2) ✓
	Reinforcing Steel
Sta 558+38	18" Rein. Concrete Pipe Culvert
	Concrete Class $\frac{A}{2}$ (1-2) ✓
	Reinforcing Steel
Sta 559+32	18" Rein. Concrete Pipe Culvert
	Concrete Class $\frac{A}{2}$ (1-2) ✓
	Reinforcing Steel

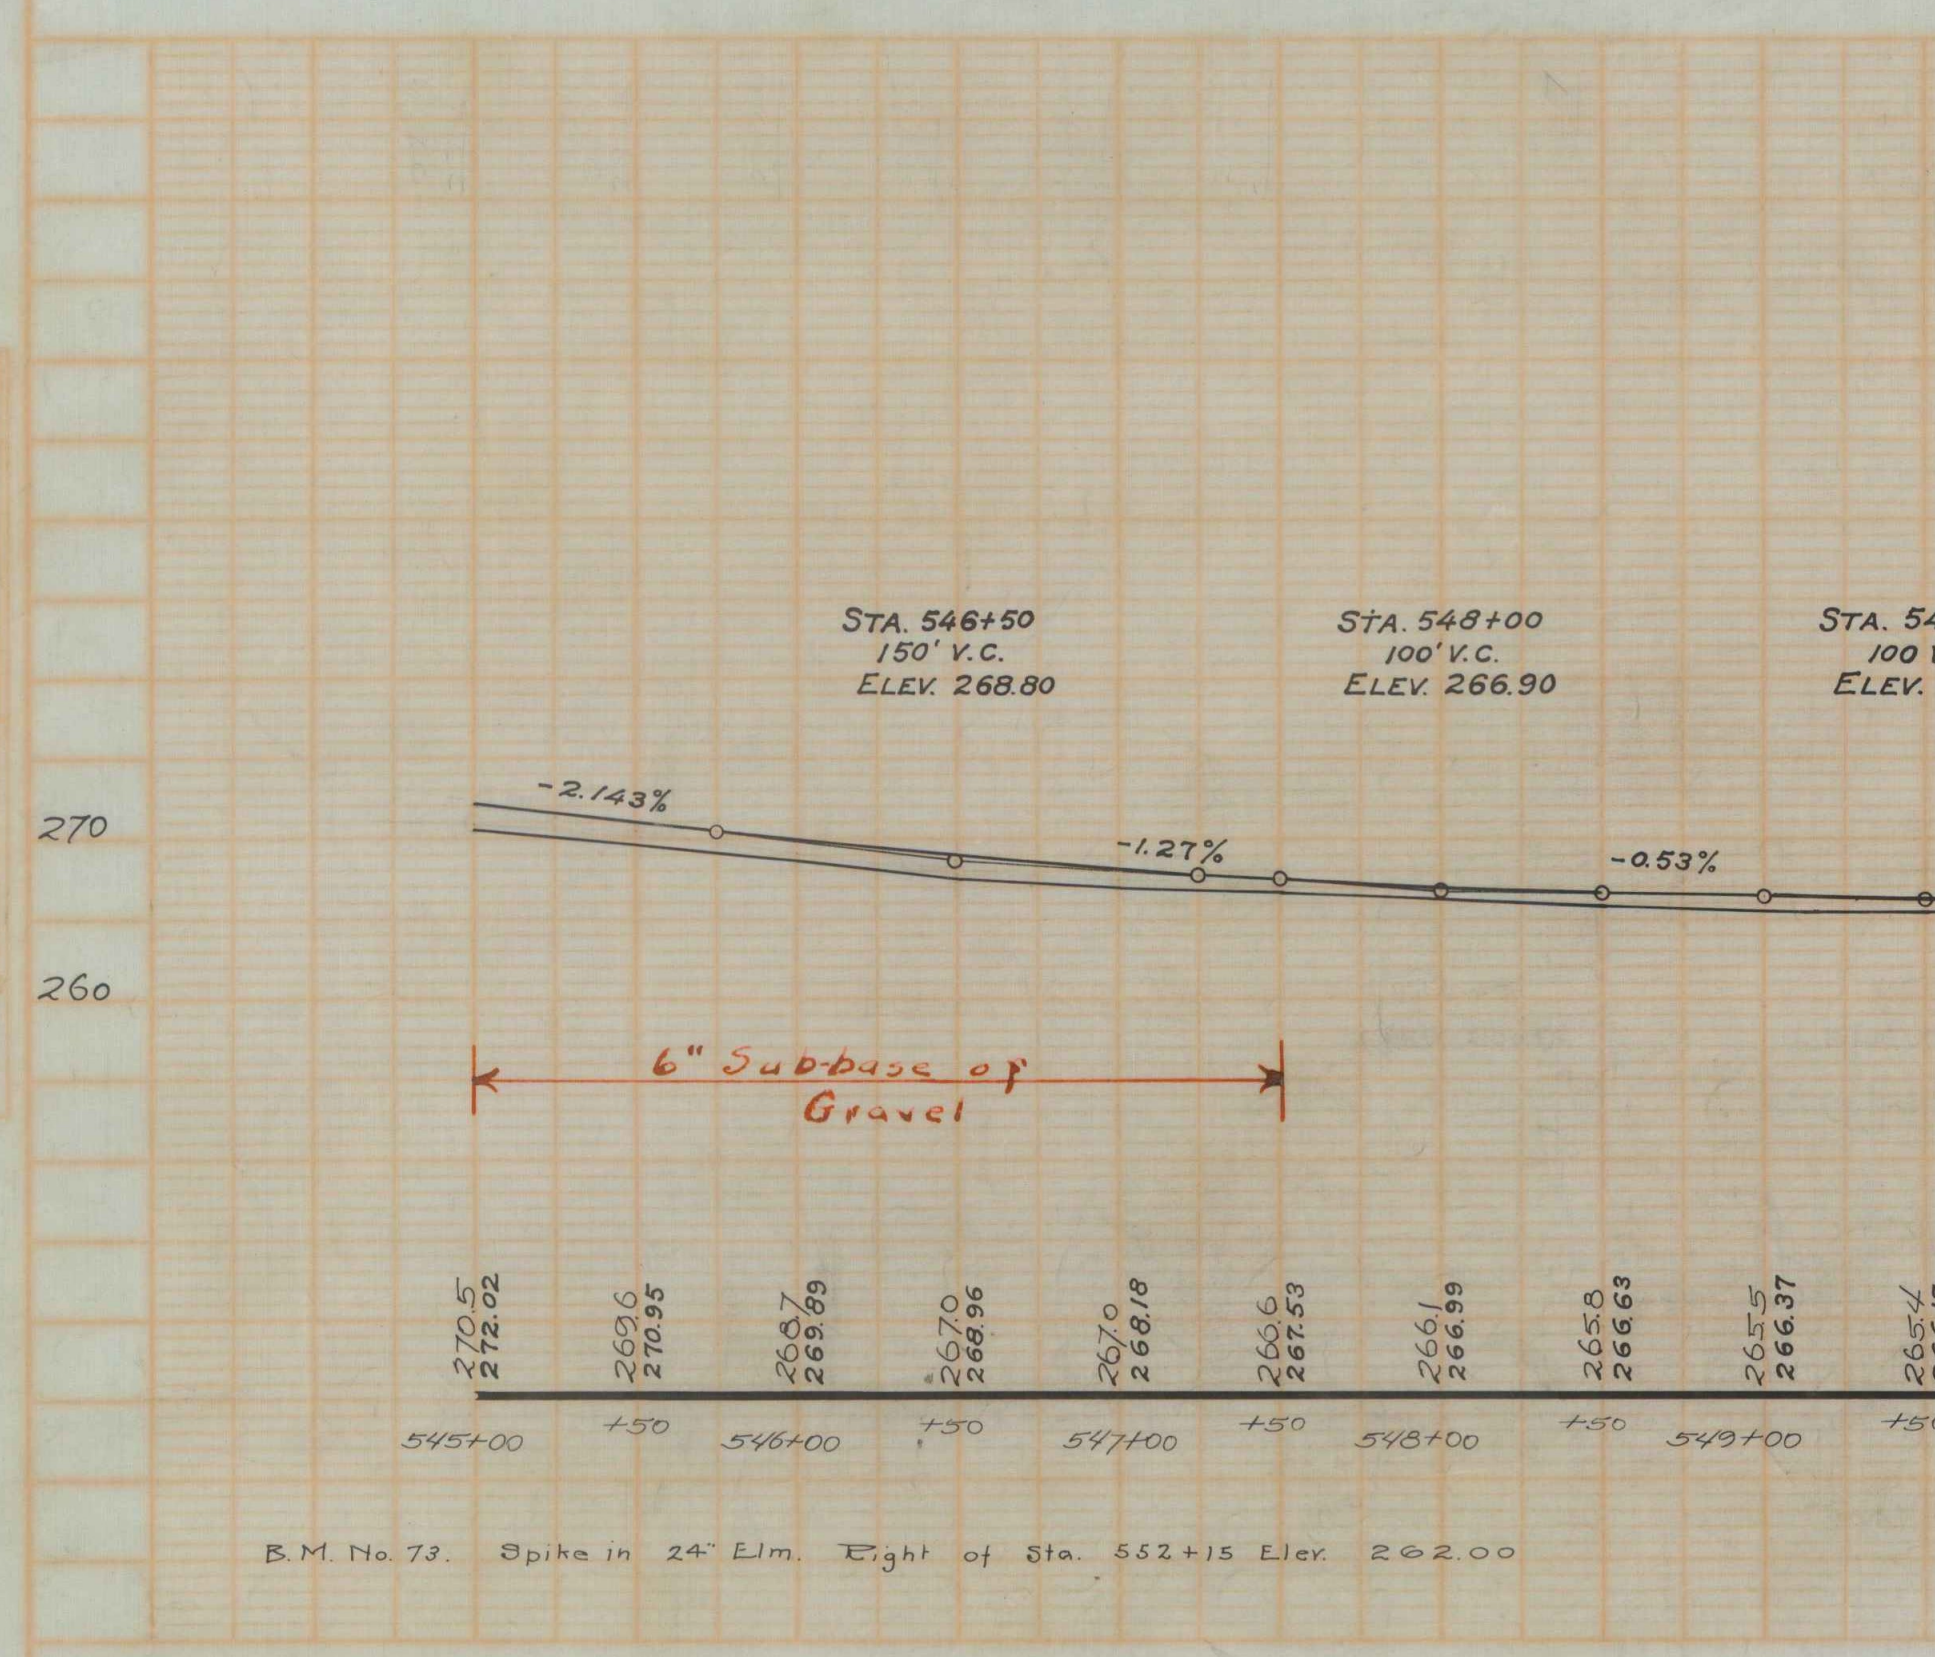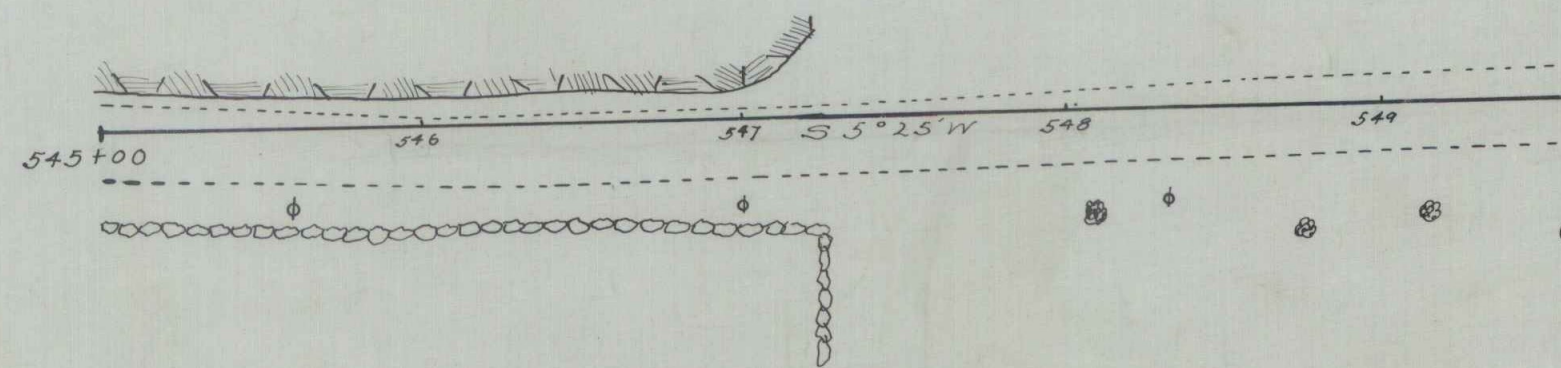

B.M. No. 73. Spike in 24" Elm. Right of Sta. 552+15 Elev. 262.00