


DEVIANT CULVERTS REQUIRED  
 Sta. 792+65 - Build Non-Hooded  
 Concrete Class 33 (4-24-8)

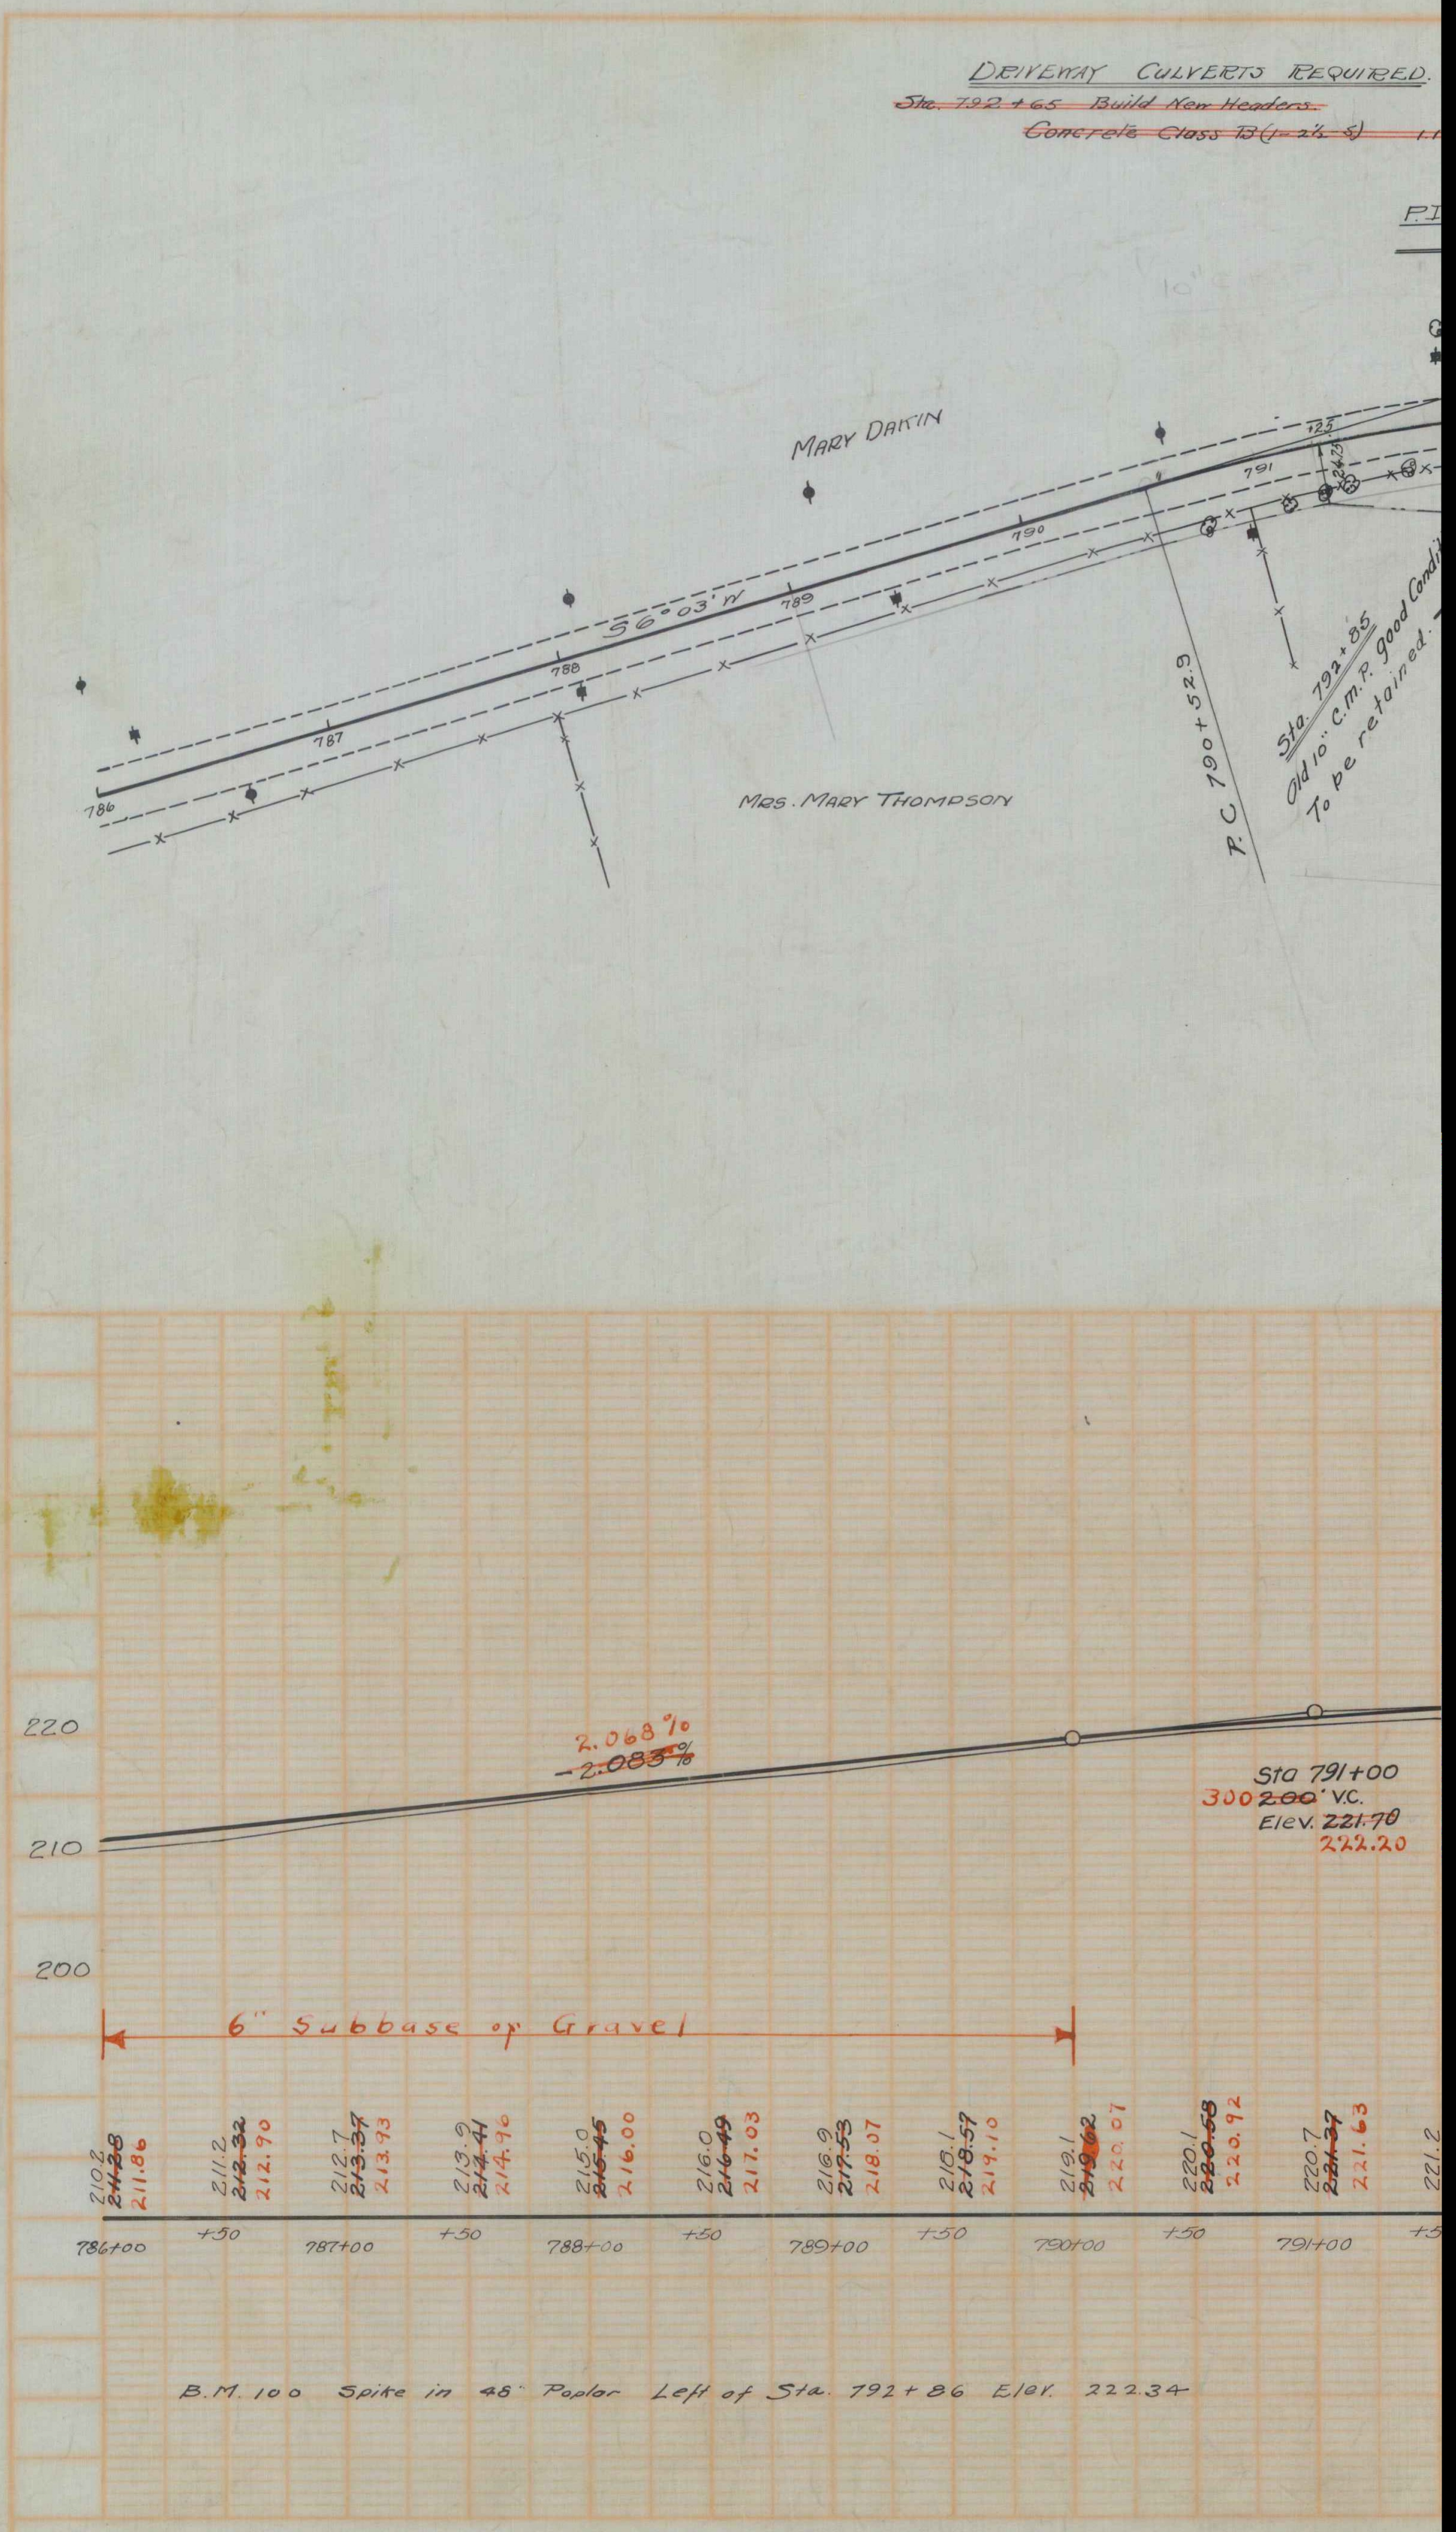

Station	Elevation
786+00	210.58
786+00	211.86
+50	211.2
+50	212.32
787+00	212.70
+50	213.7
+50	213.57
788+00	213.73
+50	213.9
+50	214.41
788+00	214.76
+50	215.0
+50	215.75
789+00	216.00
+50	216.0
+50	216.49
789+00	217.03
+50	218.9
+50	219.25
789+00	218.07
+50	219.1
+50	219.57
790+00	219.10
+50	219.1
+50	219.62
790+00	220.07
+50	220.49
+50	220.92
791+00	220.7
+50	221.37
+50	221.63
791+00	221.2

B.M. 100 Spike in 45" Peglar Left of Sta. 792+86 Elev. 222.34