
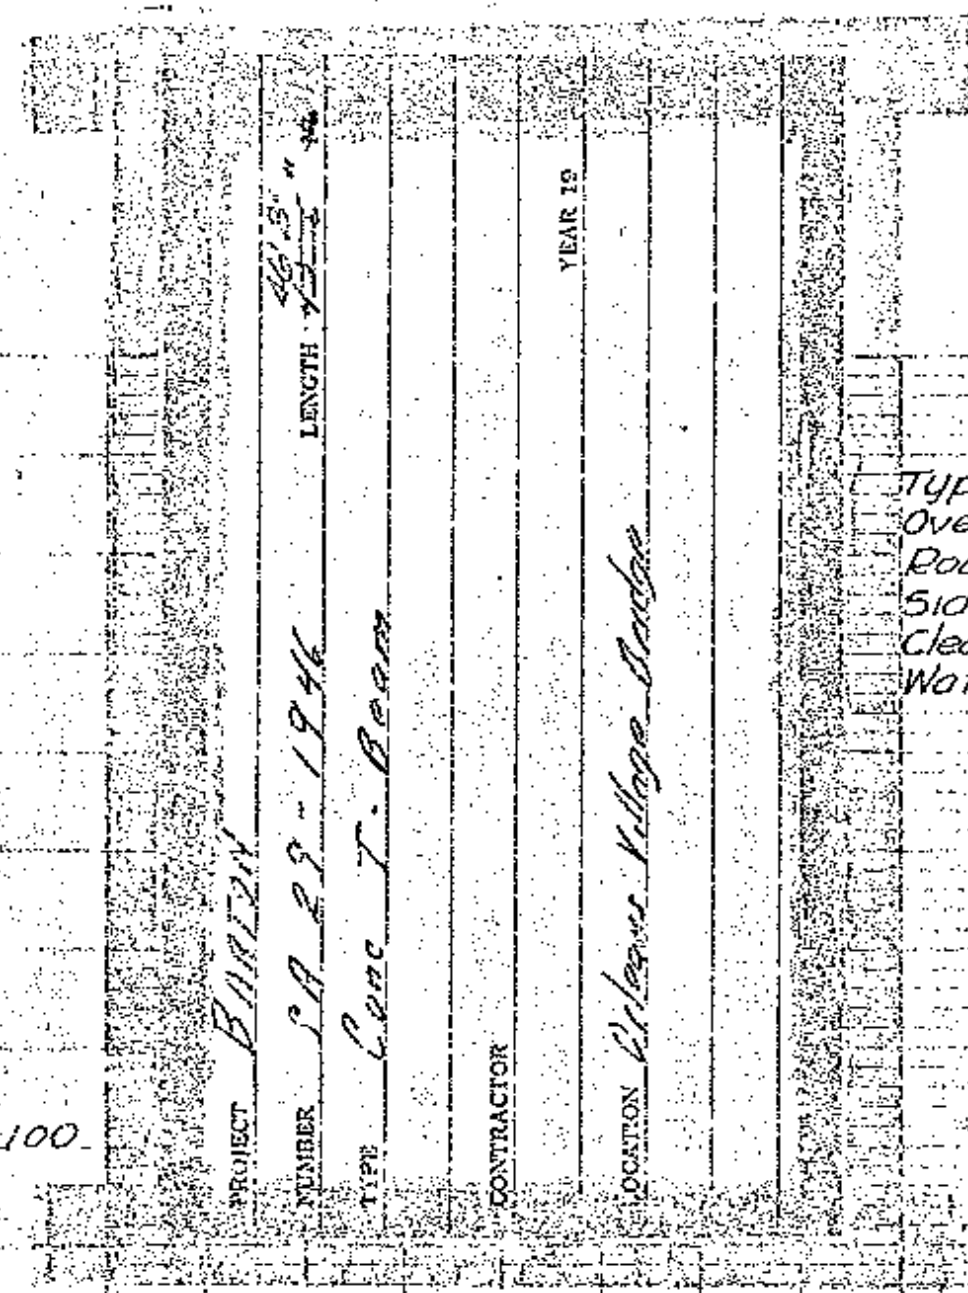
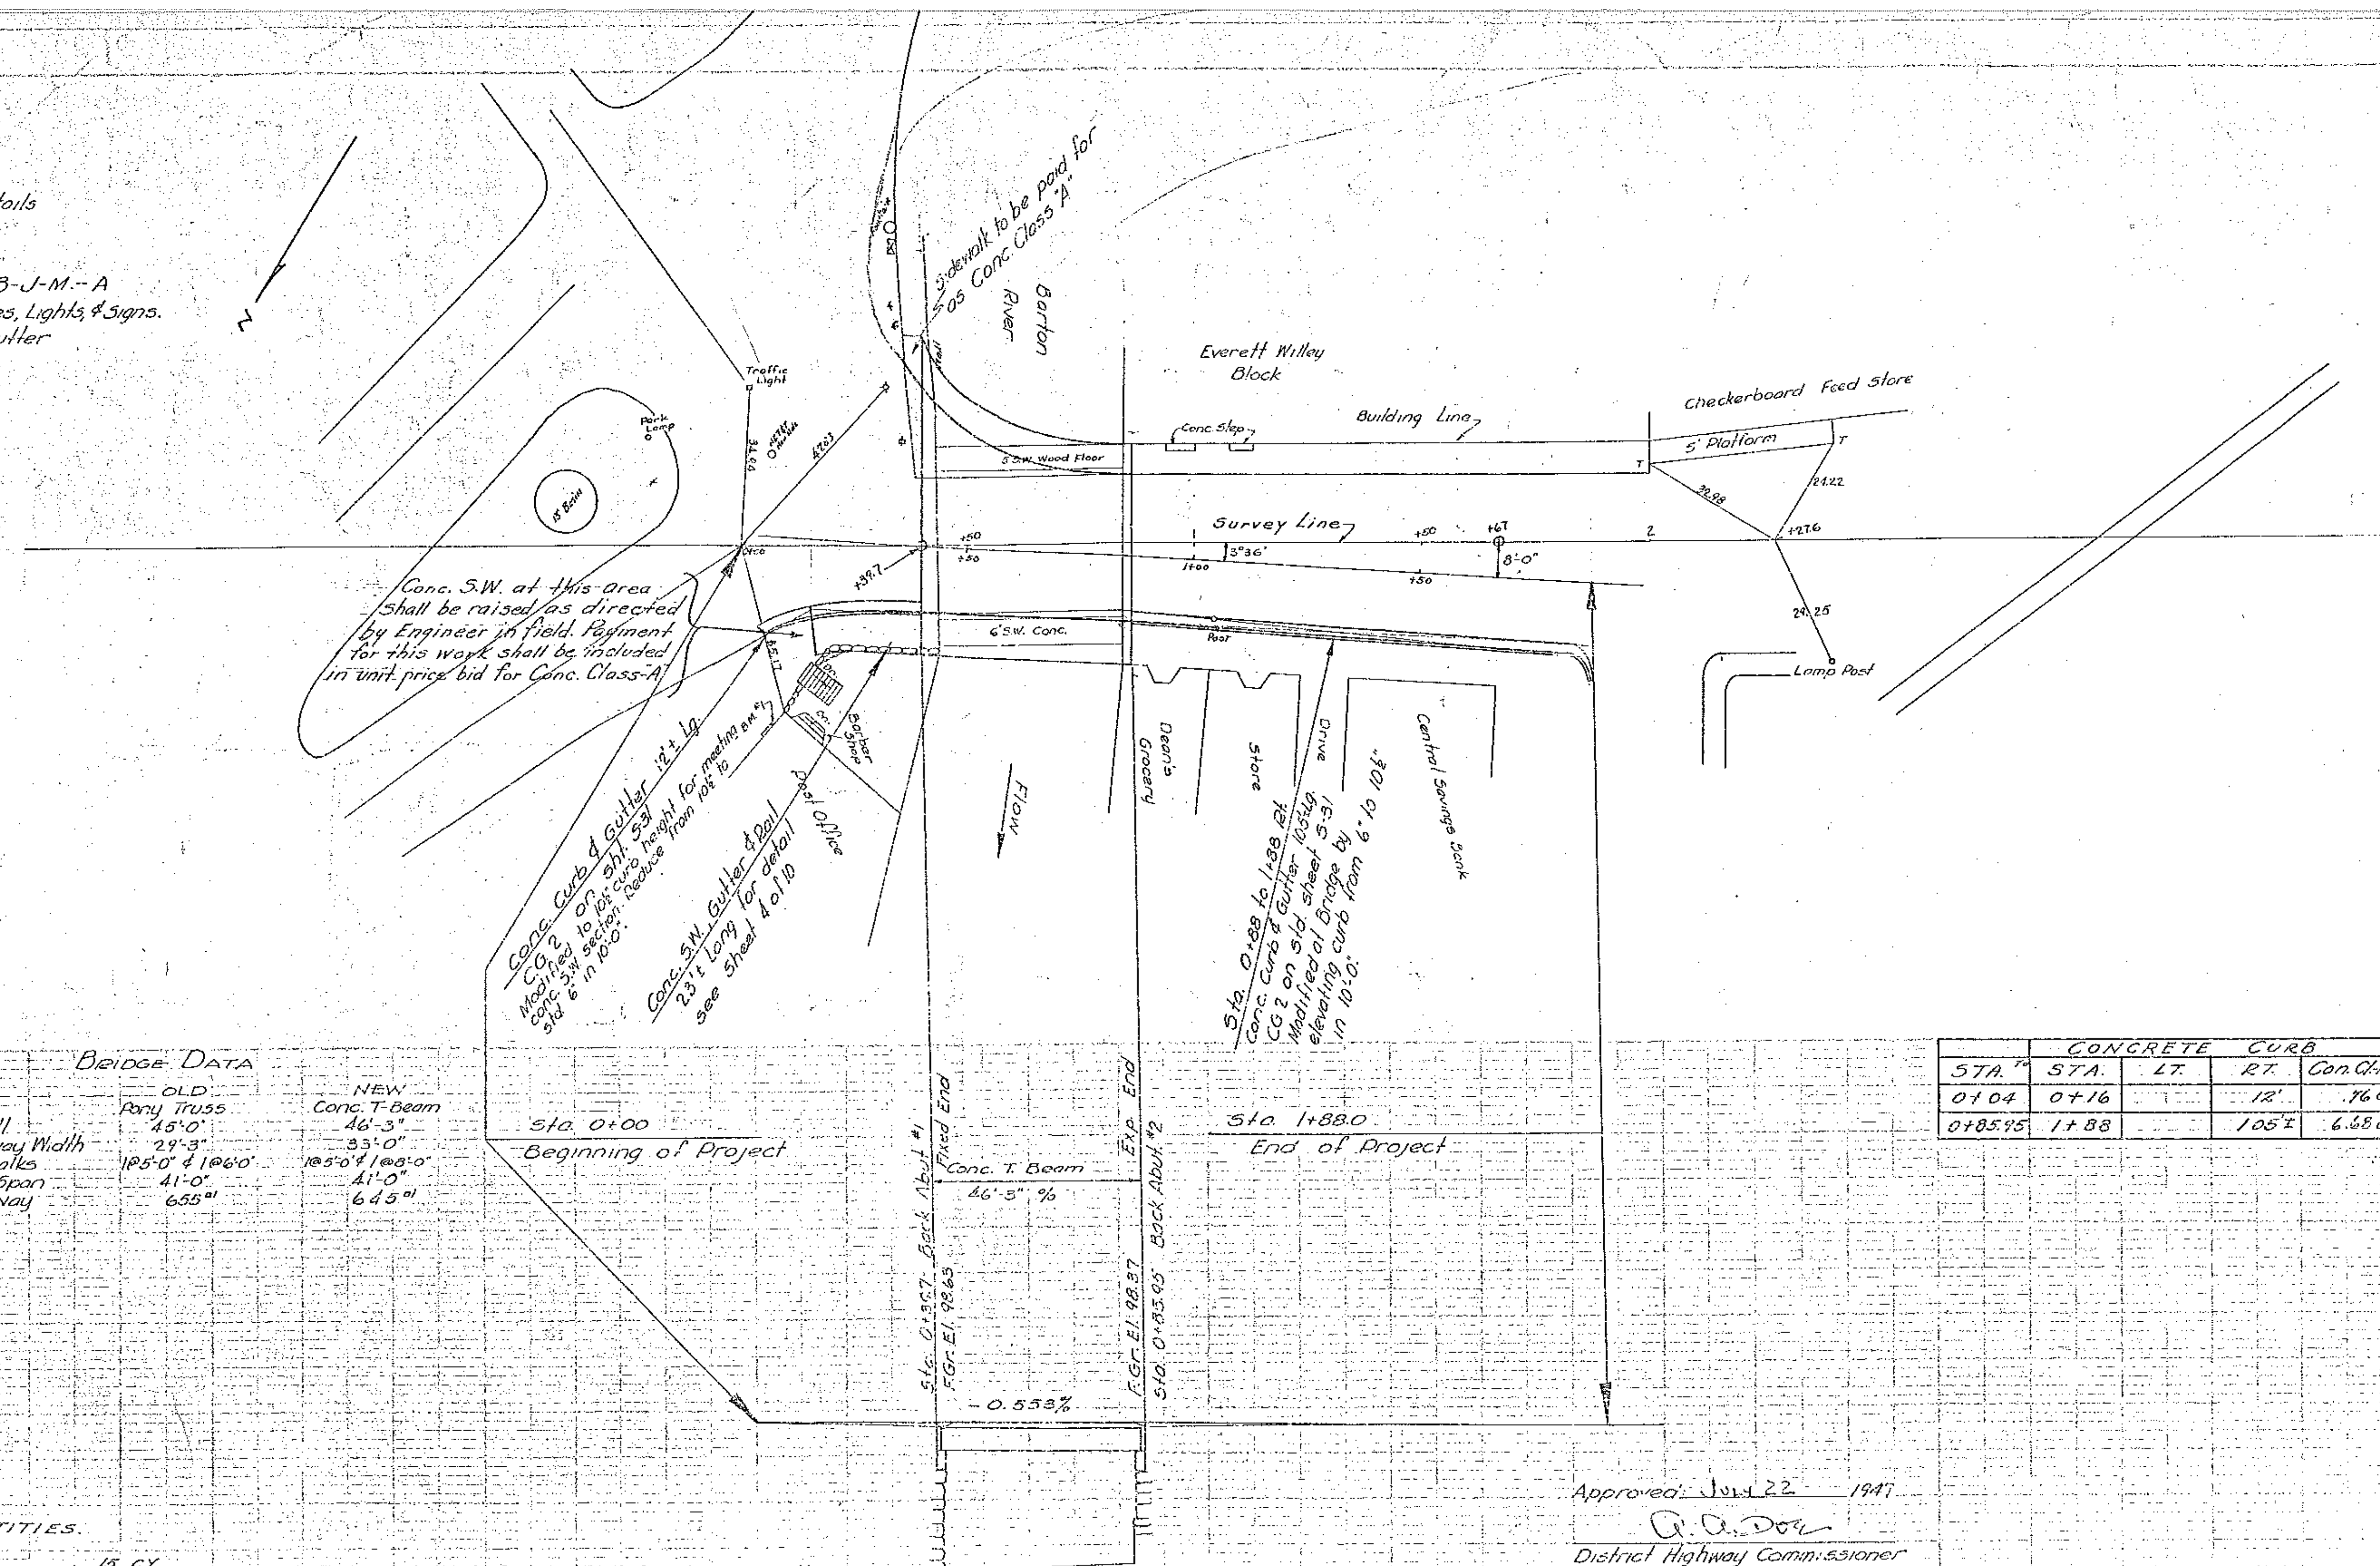


**LIST OF SHEETS**

- 1 Plan & Profile
- 2 Plan of Bridge
- 3 Section of Bridge & Details
- 4 Rail Post Spacing & Approach Rail Details
- 5 Details Abut #1
- 6 " " #2
- 7 Std. Structure Sheet 5B-20-Details B-J-M-A
- 8 " " " 5B-11-Barricades, Lights & Signs.
- 9 " " " 5-31-curb & gutter
- 10 Cross Sections

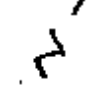

**BRIDGE DATA**

	OLD	NEW
Type	Rory Truss	Conc. T-Beam
Overall	45'-0"	46'-3"
Roadway Width	29'-3"	33'-0"
Sidewalks	18'-5" & 10'-0"	10'-5" & 10'-0"
Clear Span	41'-0"	41'-0"
Waterway	655 <sup>sq</sup>	645 <sup>sq</sup>

Sta 0+00  
Beginning of Project

Sta 1+88.0  
End of Project

CONCRETE CURB					
STA.	STA.	LT.	RT.	Con. Cl. A	Reinf. Steel
0+04	0+16		12'	76 cu	22#
0+85.95	1+88		105'	6.65 cu	189#

**LIST OF QUANTITIES**

Item	Description	Quantity
10	Solid Rock Excav.	15 CY
10-11	Common Excav. 1/2" Borrow	25 CY
16	Structure Excav.	146 CY
18-8	Temp. Br. & Joint of Traffic	1 LS.
19c	Sub-base of Gravel	20 CY
25	Crushed Gravel Mixed in place Surface Course with Refined Tar	33 CY
30	Refined Tar	730 Gal.
41A	Concrete Class A	183 cu
41C	" " " C	42 cu
42	Reinf. Steel	37,730 Lbs.
43A	Structural Steel	3,550 Lbs.
57	Removal of Present Superstr.	1 LS.
94	Conduit for Lighting System	1 LS.

Approved: July 22 1947

*A. A. Dore*  
District Highway Commissioner  
Correct

Bridge Engineer  
Approved: 1947

Commissioner of Highways

**BARTON**  
ORLEANS VILLAGE BRIDGE  
S.A. 29-1946

B.M. #1 Spot on step at Post Office. Elev 100.00

Exp & Fixed Ends Reversed  
7/23/48