

INDEX OF SHEETS

SHEET NO.	TITLE PAGE
2	TYPICAL CROSS-SECTION OF IMPROVEMENT (BITUMINOUS CONCRETE PAVEMENT, CLASS 1, ITEM 361-B)
3	BANKING AND WIDENING TABLES
4-8	PLAN AND PROFILE
9	STANDARD STRUCTURE SHEET S-28 PIPE CULVERTS
10	" " " " S-30 WOOD GUARD RAIL
11	" " " " S-30A DRAINAGE STRUCTURES
12	" " " " S-40 BARRICADES, SIGNS & LIGHTS
13	" " " " S-41 ROUNDING OF SLOPES
14	" " " " SC-2-4 BOX CULVERTS
15	" " " " SCW 2-3 INLET & OUTLETS FOR BOX CULVERTS
15A	" " " " SCW 4-5 INLET & OUTLETS FOR 4*5 BOX CULVERTS
16-24	CROSS SECTIONS

STANDARD STRUCTURE SHEETS APPROVED BY THE CHIEF ENGINEER, STATE DEPARTMENT OF HIGHWAYS

S-28 APRIL 26, 1941
 S-30 MAY 12, 1941
 S-30A APRIL 19, 1941
 S-40 DECEMBER 18, 1945


STATE OF VERMONT
 STATE HIGHWAY DEPARTMENT
**PLAN AND PROFILE OF PROPOSED
 STATE HIGHWAY**
 FEDERAL PROJECT

TOWN OF RUTLAND
 U. S. ROUTE 7
 RUTLAND - BENNINGTON ROAD

BEGINNING AT THE RUTLAND CITY LIMIT AND EXTENDING SOUTHERLY 1.180 MILES TO THE RUTLAND-CLARENDON TOWN LINE.

LENGTH OF PROJECT - 6231.0 FEET = 1.180 MILES

FED. ROAD DIST. NO.	STATE	FED. ROAD NO.	FISCAL YEAR	SHEET NO.	TOTAL SHEETS
9	Vt.	22(2)	1947	1	24

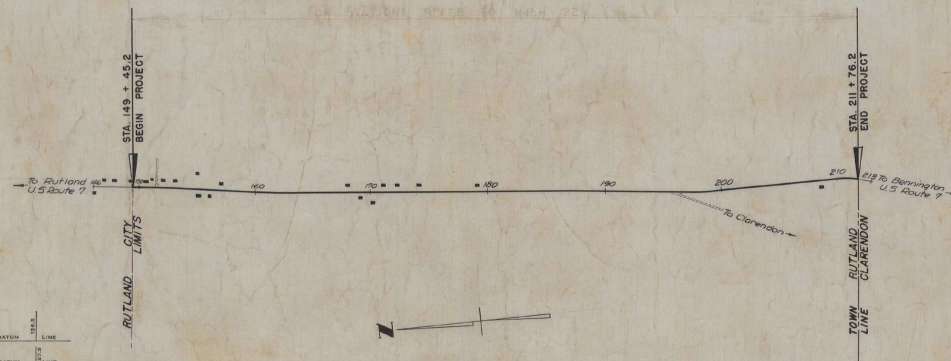

COUNTY LINE	-----
TOWN LINE	-----
FENCE LINE	-----
STONE WALL	-----
UNFENCED PROPERTY	-----
GUARD RAIL	-----
TRAVELED WAY	-----
RAILROAD	-----
RETAINING WALL	-----
CENTER LINE	-----
SURVEY LINE	-----
CULVERT	-----
DROP INLET	-----
TROLLEY POLE	-----
POWER POLE	-----
TELEPHONE POLE	-----
TREES	-----
HEDGE	-----

GROUND ELEVATION	BATHYM	LINE
GRADE ELEVATION	BATHYM	LINE

CURVE DATA	
DEFLECTION ANGLE	Δ
DEGREE OF CURVE	D
RADIUS OF CURVE	R
TANGENT DISTANCE	T
LENGTH OF CURVE	L
EXTERNAL DISTANCE	E
POINT OF INTERSECTION	P. I.
POINT OF CURVE	P. C.
POINT OF TANGENT	P. T.
POINT ON TANGENT	P. O. T.

SCALES	
TITLE	1" = 500'
TYPICAL	1" = 2'
PLAN	1" = 50'
PROFILE HORIZONTAL	1" = 50'
PROFILE VERTICAL	1" = 10'
CROSS SECTIONS	1" = 5'

APPROVED: February 16, 1948
H. August
 COMMISSIONER OF HIGHWAYS
 SUBMITTED BY ORDER OF THE STATE HIGHWAY BOARD

RECOMMENDED FOR APPROVAL

DISTRICT ENGINEER
 PUBLIC ROADS ADMINISTRATION
 FEDERAL WORKS AGENCY

APPROVED

DISTRICT ENGINEER
 PUBLIC ROADS ADMINISTRATION
 FEDERAL WORKS AGENCY


APPROVED Feb 16, 1948
H. August
 HIGHWAY ENGINEER

APPROVED Aug 1, 1947
H. August
 DISTRICT HIGHWAY COMMISSIONER

SERIES F No. 22(2) FILED
 SHEET 1 OF 24


TYPICAL SECTIONS

BITUMINOUS CONCRETE PAVEMENT, CLASS I ITEM 361-B

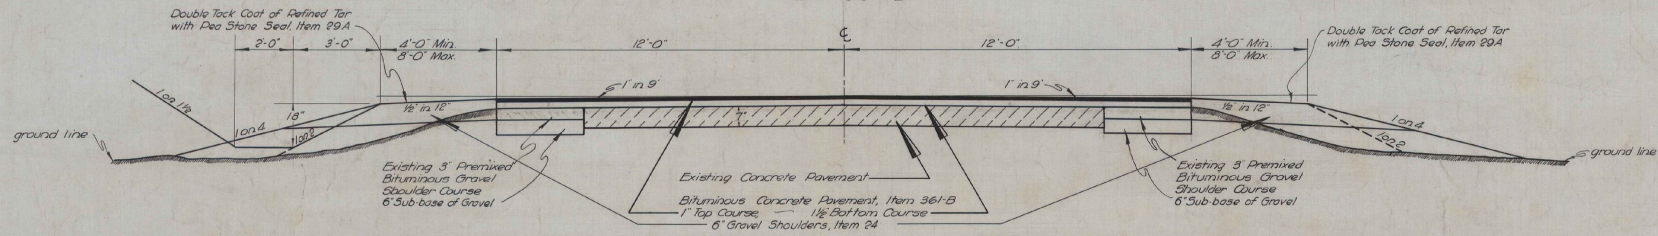

NORMAL SECTION

NOTE: Bituminous Concrete Pavement shall be paid for on a ton basis.

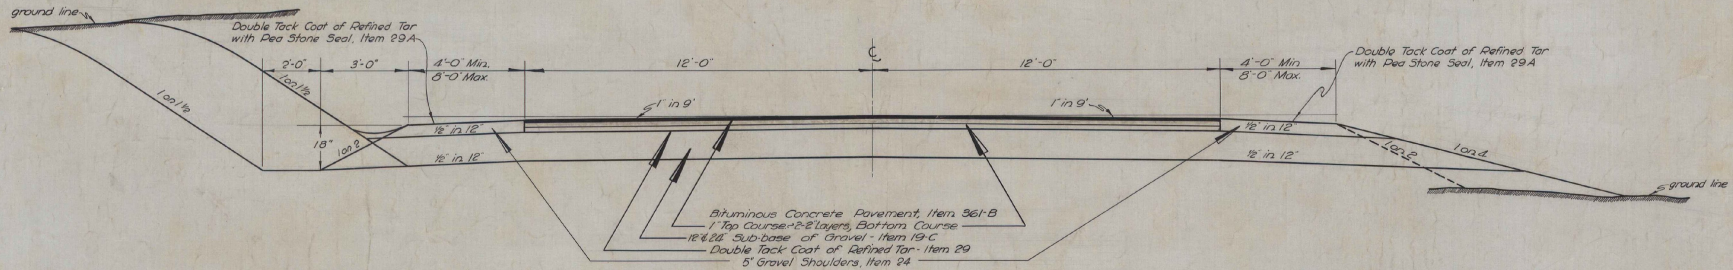

SECTION SHOWING SUB-BASE OF GRAVEL

12" SUB-BASE STA. 151+55 TO STA. 152+55
12" SUB-BASE STA. 156+70 TO STA. 170+00
24" SUB-BASE STA. 204+37.9 TO STA. 211+76.2

NOTE:
Bituminous Concrete Pavement, Gravel Shoulders and Guard Rail are to be constructed by Force Account.


DOUBLE TACK COAT OF REFINED TAR WITH PEA STONE SEAL ON SHOULDERS

STA	STA	4' WIDTH		8' WIDTH	
		LT	RT	LT	RT
149+42.2	155+50	604.8'	604.8'		
155+50	159+00		250.0'		
155+50	159+00			3350.0'	
156+00	211+76.2				5376.2'
159+00	197+00	800.0'			
197+00	200+00			300.0'	
200+00	204+00	400.0'			
204+00	211+76.2			776.2'	


SCALE: 1 INCH=2 FEET


RUTLAND

Surveyed by
Designed by
Drawn by E. Rogers
Traced by E. Rogers
Checked by
Series F No. 22(2) Filed
Sheet 2 of 24 Sheets


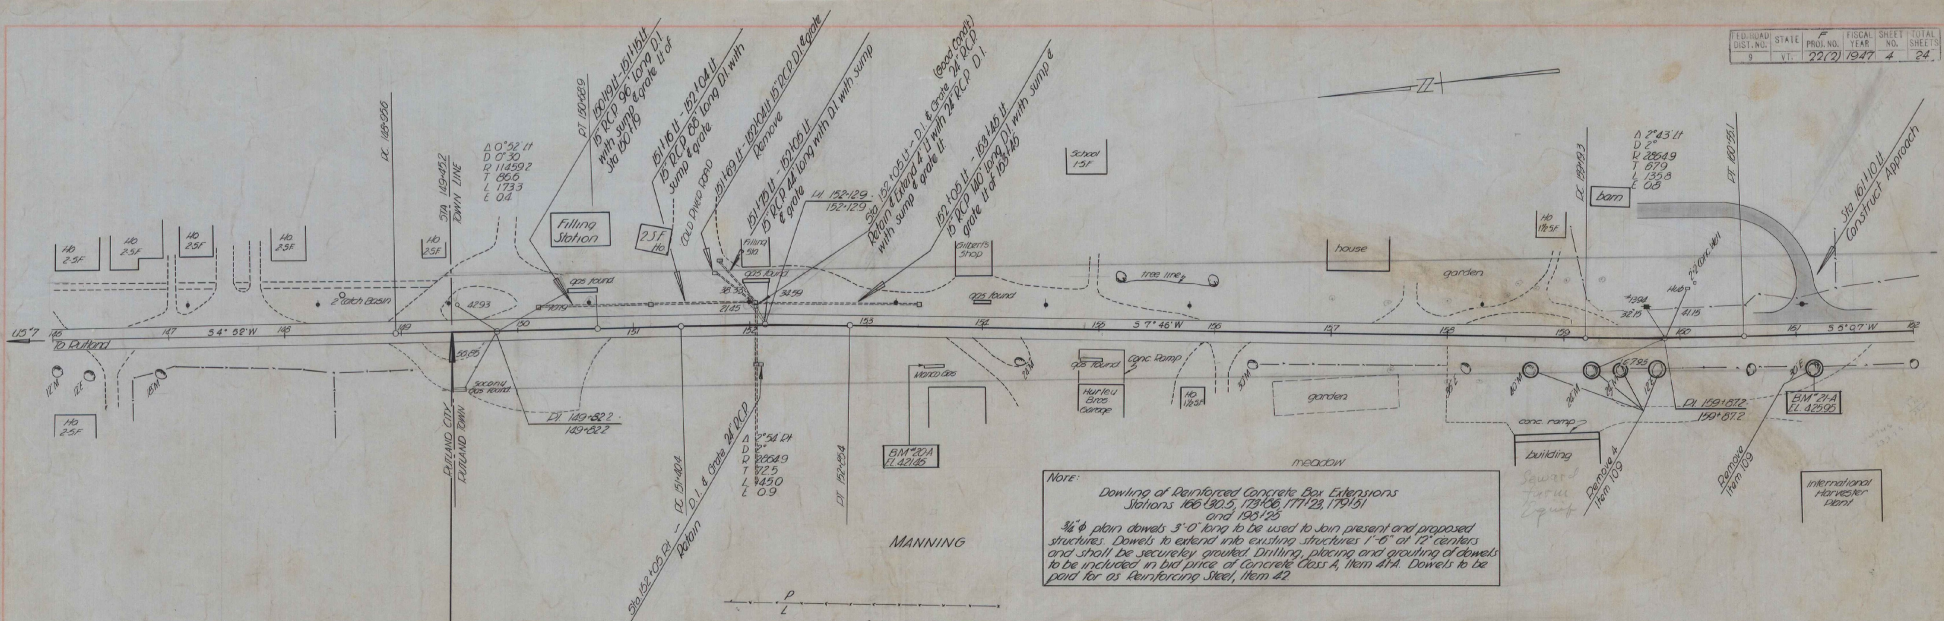


STA. 149 + 45.2
 BEGIN PROJECT F 22(2)

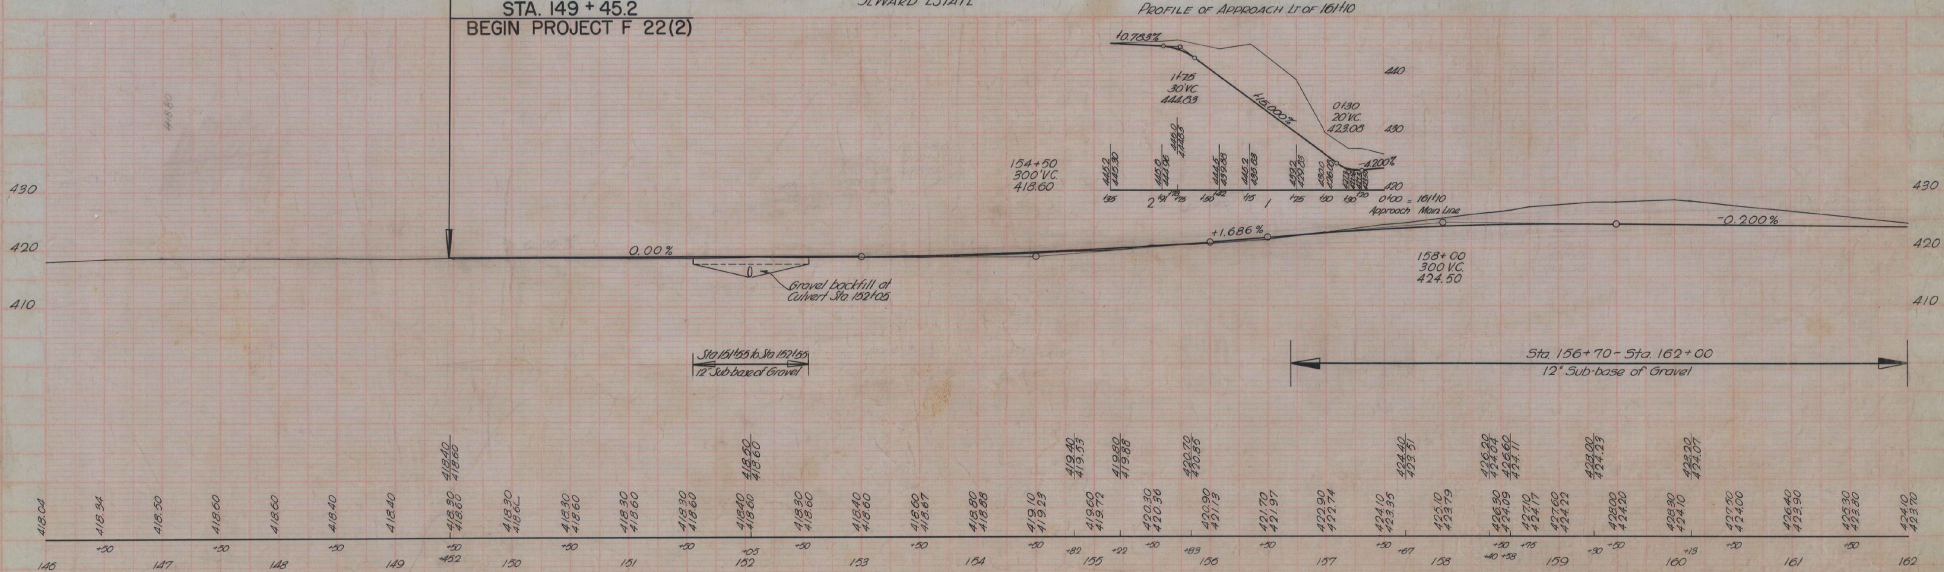


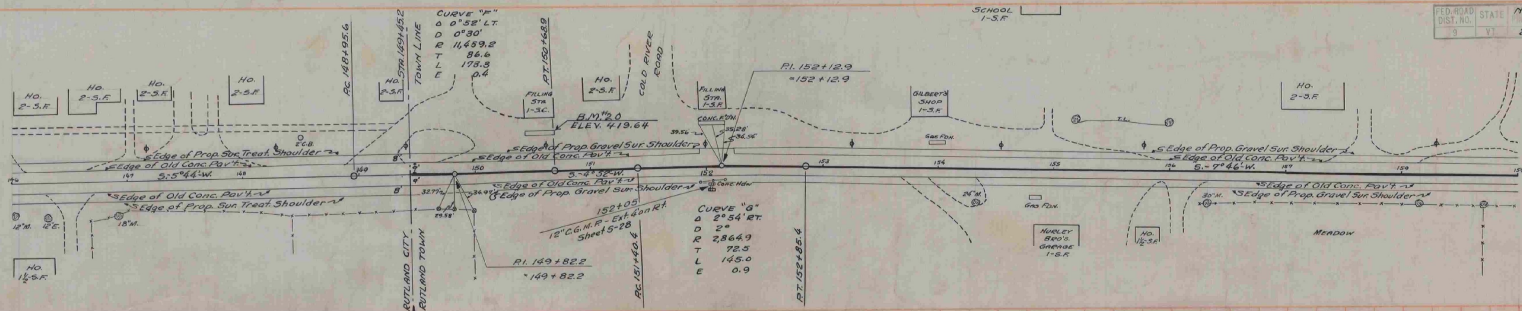


B.M. #20 SPOT ON CONC. FOUNDATION 33 FT. LT. STA. 150+70. ELEV. 413.64

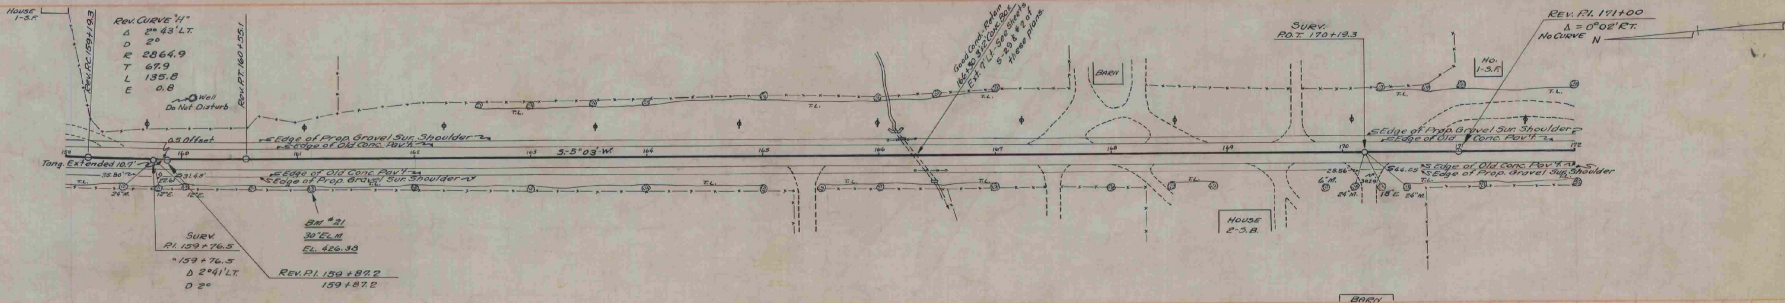
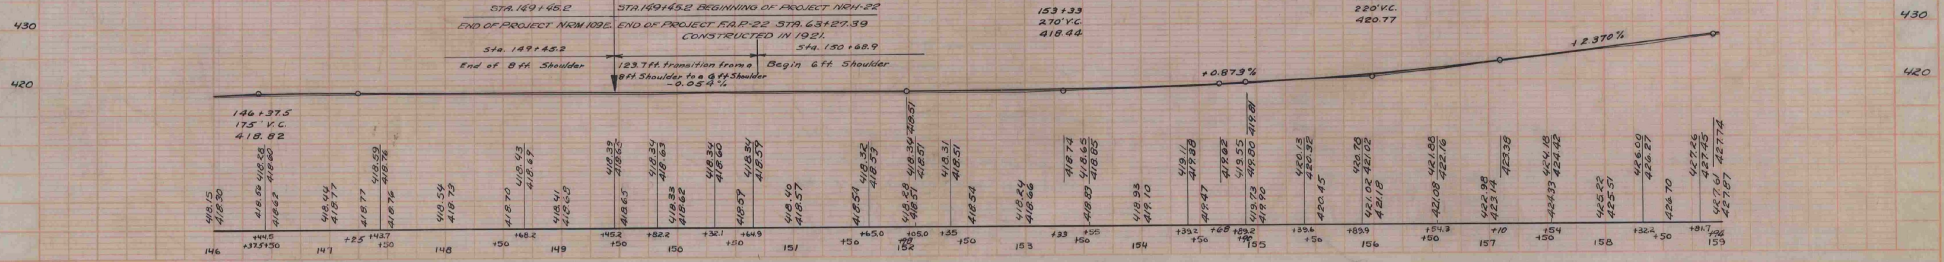


B.M. #1 SPARK IN ROOT 30' ELM 25 FT. RT. STA. 161+11 - EL. 426.38

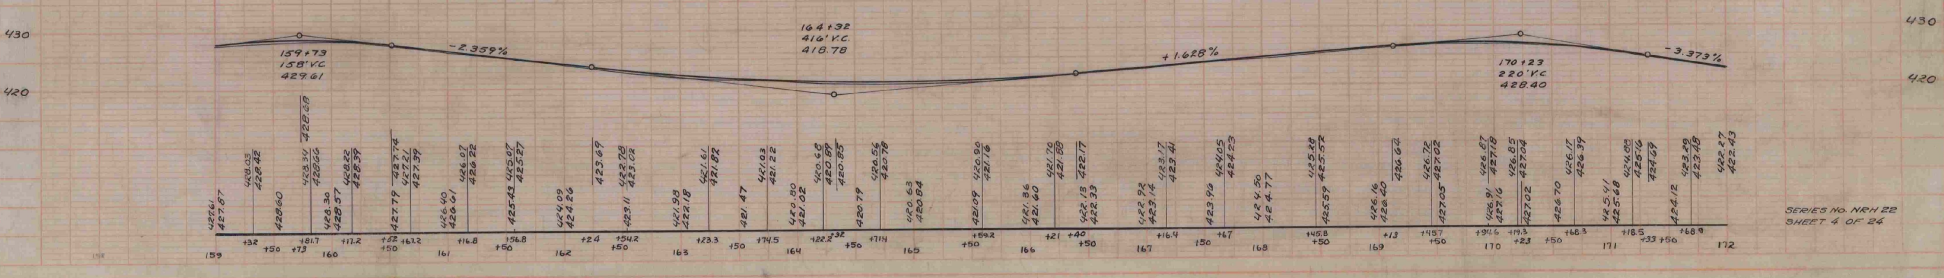


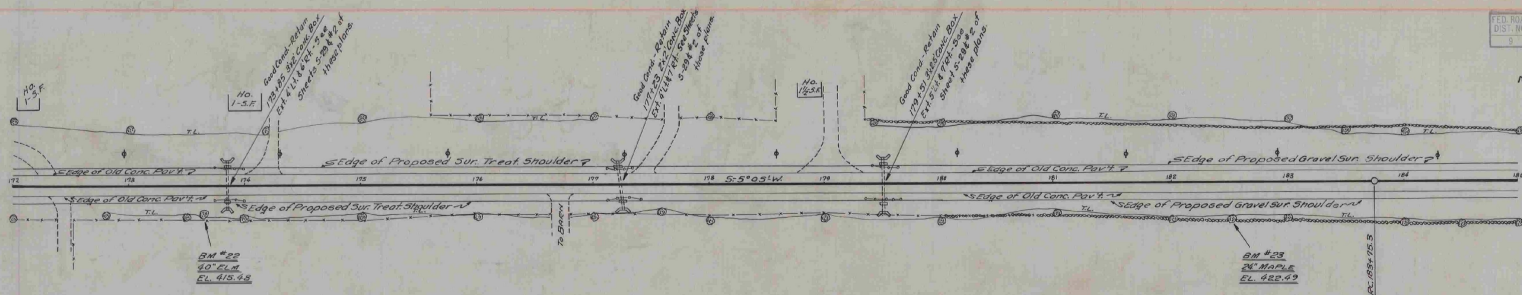



BM #22 SPIKE IN ROOT 40' ELM 23 FT RT STA. 173+65 EL. 415.48
 BM #28 " " " 24' MAPLE 30 FT RT STA. 182+50 EL. 422.49

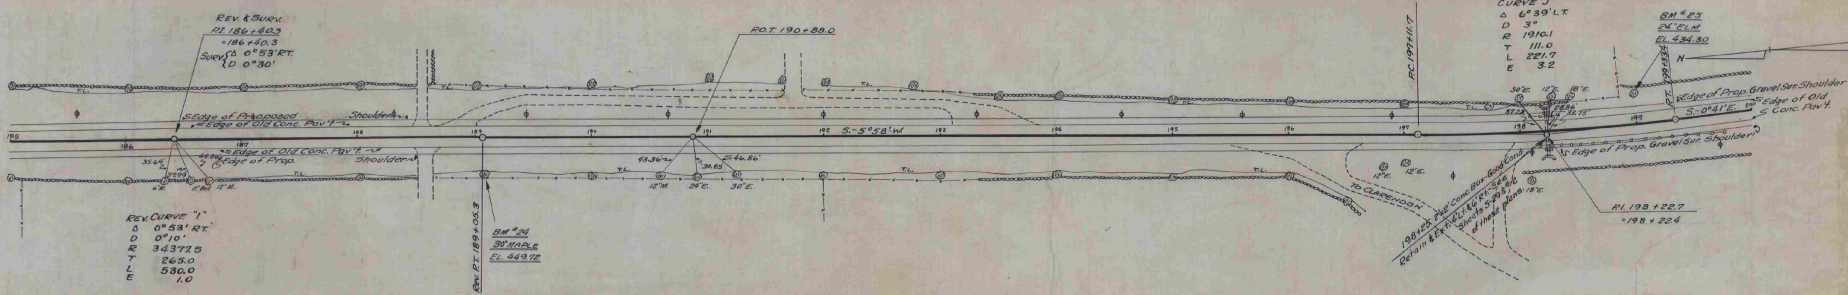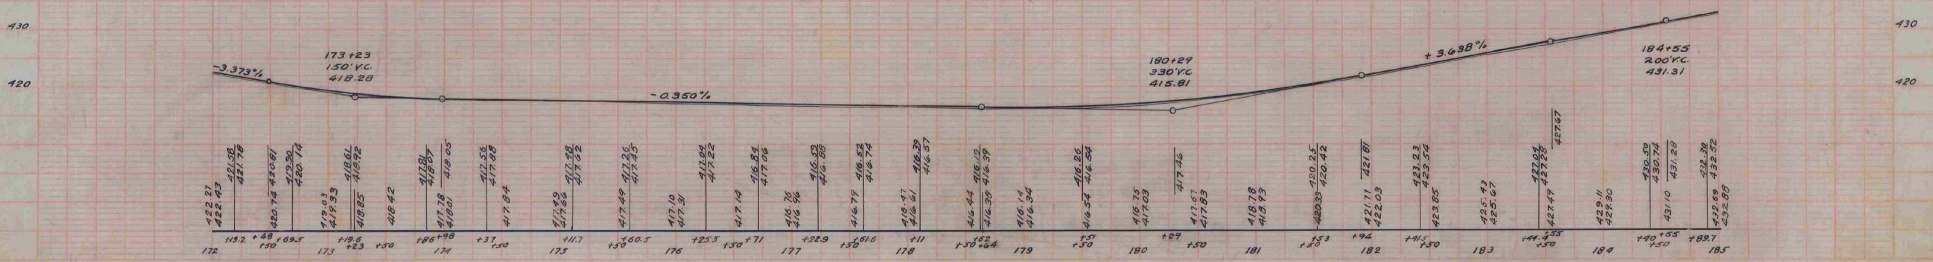


BM #24 SPIKE IN ROOT 30' MAPLE 29 FT RT STA. 189+07 EL. 449.72
 BM #25 " " " 24' ELM 33 FT LT STA. 199+00 EL. 438.30

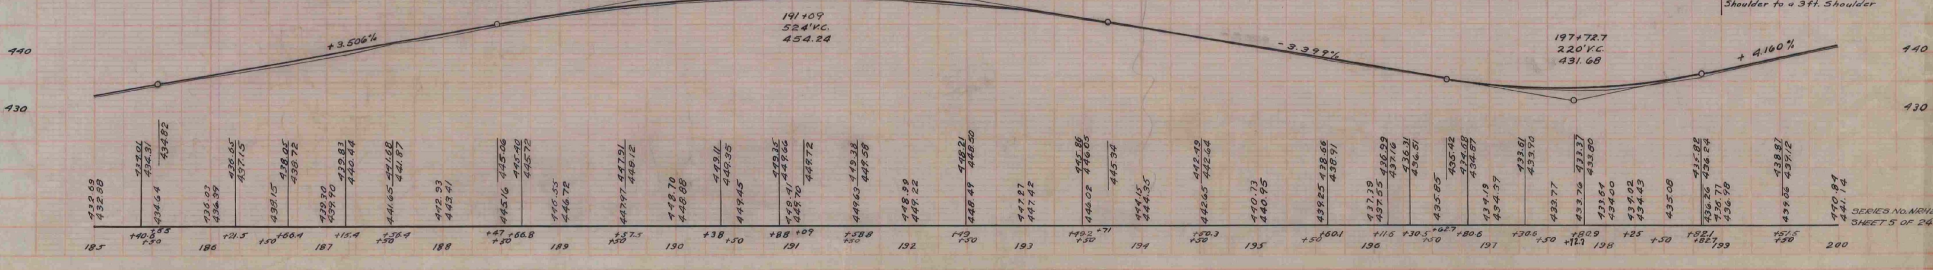

PLAN
 DATE: 12/15/47
 DRAWN BY: [Name]
 CHECKED BY: [Name]
 SCALE: 3/16"

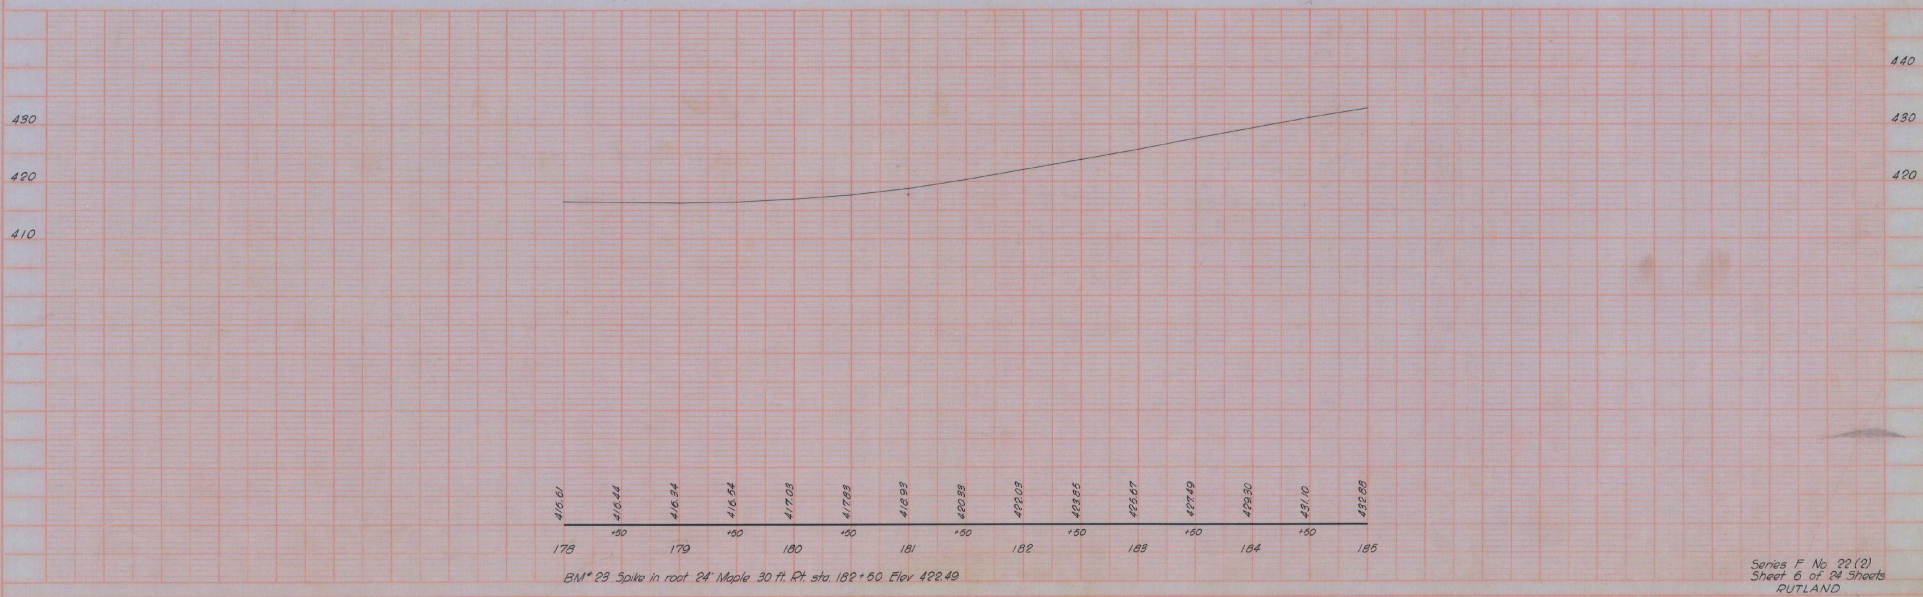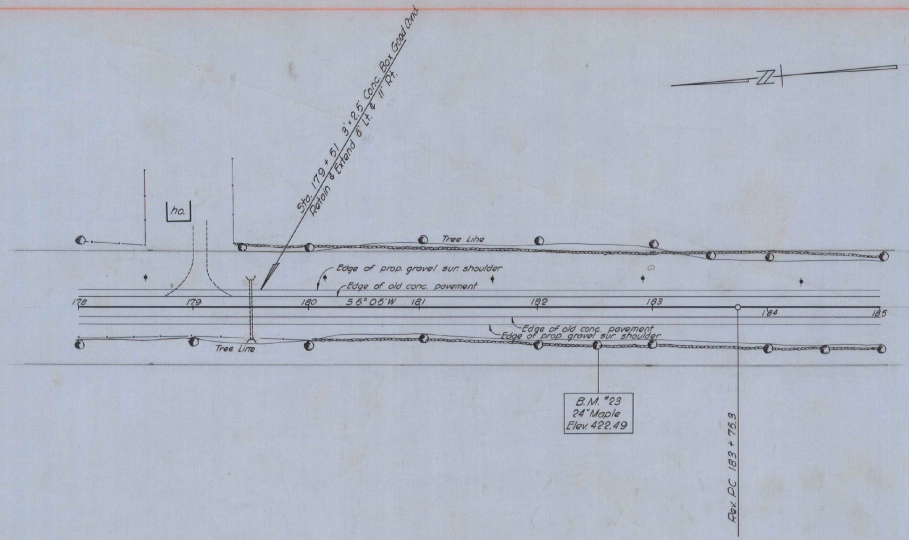

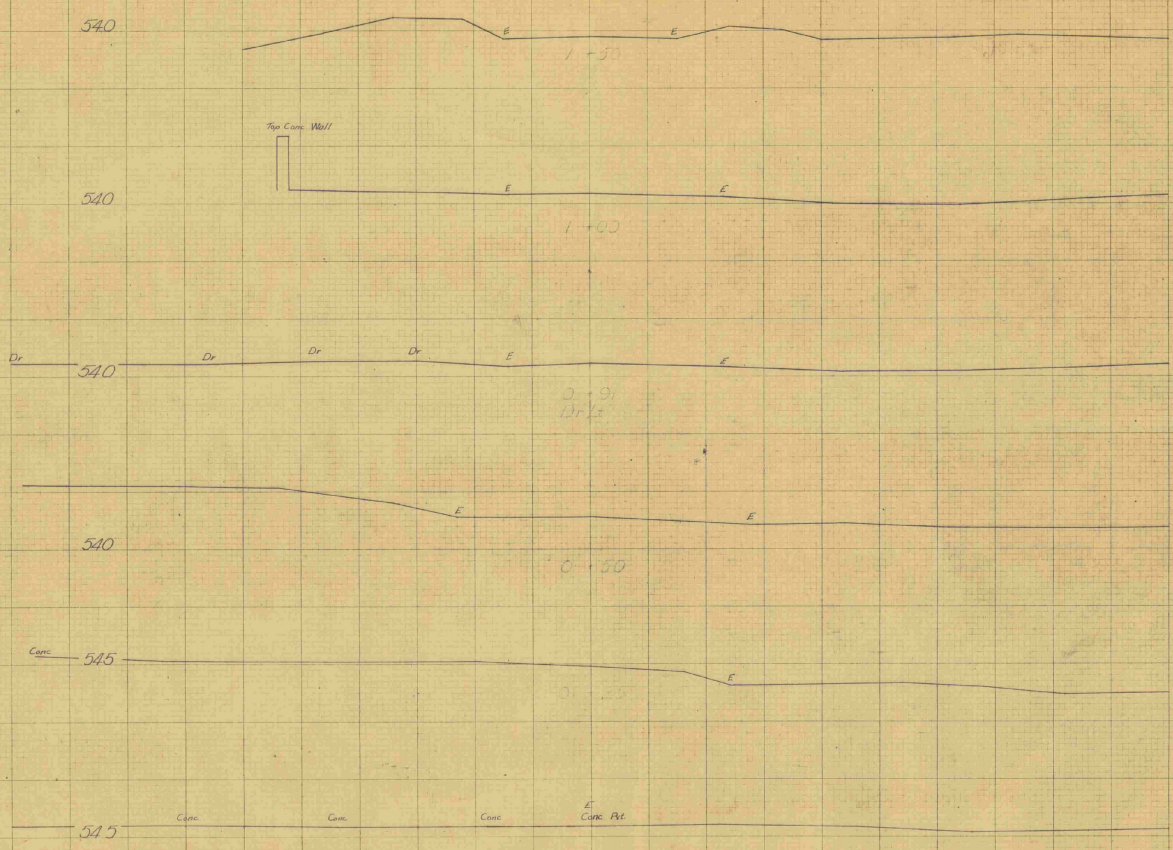


RUILAND SIDE LINE
RIPLEY POND


LEVELS BY Pagan 10-26
 SECTIONS PLOTTED BY Crosswell CKD. BY 10/26/00
 PLANIMETER 31 CKD. BY
 EXAMINED BY NO. FILED
 SHEET OF

2

PLAN
 10/25/47
 3448
 Author
 Designer
 Checker
 Engineer

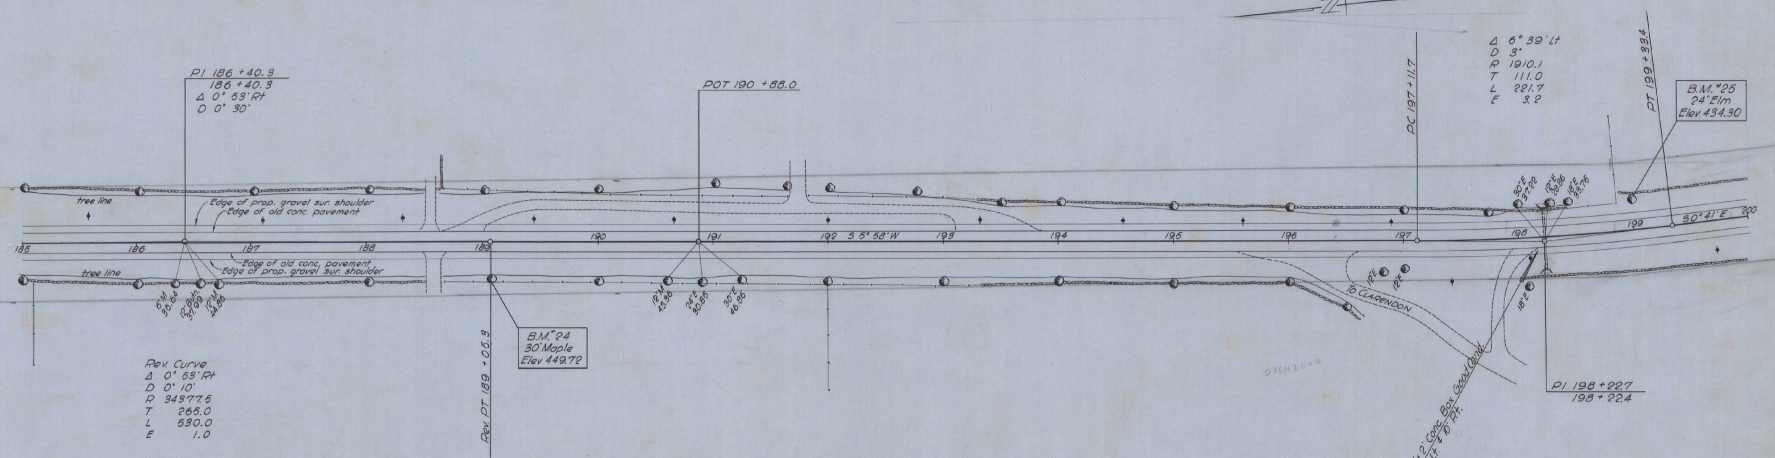

PLAN
 10/25/47
 3448
 Author
 Designer
 Checker
 Engineer

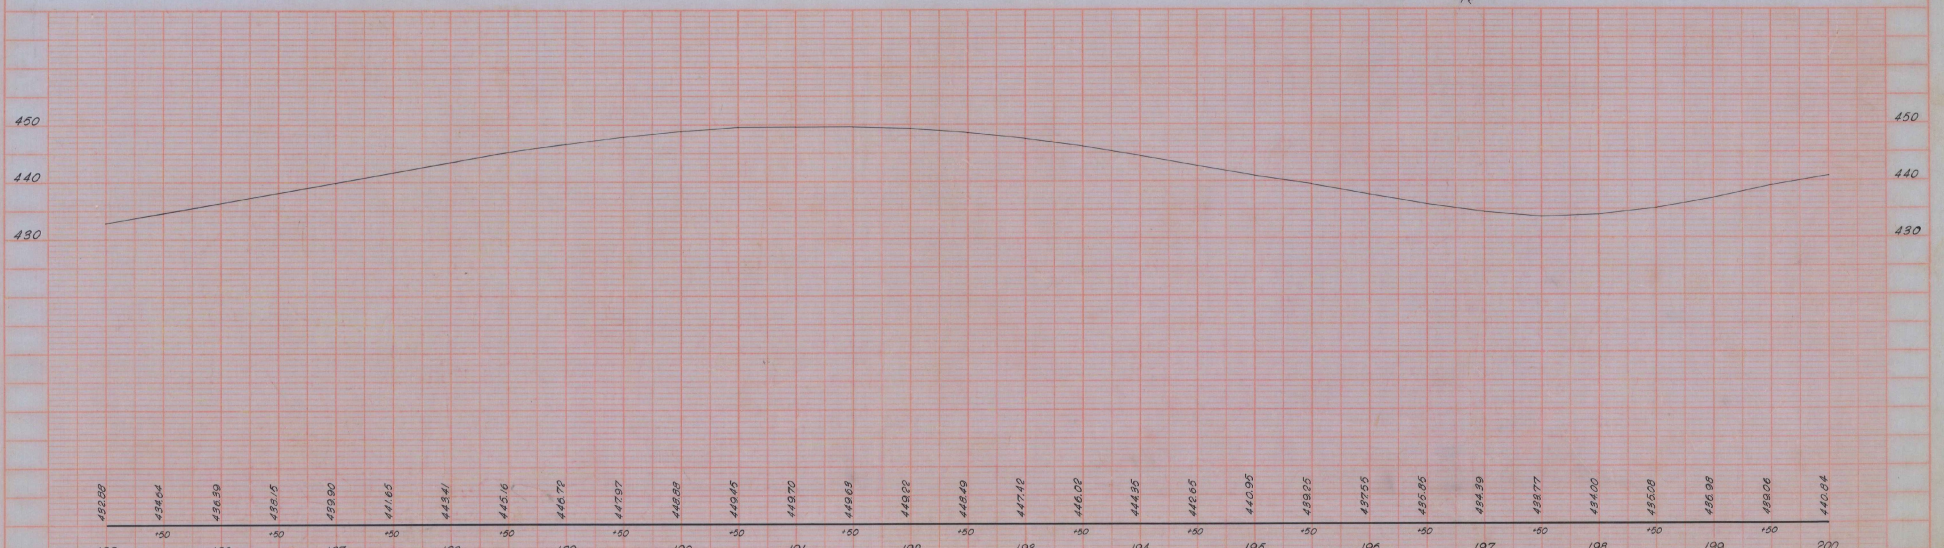

B.M. #4 Spike in root 30' Maple 29 ft. sta. 189+07 Elev 449.72
 B.M. #25 Spike in root 24' Elm 35 ft. sta. 199+00 Elev 434.30

INDEX OF SHEETS

SHEET NO.	TITLE	PAGE
1	TYPICAL CROSS-SECTION OF IMPROVEMENT	
2	BANKING AND WIDENING TABLES	
3	PLAN AND PROFILE	

STATE OF VERMONT
STATE HIGHWAY DEPARTMENT

PLAN AND PROFILE OF PROPOSED
STATE HIGHWAY

FEDERAL AID PROJECT

TOWN OF RUTLAND
U. S. ROUTE 7
RUTLAND - BENNINGTON ROAD


BEGINNING AT THE RUTLAND CITY LIMIT AND EXTENDING
SOUTHERLY 1.180 MILES TO THE RUTLAND-CLARENDON
TOWN LINE.

LENGTH OF PROJECT - 6231.0 FEET = 1.180 MILES

FED. PROJ. NO.	STATE	DISTRICT	LOCAL	ROUTE	SHEET	TOTAL
9	VT.					



Scale: 1 inch = 1 mile

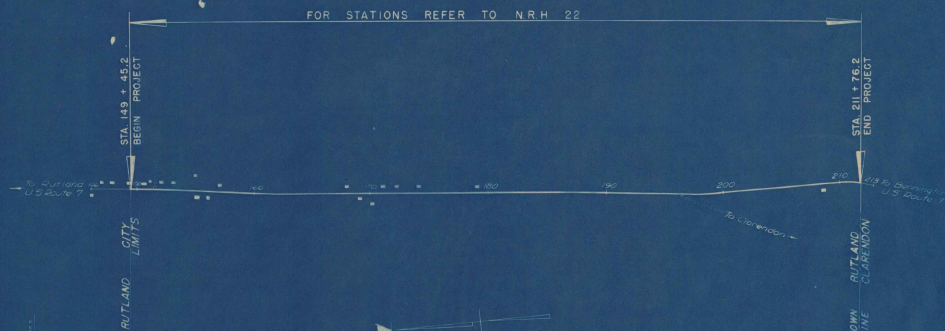

APPROVED: _____
COMMISSIONER OF HIGHWAYS
SUBMITTED BY ORDER OF THE STATE HIGHWAY BOARD

COUNTY LINE	— — — — —
TOWN LINE	— — — — —
FENCE LINE	— — — — —
STONE WALL	— — — — —
UNFENCED PROPERTY	— — — — —
GUARD RAIL	— — — — —
TRAVELED WAY	— — — — —
RAILROAD	— — — — —
RETAINING WALL	— — — — —
CENTER LINE	— — — — —
SURVEY LINE	— — — — —
CULVERT	— — — — —
DROP INLET	— — — — —
TROLLEY POLE	— — — — —
POWER POLE	— — — — —
TELEPHONE POLE	— — — — —
TREES	— — — — —
HEDGE	— — — — —

GROUND ELEVATION	— — — — —
GRADE ELEVATION	— — — — —

CURVE DATA		SCALES	
DEFLECTION ANGLE	D	TITLE	1" = 100'
DEGREE OF CURVE	D	PLAN	1" = 100'
RADIUS OF CURVE	R	PROFILE	1" = 100'
TANGENT DISTANCE	T	ROSS SECTIONS	1" = 100'
LENGTH OF CURVE	L		
EXTERNAL DISTANCE	E		
POINT OF INTERSECTION	P. I.		
POINT OF CURVE	P. C.		
POINT OF TANGENT	P. T.		
POINT ON TANGENT	P. O. T.		

THESE PLANS ARE SUBJECT TO SUCH REVISIONS AS MAY BE REQUIRED BY THE PUBLIC ROADS ADMINISTRATION OR THE COMMISSIONER OF HIGHWAYS.

CONSTRUCTION IS TO BE CARRIED ON IN ACCORDANCE WITH THE PLANS AND THE STANDARD ROAD AND BRIDGE SPECIFICATIONS OF 1936, AS APPROVED DECEMBER 29TH, 1936, BY THE PUBLIC ROADS ADMINISTRATION, INCLUDING ALL SUBSEQUENT APPROVED REVISIONS, AND SUCH REVISED SPECIFICATIONS AND SPECIAL PROVISIONS AS ARE SUBMITTED WITH THE PLANS.

RECOMMENDED FOR APPROVAL

DISTRICT ENGINEER
PUBLIC ROADS ADMINISTRATION
FEDERAL ROAD AGENCY


APPROVED

UNIVERSITY ENGINEER
PUBLIC ROADS ADMINISTRATION
FEDERAL ROAD AGENCY

APPROVED	APPROVED	SERIES F. NO.	FILED
	DISTRICT HIGHWAY COMMISSIONER	SHEET 1 OF	


TYPICAL SECTIONS

BITUMINOUS CONCRETE PAVEMENT, CLASS I
ITEM 361-B

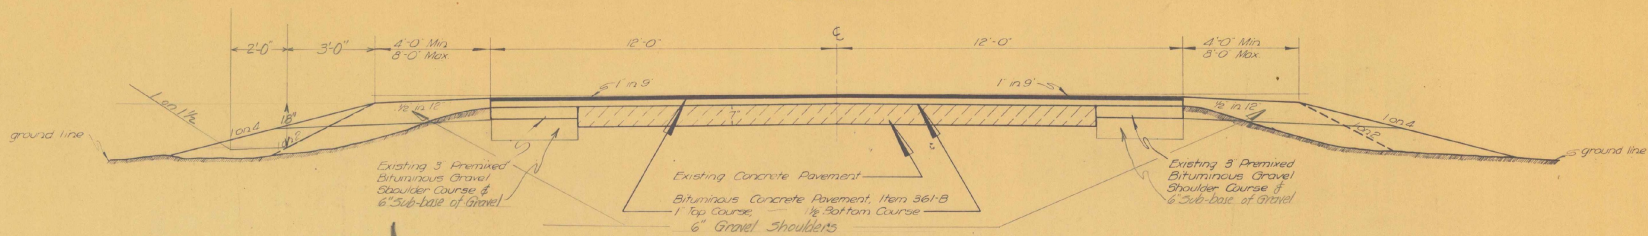

NORMAL SECTION

NOTE: Bituminous Concrete Pavement shall be paid for on a ton basis.

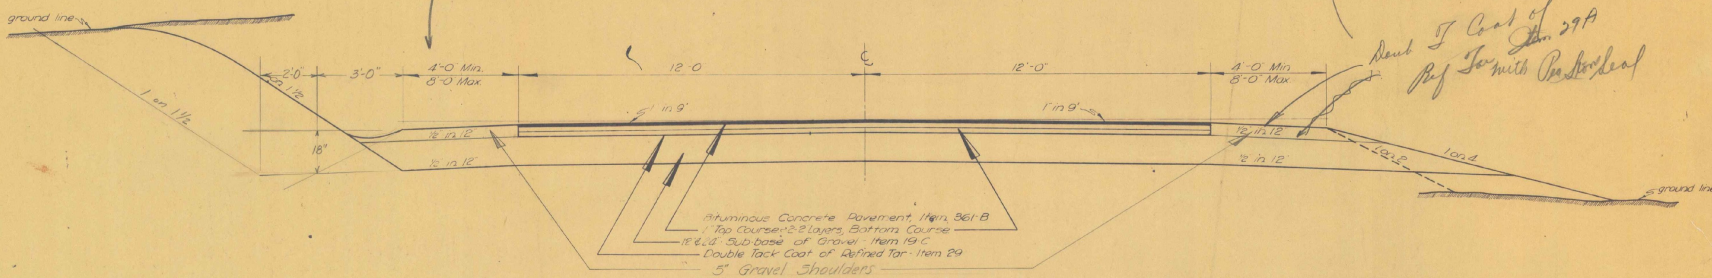

SECTION SHOWING SUB-BASE OF GRAVEL

151+55 152+55
12" SUB-BASE STA. 156+70 TO STA. 170+00
24" SUB-BASE STA. 204+00 TO STA. 211+762

*Dept of Cont of Jan 29A
Prof Fox with Res Deal*

*Note:
Bituminous Concrete Pavement, gravel
shoulders and base are to be
constructed by Force Account.*

RUTLAND

Surveyed by
Designed by
Drawn by E. Rogers
Traced by E. Rogers
Checked by
Series F No. 22(2) Filed
Sheet 2 of 17 Sheets

APPROXIMATE SUMMARY OF QUANTITIES				DETAILED SUMMARY OF QUANTITIES				TYPE OF CONSTRUCTION <i>Bituminous Concrete Pavement Class 1, Item 361B</i>							
QUANTITIES	UNIT	ITEMS	ITEM NO.	QUANTITIES	UNIT	ITEMS	STATIONS	PAVEMENT WIDTHS		EQUATIONS					
							FROM	TO			+ -				
600	cy	Solid Rock Excavation	10			SOLID ROCK EXCAVATION			24'						
8900	cy	Common Excavation	10	549	cy	Removal of Concrete Pavement	149+452	211+762	6231.0						
400	cy	Trench Excavation of Earth	12A	53		Overrun									
70	cy	Trench Excavation of Rock	12B	600		Total									
8500	cy	Sub-base of Gravel	19C	8113	cy	COMMON EXCAVATION									
3600	gal	Double Tack Coat of Refined Tar	29	787		Roadway									
60	cy	Concrete Class B	41A	8900		Overrun									
6400	lb	Reinforcing Steel	42			Total									
	cy	Cement Bubble Masonry	45	27	cy	TRENCH EXCAVATION OF EARTH									
		includes		1	cy	Box Culverts Box Culverts									
				360	cy	Changing Elevation of Manholes on G.H. Box									
						Underdrain									
14	18"	Corr Galv Metal Pipe Asphalt Coated	52D	73		Overrun									
14	18"	Corr Galv Metal Pipe Asphalt Coated	52E	400		TOTAL									
14		Standard Underdrain with 6" ECOMPAQ	72A			TRENCH EXCAVATION OF ROCK									
14		Wood Guard 12011	75	12	cy	Box Culverts									
20		Changing Elevation of Manholes on Catch Basins	89	47	cy	Pipe Culverts									
20		Cutting & Removing Traps & Overruns	123			Underdrain									
8260	sq	Cleaning Existing Pavement	120	10	cy	Overrun									
5472	14	Preparing Transverse Joints	121	70	cy	Total									
3150	ten	Bituminous Concrete Pavement	361B			SUB-BASE OF GRAVEL									
				7721	cy	Roadway									
				100	cy	Approaches									
				679	cy	Overrun									
				8300	cy	Total									
						DOUBLE TACK COAT OF REFINED TAR									
				3258	gal	Roadway									
				342	gal	Overrun									
				3600	gal	Total									
						CONCRETE CLASS A									
				835	cy	Box Culverts									
				65	cy	Overrun									
				800	cy	Total									
						REINFORCING STEEL									
				5855	lb	Box Culverts									
				545	lb	Overrun									
				6400	lb	Total									
						CLEANING EXISTING PAVEMENT									
				10722	sq	Roadway									
						Overrun									
						Total									
						BITUMINOUS CONCRETE PAVEMENT									
				3688	ten	Roadway									
				62	ten	Overrun									
				3150	ten	Total									
TOTALS									6231.0						
LENGTH OF PROJECT															
STATIONS								FEET				MILES			
149+452								211+762				6231.0		1.180	
TOTALS								6231.0				1.180			
SERIES								F		NO. 22(2)		FILED			
SHEET								2		OF 2		SHEETS			

COMPAR
C-214

W.C.P.
1994

6770
6970

Rutland

F. A. P. No. 22 (2)

FORM ENG. 1A

EARTHWORK SHEET NO. /

19 47

REVISIONS	By	PROFILE																REVISIONS	By															
		V.C.	% Grade	STATION	ELEVATION		Correction for Vertical Curve	DIST.	Total Excavation Earth and Rock		Balance and Rock Excavation		Embankment		Shaping Course of Gravel		V.C.			% Grade	STATION	ELEVATION		Correction for Vertical Curve	DIST.	Total Excavation Earth and Rock		Balance and Rock Excavation		Embankment		Shaping Course of Gravel		
					On Grades	On V Curves			AREA	CU. YDS.	AREA	CU. YDS.	AREA	CU. YDS.	AREA	CU. YDS.						AREA	CU. YDS.			On Grades	On V Curves	AREA	CU. YDS.	AREA	CU. YDS.	AREA	CU. YDS.	AREA
		146																158+58	424.38	424.11	-0.27	17	276	189	11	7	7	4	49	32				
		+50																+75	424.35	424.17	-0.18	25	325	308	11	10	7	6	51	47				
		147	418.60															159	424.30	424.22	-0.08	30	341	378	11	12	7	8	51	57				
		+50	418.60															+30	424.24	424.23	-0.01	20	340	230	11	8	7	5	52	34				
		148	418.60															+50	424.20		0	50	280	510	11	20	7	13	41	76				
		+50	418.60															160	424.10			13	271	510	11	20	7	13	41	76				
		149	418.60															+13	424.07			37	286	134	11	5	7	3	41	20				
		+452	418.60															+50	424.00			50	232	353	11	15	7	10	41	56				
		+50	418.60				48	1	1									161	423.90			50	210	409	11	20	7	13	41	76				
		150	418.60				50	1	3									+50	423.90			50	182	307	11	20	7	13	45	80				
		+50	418.60				50	2	4									162	423.70			50	78	185	11	20	7	13	42	81				
		151	418.60				50	2	4									+50	423.60			50	28	98	11	20	7	14	46	81				
		+50	418.60				50	2	4									163	423.50			50	0	26	11	20	7	14	46	81				
		152	418.60				50	1	3									+50	423.40			50	C	1512	8	15	56	70	15	88				
		+05	418.60				50	2	2									164	423.30			50	R	110	8	15	100	144	49	91				
		+50	418.60				50	1	3									+50	423.20	423.26	+0.06	50	F	656	8	15	120	204	49	91				
		153	418.60				50	2	3									165	423.10	423.34	+0.24	50	Gr.Sh.	141	8	15	120	219	49	91				
		+50	418.60	418.67	+0.07		50	3	5									166	423.00	423.55	+0.55	50	S.B.	846	8	15	116	220	49	91				
		154	418.60	418.88	+0.28		50	3	6									+50	423.00	423.55	+0.55	50	Fact.	110	8	15	122	233	49	91				
		+50	418.60	419.23	+0.63		50	3	6									166	423.63	423.87	+0.24	10	8	15	8	3	130	55	49	19				
		+82	419.14	419.53	+0.39		32	3	4									+10	423.76	423.96	+0.20	40	8	12	8	3	166	55	56	77				
		155	419.44	419.72	+0.28		18	1	1									130.5	424.02	424.14	+0.12	40	C	135	8	12	235	48	94					
		+22	419.81	419.98	+0.17		22	2	2									+50	424.27	424.33	+0.06	50	F	1026	8	15	151	194	53	94				
		+50	420.29	420.36	+0.07		28	3	3									167	424.90		0	50	Gr.Sh.	142	8	14	58	71	51	96				
		+83	420.84	420.85	+0.01		33	2	4									+50	425.83			25	S.B.	851	7	6	19	13	52	48				
		156	421.13	0			17	5	3									+75	425.85			25	Fact.	110	0	7	6	10	5	46				
		+50	421.97	0			6	3	3									168	426.17			25	Ex.C.	2542	7	6	10	5	48	46				
		157	422.82	422.74	-0.08		50	3	8									+50	426.80			50	1	8	7	14	0	5	48	82				
		+50	423.66	423.35	-0.31		50	72	0									+62.5	426.96			50	0	8	8	14	8	41	67					
		167	423.94	423.51	-0.43		92	155	11									169	427.43	427.32	-0.11	50	9	43	7	14	7	14	31	66				
		+40	424.42	424.04	-0.38		17	75	11									+50	428.07	427.47	-0.60	50	37	8	8	14	8	40	66					
		+50	424.40	424.09	-0.31		33	197	11									170	428.70	427.22	-1.48	50	52	82	7	14	7	40	74					
		158	424.50	423.79	-0.71		144	11	13									+12.5	428.86	427.13	-1.73													
		+50	424.40	424.04	-0.36		40	264	11									+19.3	428.63	427.04	-1.59													
		+50	424.40	424.09	-0.31		10	86	11									+25	428.44	426.96	-1.48													
		159	424.38	424.11	-0.27		8	78	11									+50	427.61	426.63	-0.98													
		+58	424.38	424.11	-0.27		276	11										+68.3	427.00	426.31	-0.69													
		CARRIED FORWARD							927	73	66							CARRIED FORWARD																
		COLUMN FOOTINGS							973	73	145								COLUMN FOOTINGS							3262	167	319	1682	1943				

STA 149+452
BEGIN PROJECT F 22 (2)


C 42
Gr.Sh 71
S.B. 92
Fac. 110
Ex.C. 42

Gr.Sh. 15
S.B. 19
Fac. 20
Ex.C. 70

C 135
F 1026
Gr.Sh. 142
S.B. 851
Fac. 110
Ex.F. 994


GRADES	VERTICAL CURVES	COMPUTED BY	CHECKED BY	SUMMARY OF BALANCES										SHAPING COURSE OF GRAVEL CU. YDS.	
				STATION TO STATION		TOTAL EXCAV. EARTH & ROCK CU. YDS.	ROCK EXCAV. CU. YDS.	EMBANKMENT CU. YDS.	EXCESSES		ACCUMULATIVE EXCESSES		GRAVEL SHOULDER CU. YDS.		SHAPING COURSE OF GRAVEL CU. YDS.
				CUT	FILL	CUT	FILL	CUT	FILL	CUT	FILL	CUT	FILL		
				149+45.2	150+00	4							8	18	
				150+00	155+00	42							71	92	
				155+00	160+00	2542	130						102	553	
				160+00	165+00	1512	110	656					141	846	
				165+00	170+00	135	0	1026					142	851	
				170+00	204+00	(2794)	107	1605	Estimated				832	837	
				204+00	205+00	191	13	17					24	295	
				205+00	210+00	1740	157	47					124	1689	
				210+00	211+762	770	77	0					38	597	
				Total		9730	594	3351					1484	5778	
				149+45.2	170+00	6936	487	1746					652	4941	
				204+00	211+762								832	837	
				170+00	204+00	2794	107	1605							
				Grand Total		9730	594	3351					1484	5778	

SHEET NO.	COL. NO.	SUMMARY BY COLUMNS				REMARKS
		EXCAVATION		EMBANKMENT	SHAPING COURSE OF GRAVEL	
		TOTAL CU. YDS.	ROCK CU. YDS.	CU. YDS.	CU. YDS.	
						Total Excav. (Earth and Rock) 9730
						Total Rock Excav. (178 cu. Avail. Removal) 594
						Bal. Earth Excav. 9136
						EXC. 151+55 - 152+55 118
						Total 9254
						Total Planim. Fill 3351
						Factor 110
						Total Excav. (Earth and Rock). 3686
						Borrow
						Shaping Course + 118 CU (151+55 - 152+55) 5896
						Gravel Shoulders 1483
						Total Excav. (Earth and Rock) 9730
						Total Fill incl. Factor 3686
						Excess cut 6044

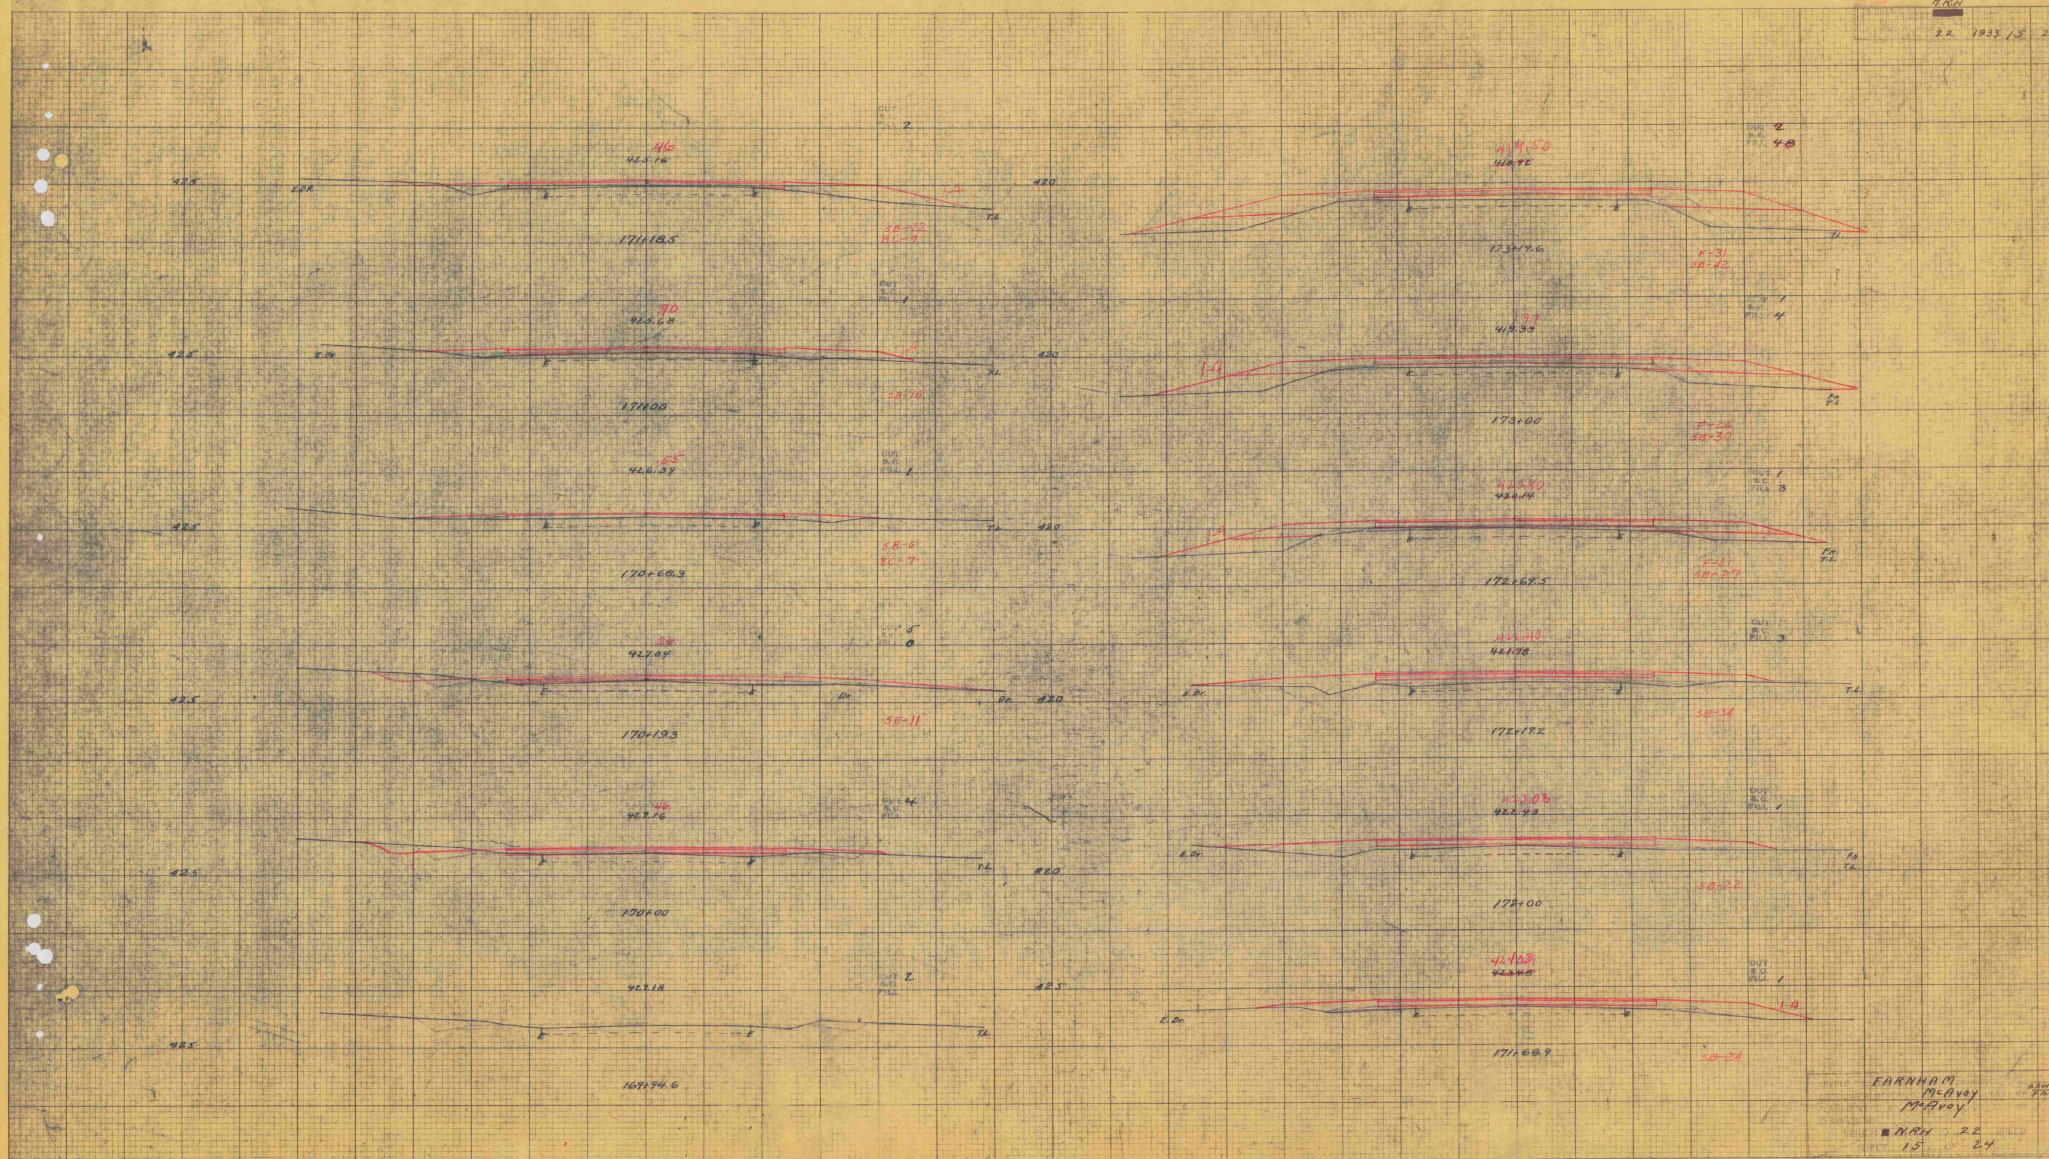

EARNHAM
 McAvoy
 15 24



22 1933 / 6 24

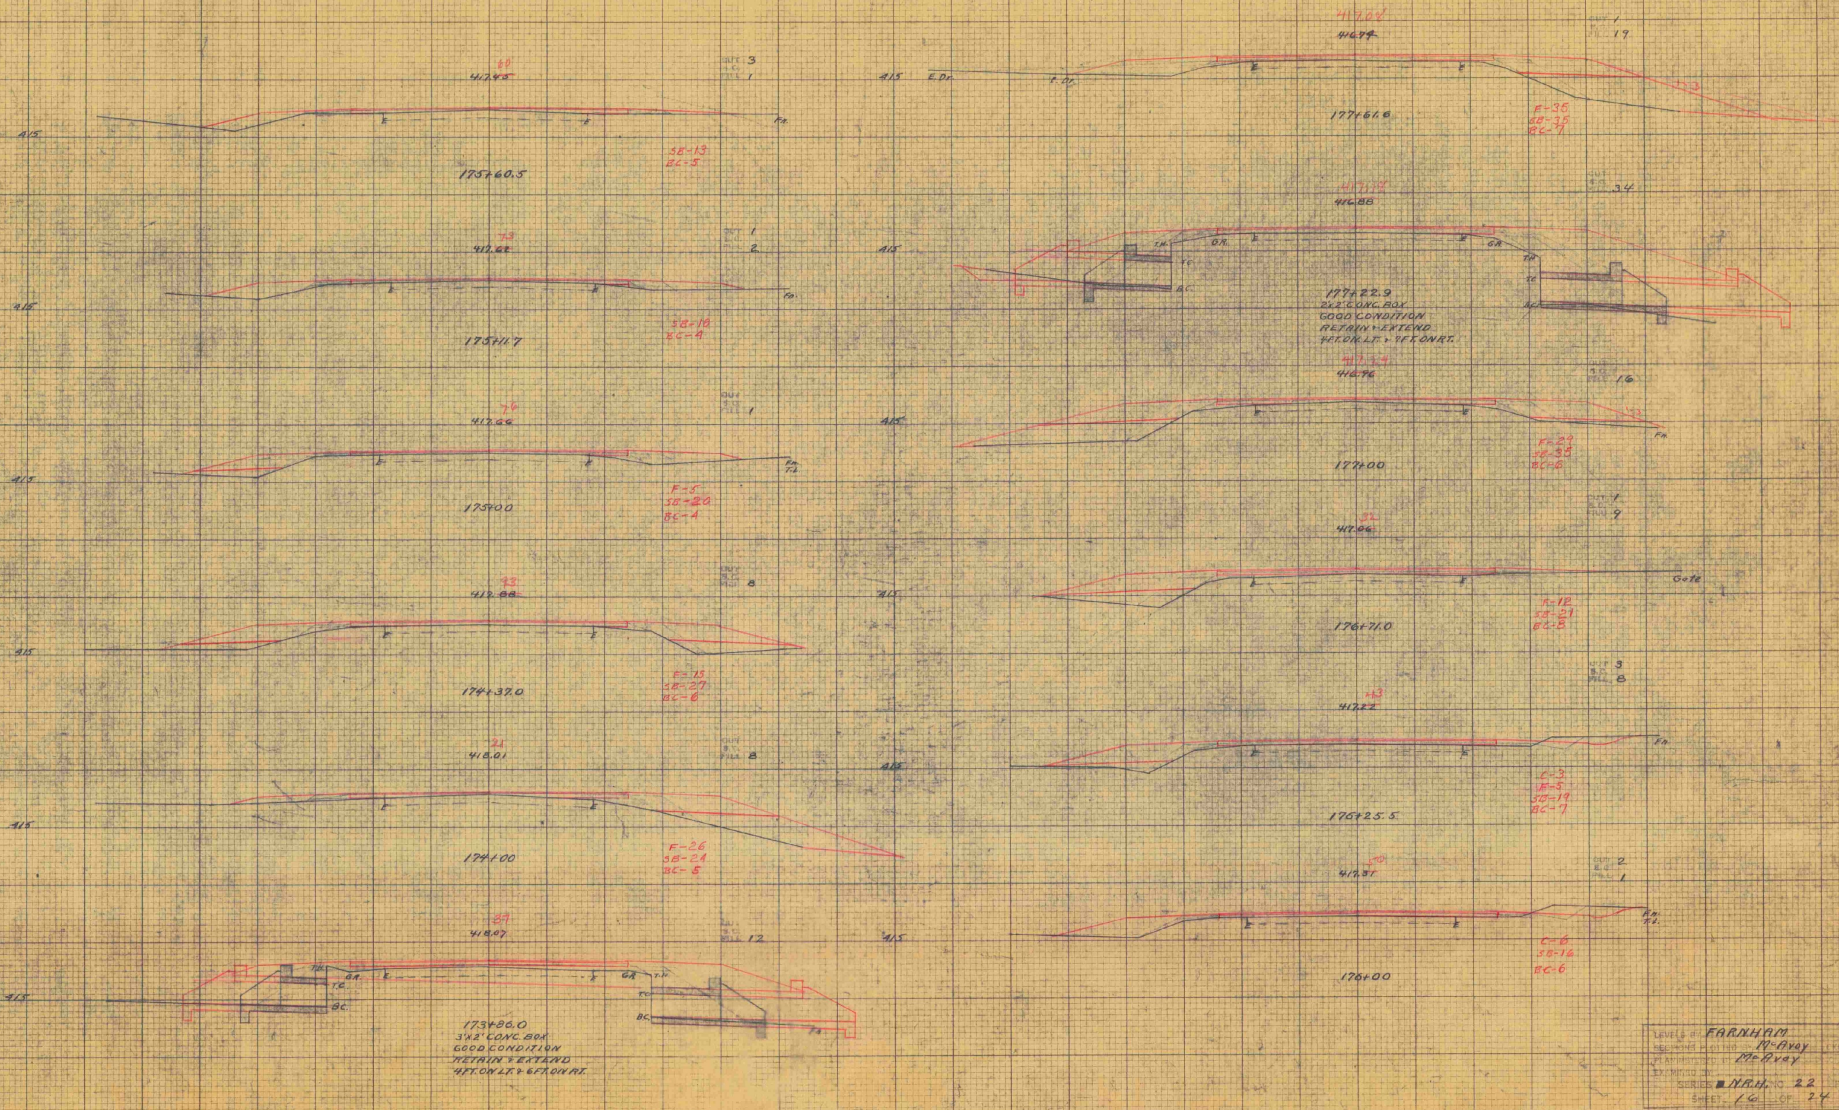

173+86.0
3/4\"/>


LEVELS & FARNHAM
17-Byay
17-Byay
SERIES N.A.H. 22
SHEET 16 OF 24

MARK
22 1933 18 24

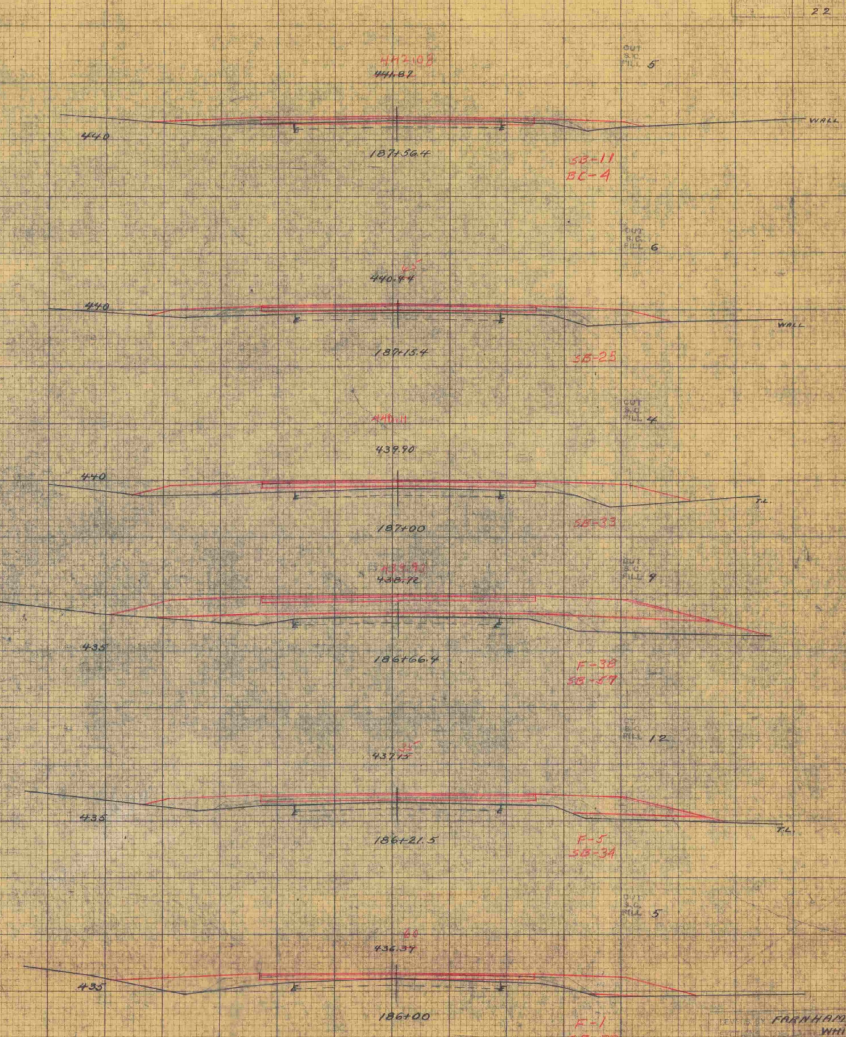
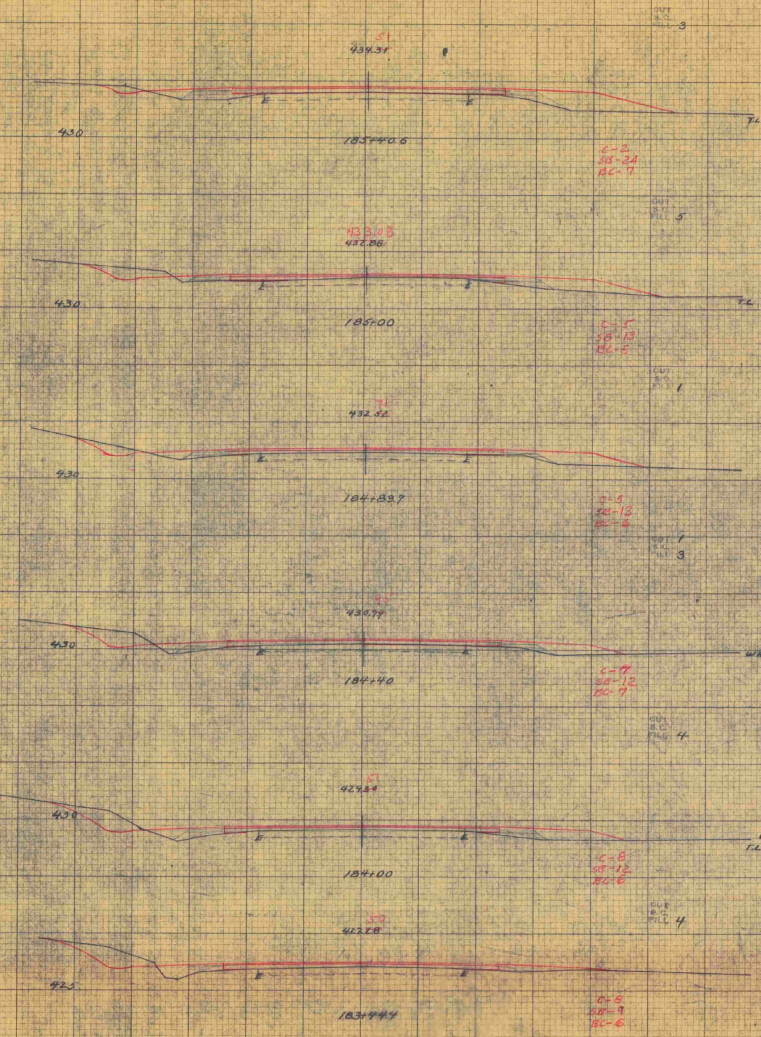


FANNING
WATERMAN
CORP.
NEW YORK
22
18 24

N.A.H.
22 1933 19 24

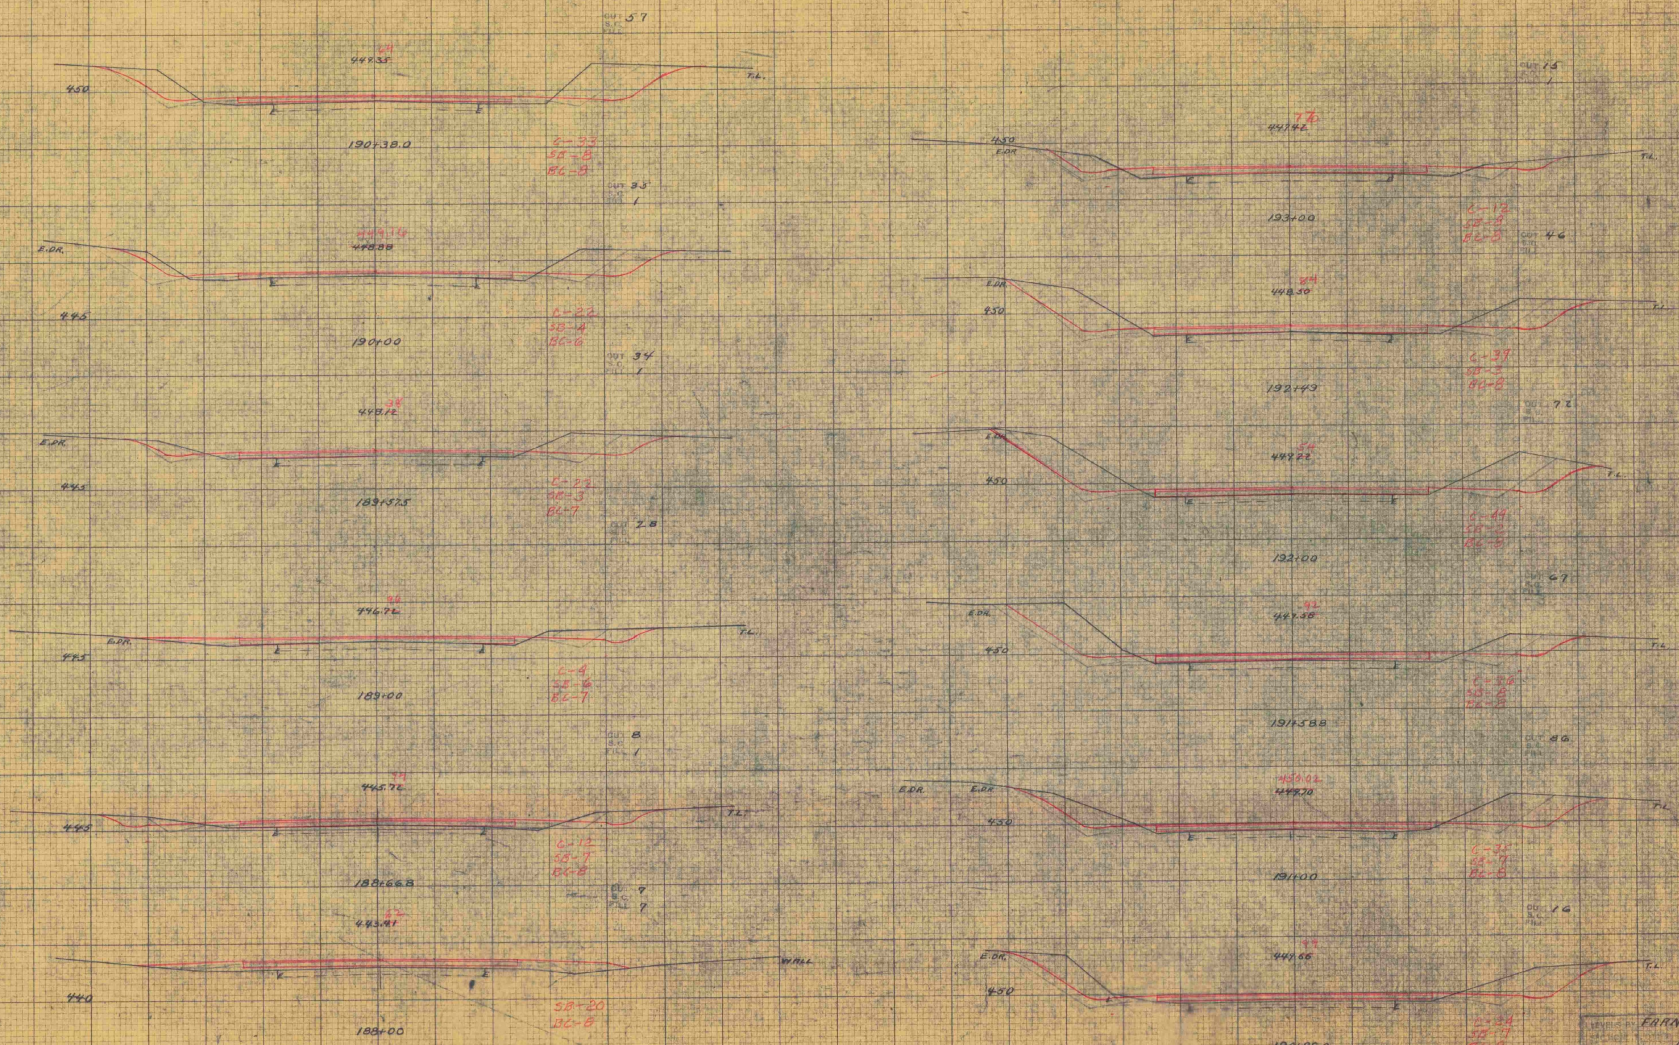


FARNHAM
WHITEHILL
Maquay
N.A.H. 22
17 24

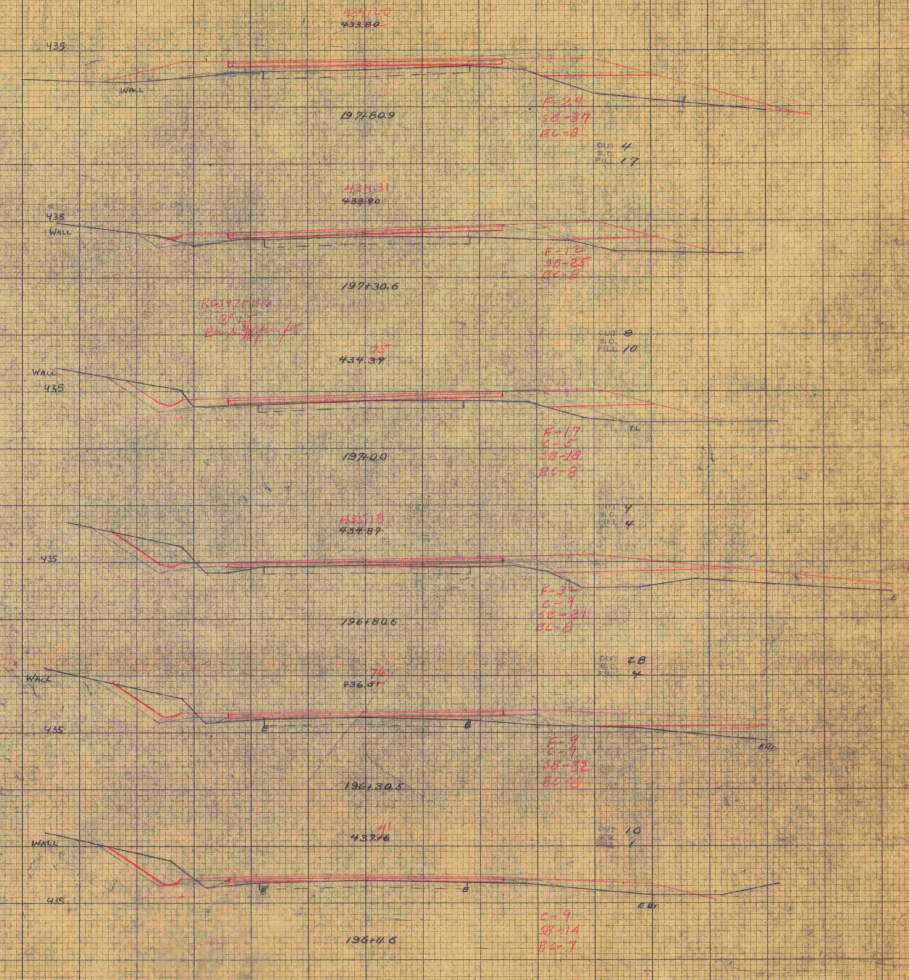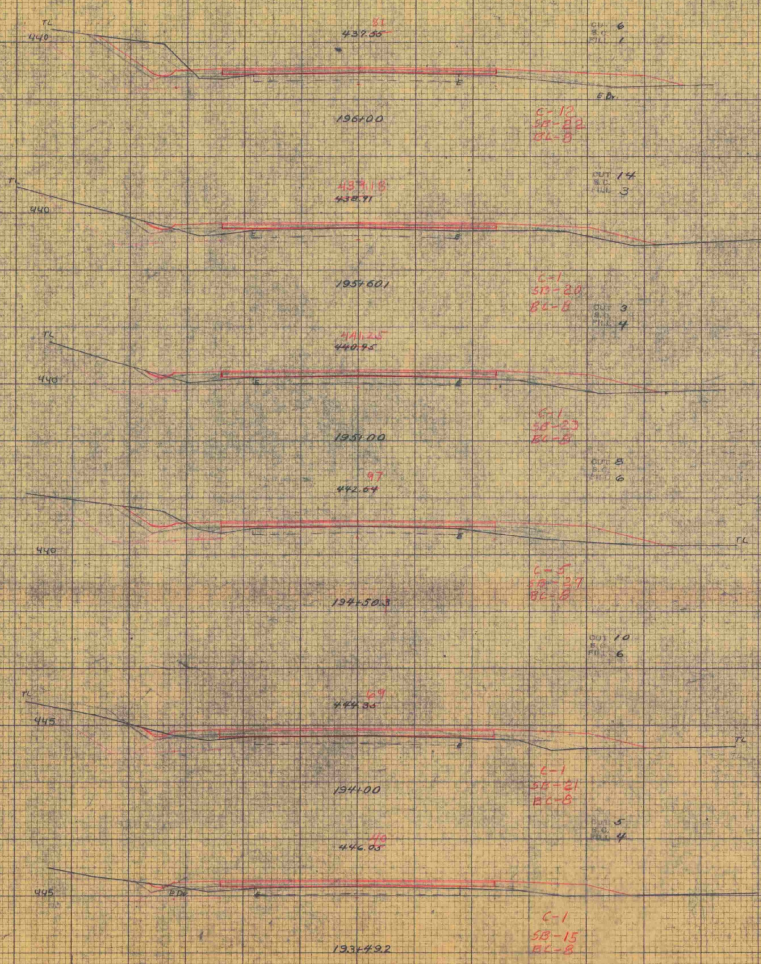


FRANKHAM
O'NEILL
MEMPHIS
NRH 22
2.0 2.4

M.R.H.
22 1933 22 24

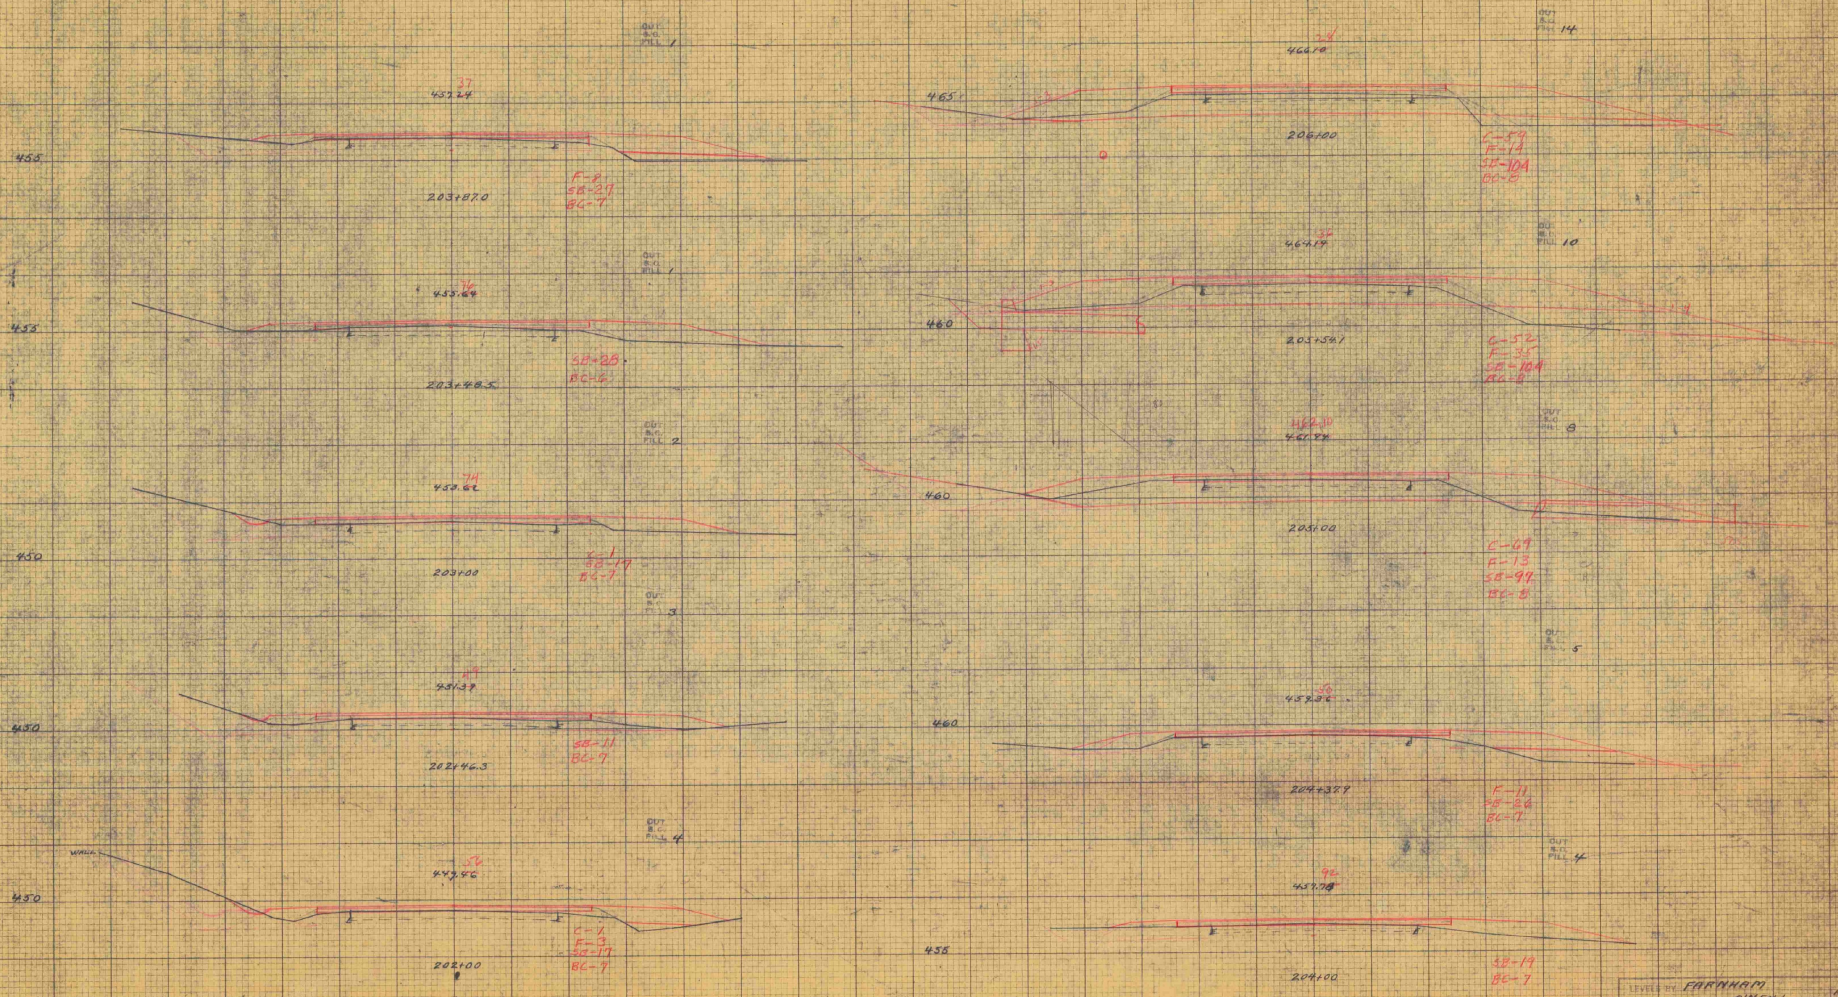

LEVELS BY FARNHAM
ONKELL
M. R. H.
M. R. H. 22
22 24

22 1933 24 24

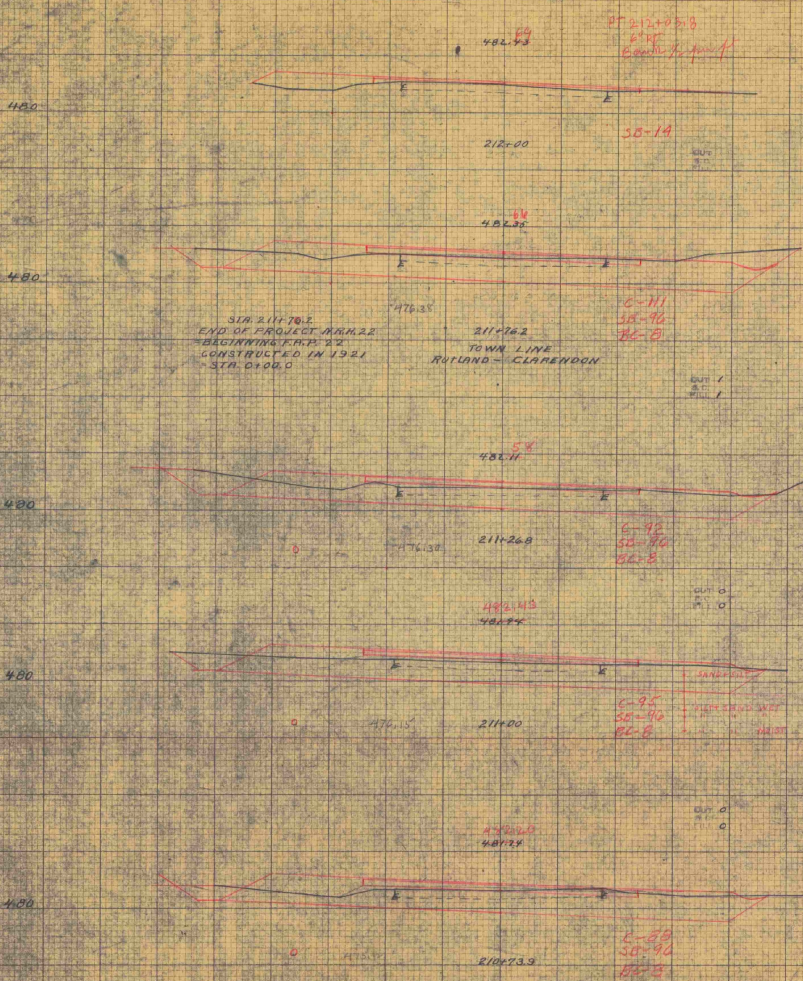


SIA 211+76.2
END OF PROJECT MARK 22
BEGINNING STA 12
CONSTRUCTED IN 1921
SIA 0+00.0

TOWN LINE
RUTLAND - CLARENDON

LEVELS BY **EARNHAM**
SECTION BY **ONEILL**
PLANNED BY **W. A. WOOD**
DESIGNED BY **W. A. WOOD**
SHEET 24 OF 24

DATE	
BY	
PLAN	
PROJECT NO.	
DATE	
BY	

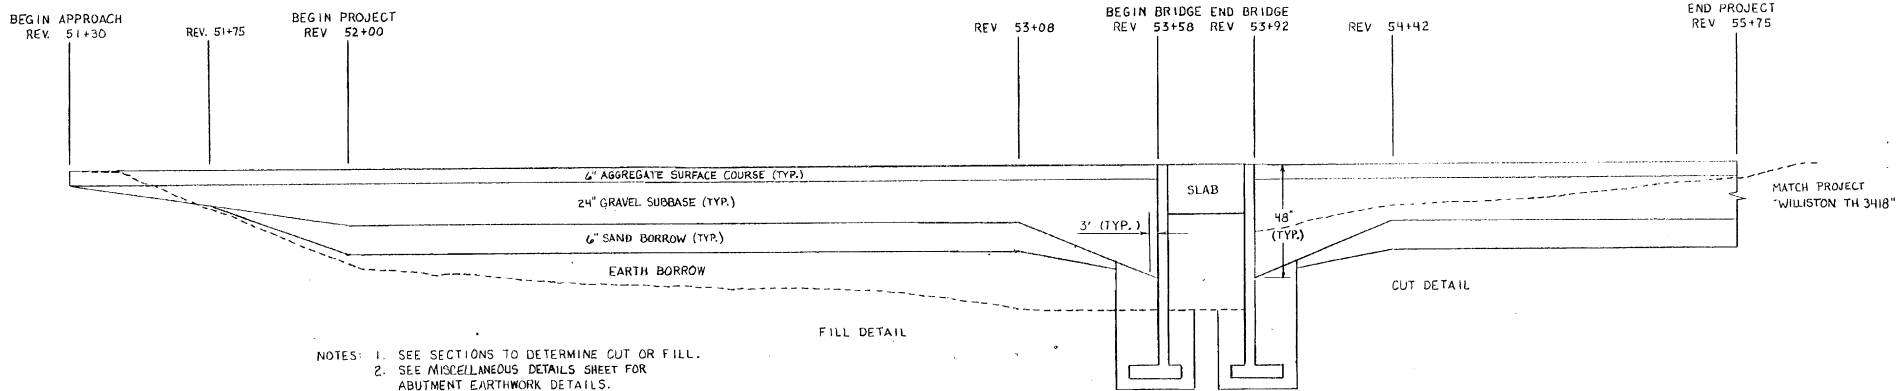


NOTES: 1. SEE SECTIONS TO DETERMINE CUT OR FILL.
2. SEE MISCELLANEOUS DETAILS SHEET FOR ABUTMENT EARTHWORK DETAILS.

EARTHWORK TRANSITION DETAIL - T.H. 6

(NOT TO SCALE)

DATE	
BY	
PROFILE	
PROJECT NO.	
DATE	
BY	

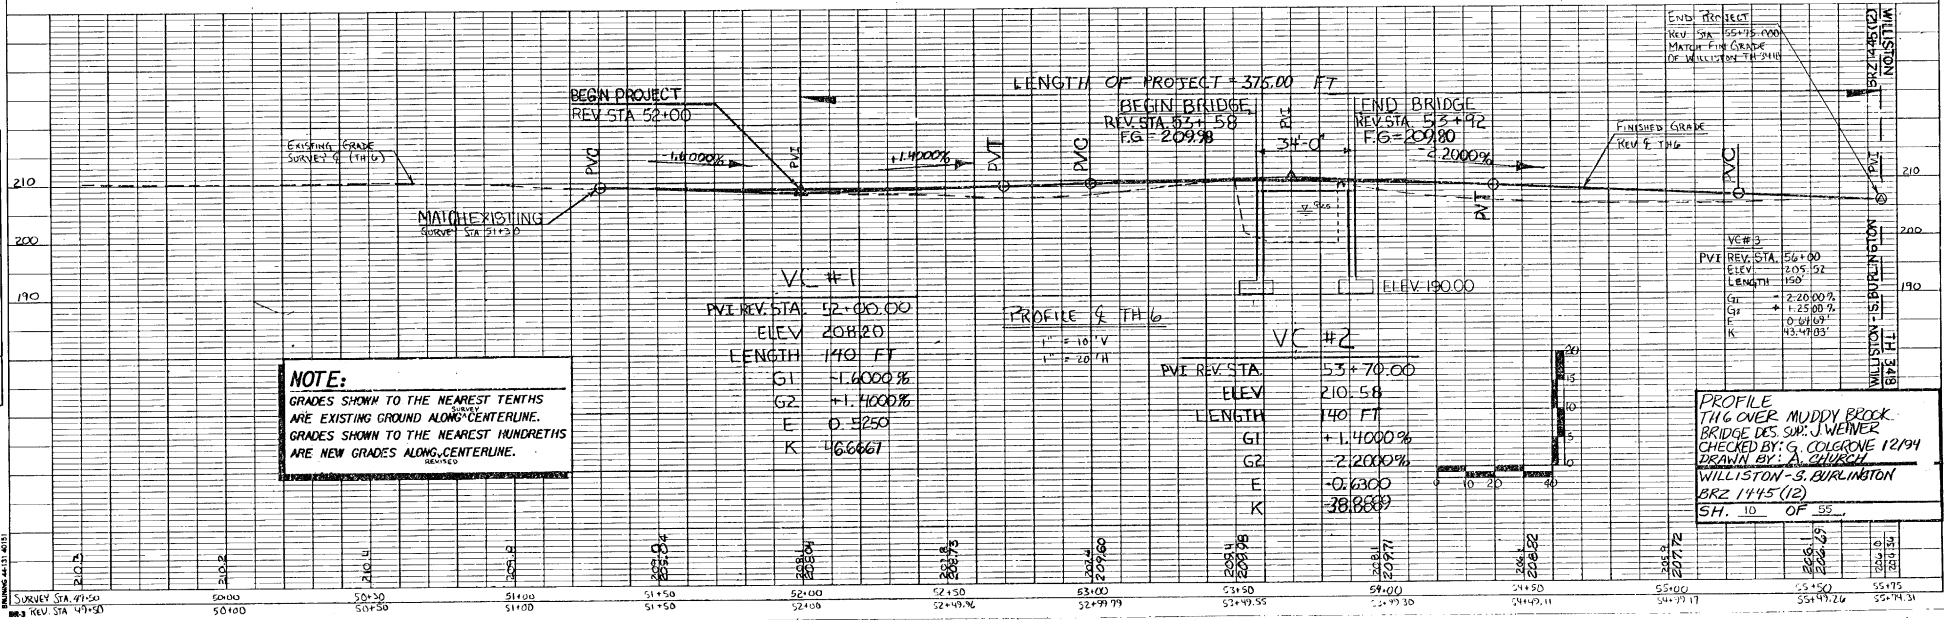

19 48

Rutland
F 22 (2)

1948

Vermont Agency of
Transportation
PHASE 3-INTERSTATE

INITIALS

Box 3443

DONE