


VIEW A-A

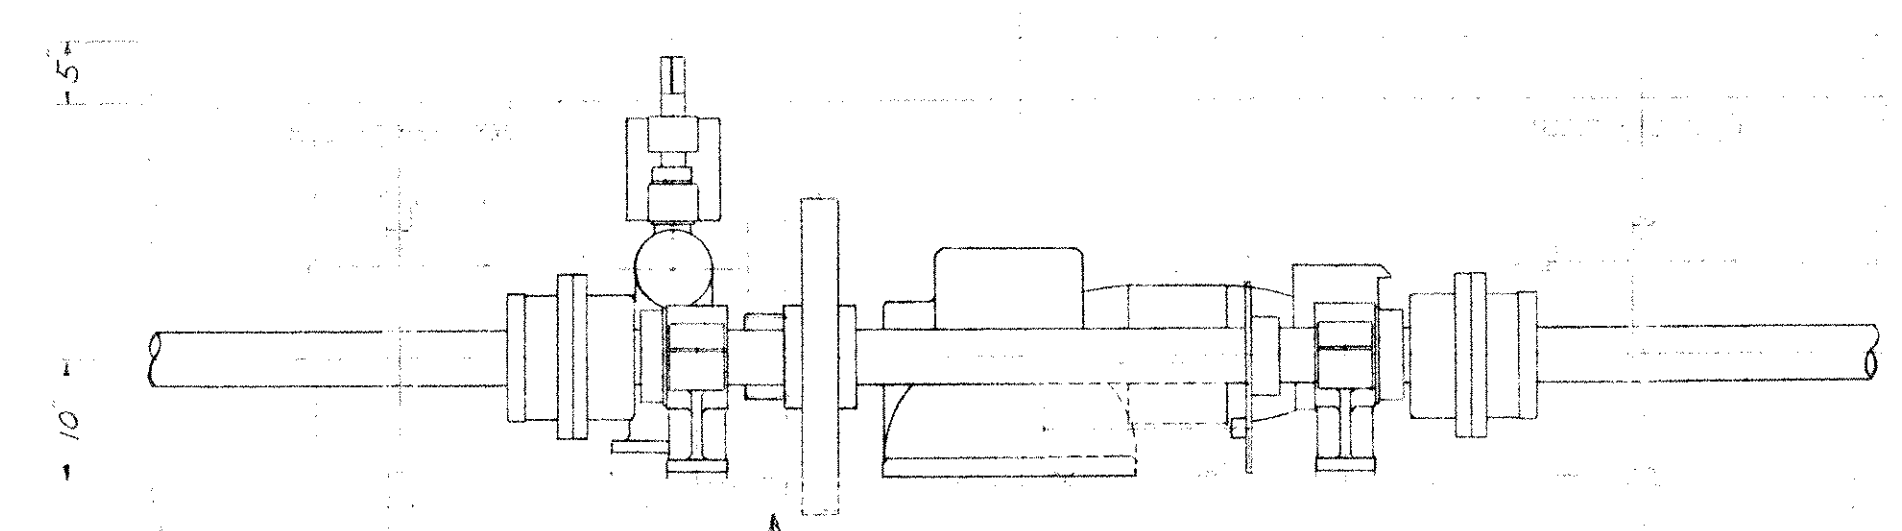

VIEW B-B

DATE	REVISIONS

SPECIFICATIONS _____
 INSPECTION _____

GENERAL NOTES
 ALL STEEL CASTINGS & FORGINGS TO BE ANNEALED
 SPOT FACE FOR ALL BOLT HEADS & NUTS
 SCRIBE PITCH LINES ON BOTH SIDES OF ALL GEARS
 SHOP PAINT—ONE COAT—
 FINISHED SURFACES COATED—
 CUT OIL GROOVES IN ALL BEARINGS UNLESS NOTED
 ALL SHIMS TO BE DRILLED

S. O. D-610 CONTRACT _____
 GRAND ISLE - NORTH HERO BASCULE
 BRIDGE, VERMONT

THE EARLE GEAR AND MACHINE COMPANY
 4707 TO 4715 STENTON AVENUE
 PHILADELPHIA 44, PA.
 DRAWN BY R.W.D. APPROVED BY _____
 CHECKED BY _____ REV. APPVD. _____
 DATE 7-18-51 REV. APPVD. _____
 SHEET OF _____ DWG. N^o 5622 E-30