


LS 13 LOCK LIMIT SWITCH SPROCKET COVER
1 REQD. , 12 GA. S.

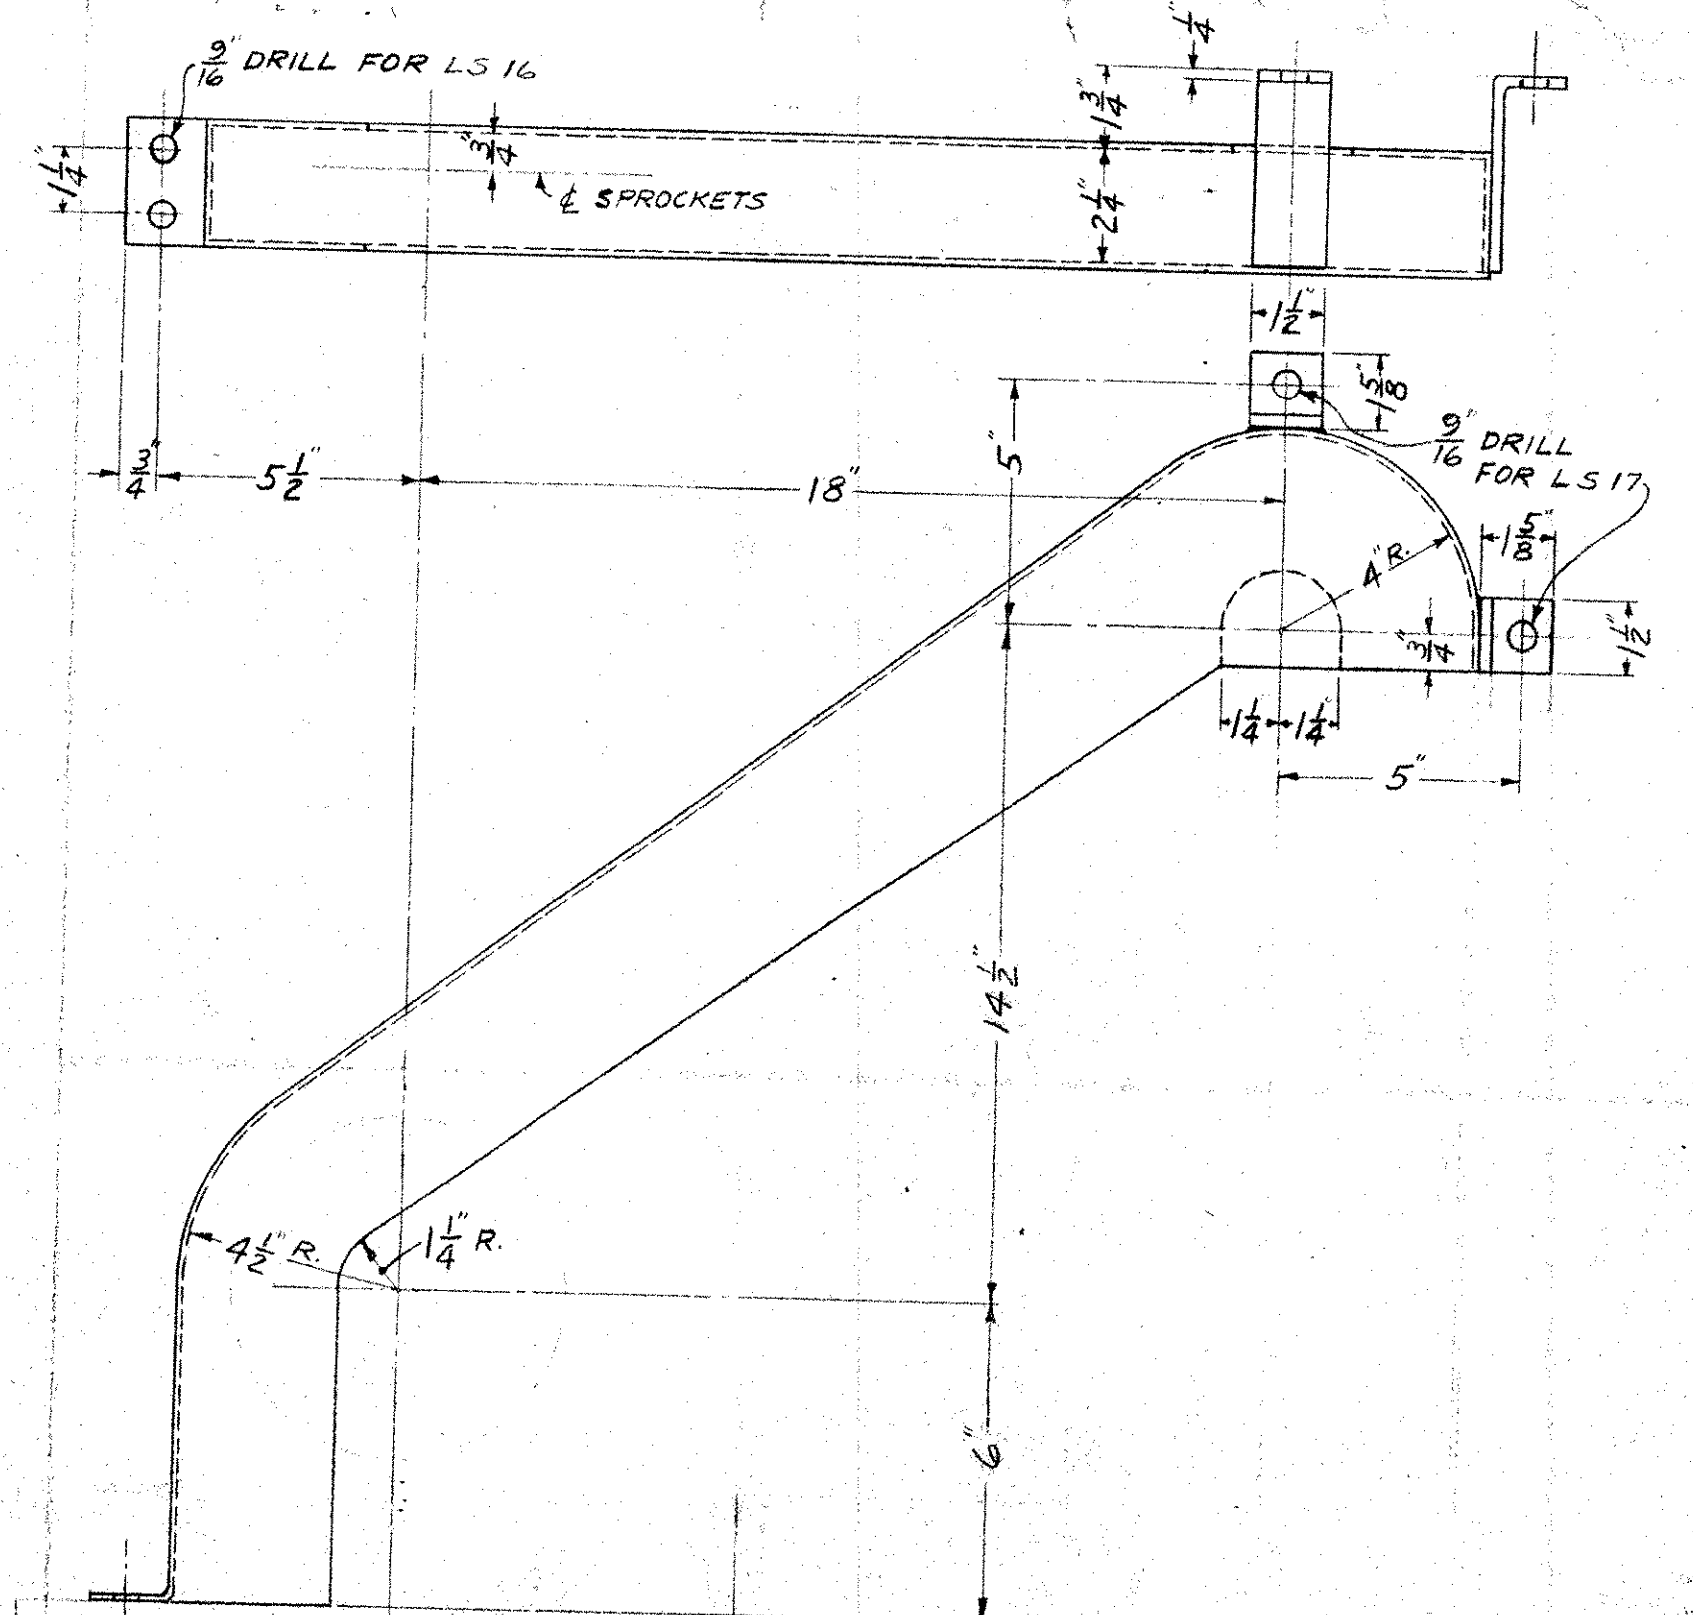

LS 15 LEAF LIMIT SWITCH SPROCKET COVER
2 REQD. , 12 GA. S.

GRAND ISLE-NO. HERO BRIDGE, VERMONT
NOTE-SEE DWG 5528 C-22 FOR BILL OF MATERIAL

THE EARLE GEAR & MACHINE CO.
4707-15 STENTON AVE.
PHILADELPHIA, PA.
DATE OF PRINT 4/11/51
DRAWN BY R.W.D.
DWG. No. 5529 C-22