



TYPICAL SECTION

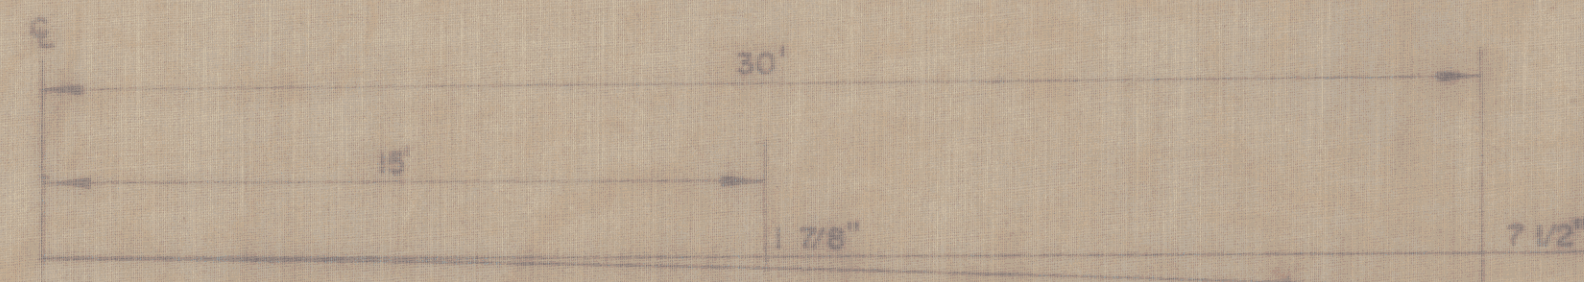

PARABOLIC DETAIL

- 3" BITUMINOUS CONCRETE PAVEMENT, ITEM 361-B ($\pm 1/4"$)
 - 2-2 1/2" CRUSHED GRAVEL OR CRUSHED STONE PLANT MIXED BASE COURSE, ITEM 213 ($\pm 1/2"$ FOR TOTAL THICKNESS)
 - 24" SUB-BASE OF GRAVEL, ITEM 201 ($\pm 1"$)
 - 24" GRANULAR BORROW, ITEM 105 ($\pm 1"$) IN FILLS
 - 24" SUB-BASE OF SAND, ITEM 202 ($\pm 1"$) IN CUTS
- TO BE PLACED AS NOTED ON THE PLANS OR AS DIRECTED BY THE ENGINEER.

PERMISSIBLE TOLERANCES IN PARENTHESIS, APPLY TO THICKNESS ONLY.

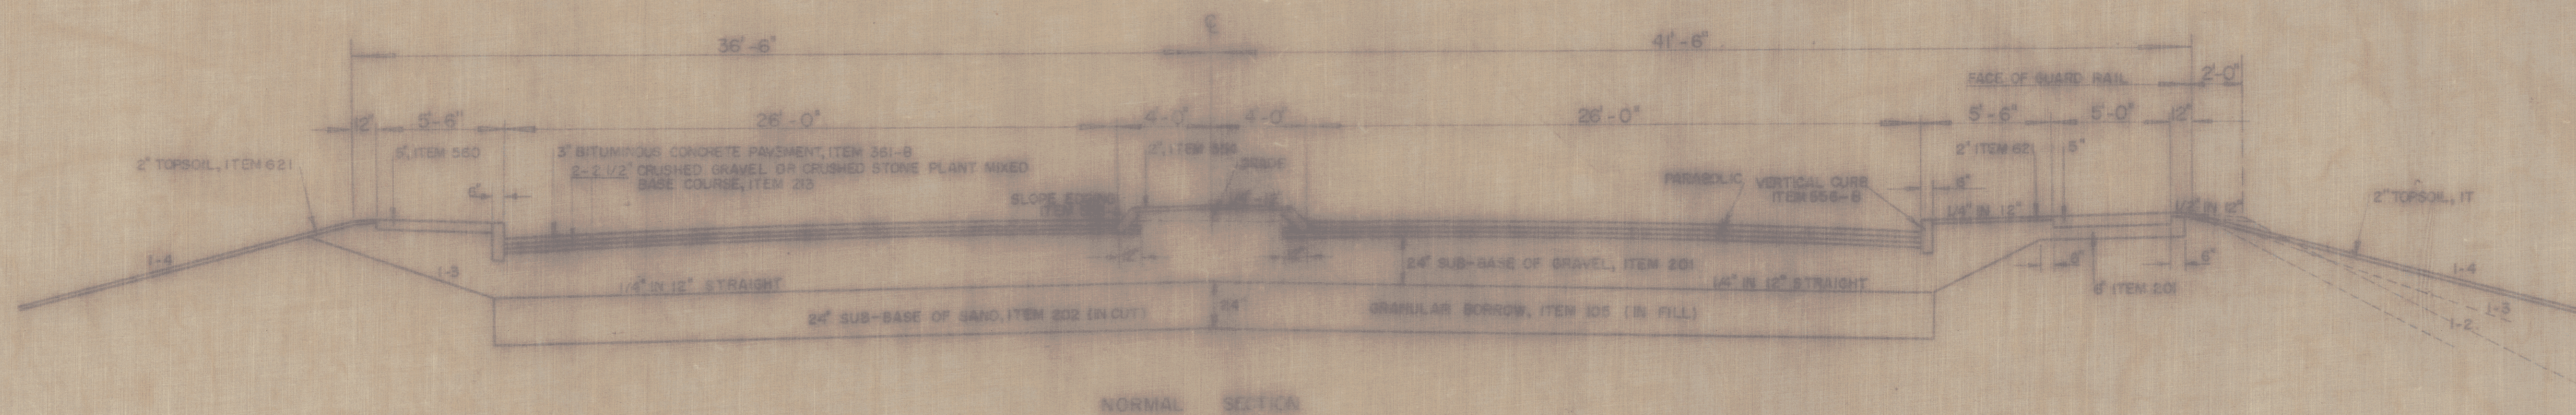

NORMAL SECTION

FOR ROUNDING OF SLOPES, SEE STANDARD SHEET B-5
STEEL MARKER POSTS, ITEM 547-D, TO BE PLACED AS DIRECTED BY THE ENGINEER
MULCH, ITEM 622, TO BE PLACED ON ALL EARTH SLOPES.

FERTILIZER, ITEM 615, SHALL BE MIXED AS FOLLOWS:

NITROGEN 10%
PHOSPHORUS 20%
POTASH 10%

FERTILIZER SHALL BE DELIVERED IN BAGS OF NOT TO EXCEED 100 LBS EACH AND IS TO BE APPLIED AT THE RATE OF 500 LBS PER ACRE.

SEEDING, ITEM 611

LB/ACRE	PURITY %	GERM %
55.33	85	85
10.00	8	80
15.67	10	85
5.33	5	80
16.67	10	80
5.33	5	80
0.42	1/4	80
5.26	3/4	80
100.00	80 LBS PER ACRE	

50 LBS OF WHITE RYE OR 4000 TO BE ADDED TO THE ABOVE SEEDING FORMULA AS DIRECTED BY THE ENGINEER

HARTFORD -- VT ROUTE 14

SURVEYED BY: J. D. 037-100

DRAWN BY: J. D. 037-100

TRACED BY: J. D. 037-100

PROJ. F. 037-100

3 OF 70