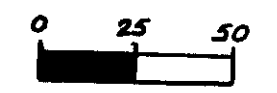


PROPERTY SKETCH
 OF
 SANBORN OIL COMPANY
 HARTFORD - FU 041-2 (3)
 DEC. 9, 65 W. B. LOWE
 SCALE 

VERMONT DEPARTMENT OF HIGHWAYS
RIGHT-OF-WAY PLANS
 PROJECT: HARTFORD
 NO. FU 041-2(3)
 SHEET: 6 OF 70