


INTERSTATE TRUST Co.

PROPERTY OWNER	THE HAMILTON CORPORATION
PARCEL NO.	14
TOTAL ACREAGE	1.35 A±
TAKING	0.15 A±
REMAINDER	1.2 A±
SCALE	1" = 20'
SLOPE RIGHTS	300'

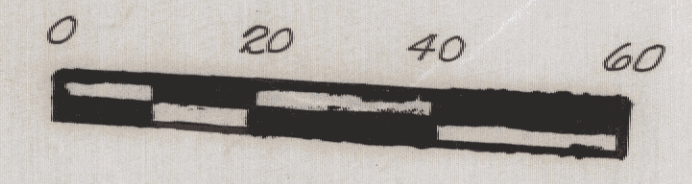

VERMONT DEPARTMENT OF HIGHWAYS
 RIGHT-OF-WAY PLANS
 PROJECT HARTFORD
 NO F037-1(3)
 SHEET 25 OF 70