




PROPERTY OWNER PHILIP H. & ROSE ANNE MARIE LA BOUNTY  
 PARCEL NO 54  
 TOTAL ACREAGE 0.5 A±  
 TAKING 1962±  
 REMAINDER 0.5 A±  
 SCALE 1"=20'  
 SLOPE 234±

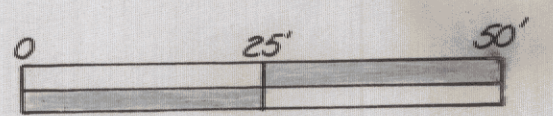

HARTFORD  
FU041-3(10)

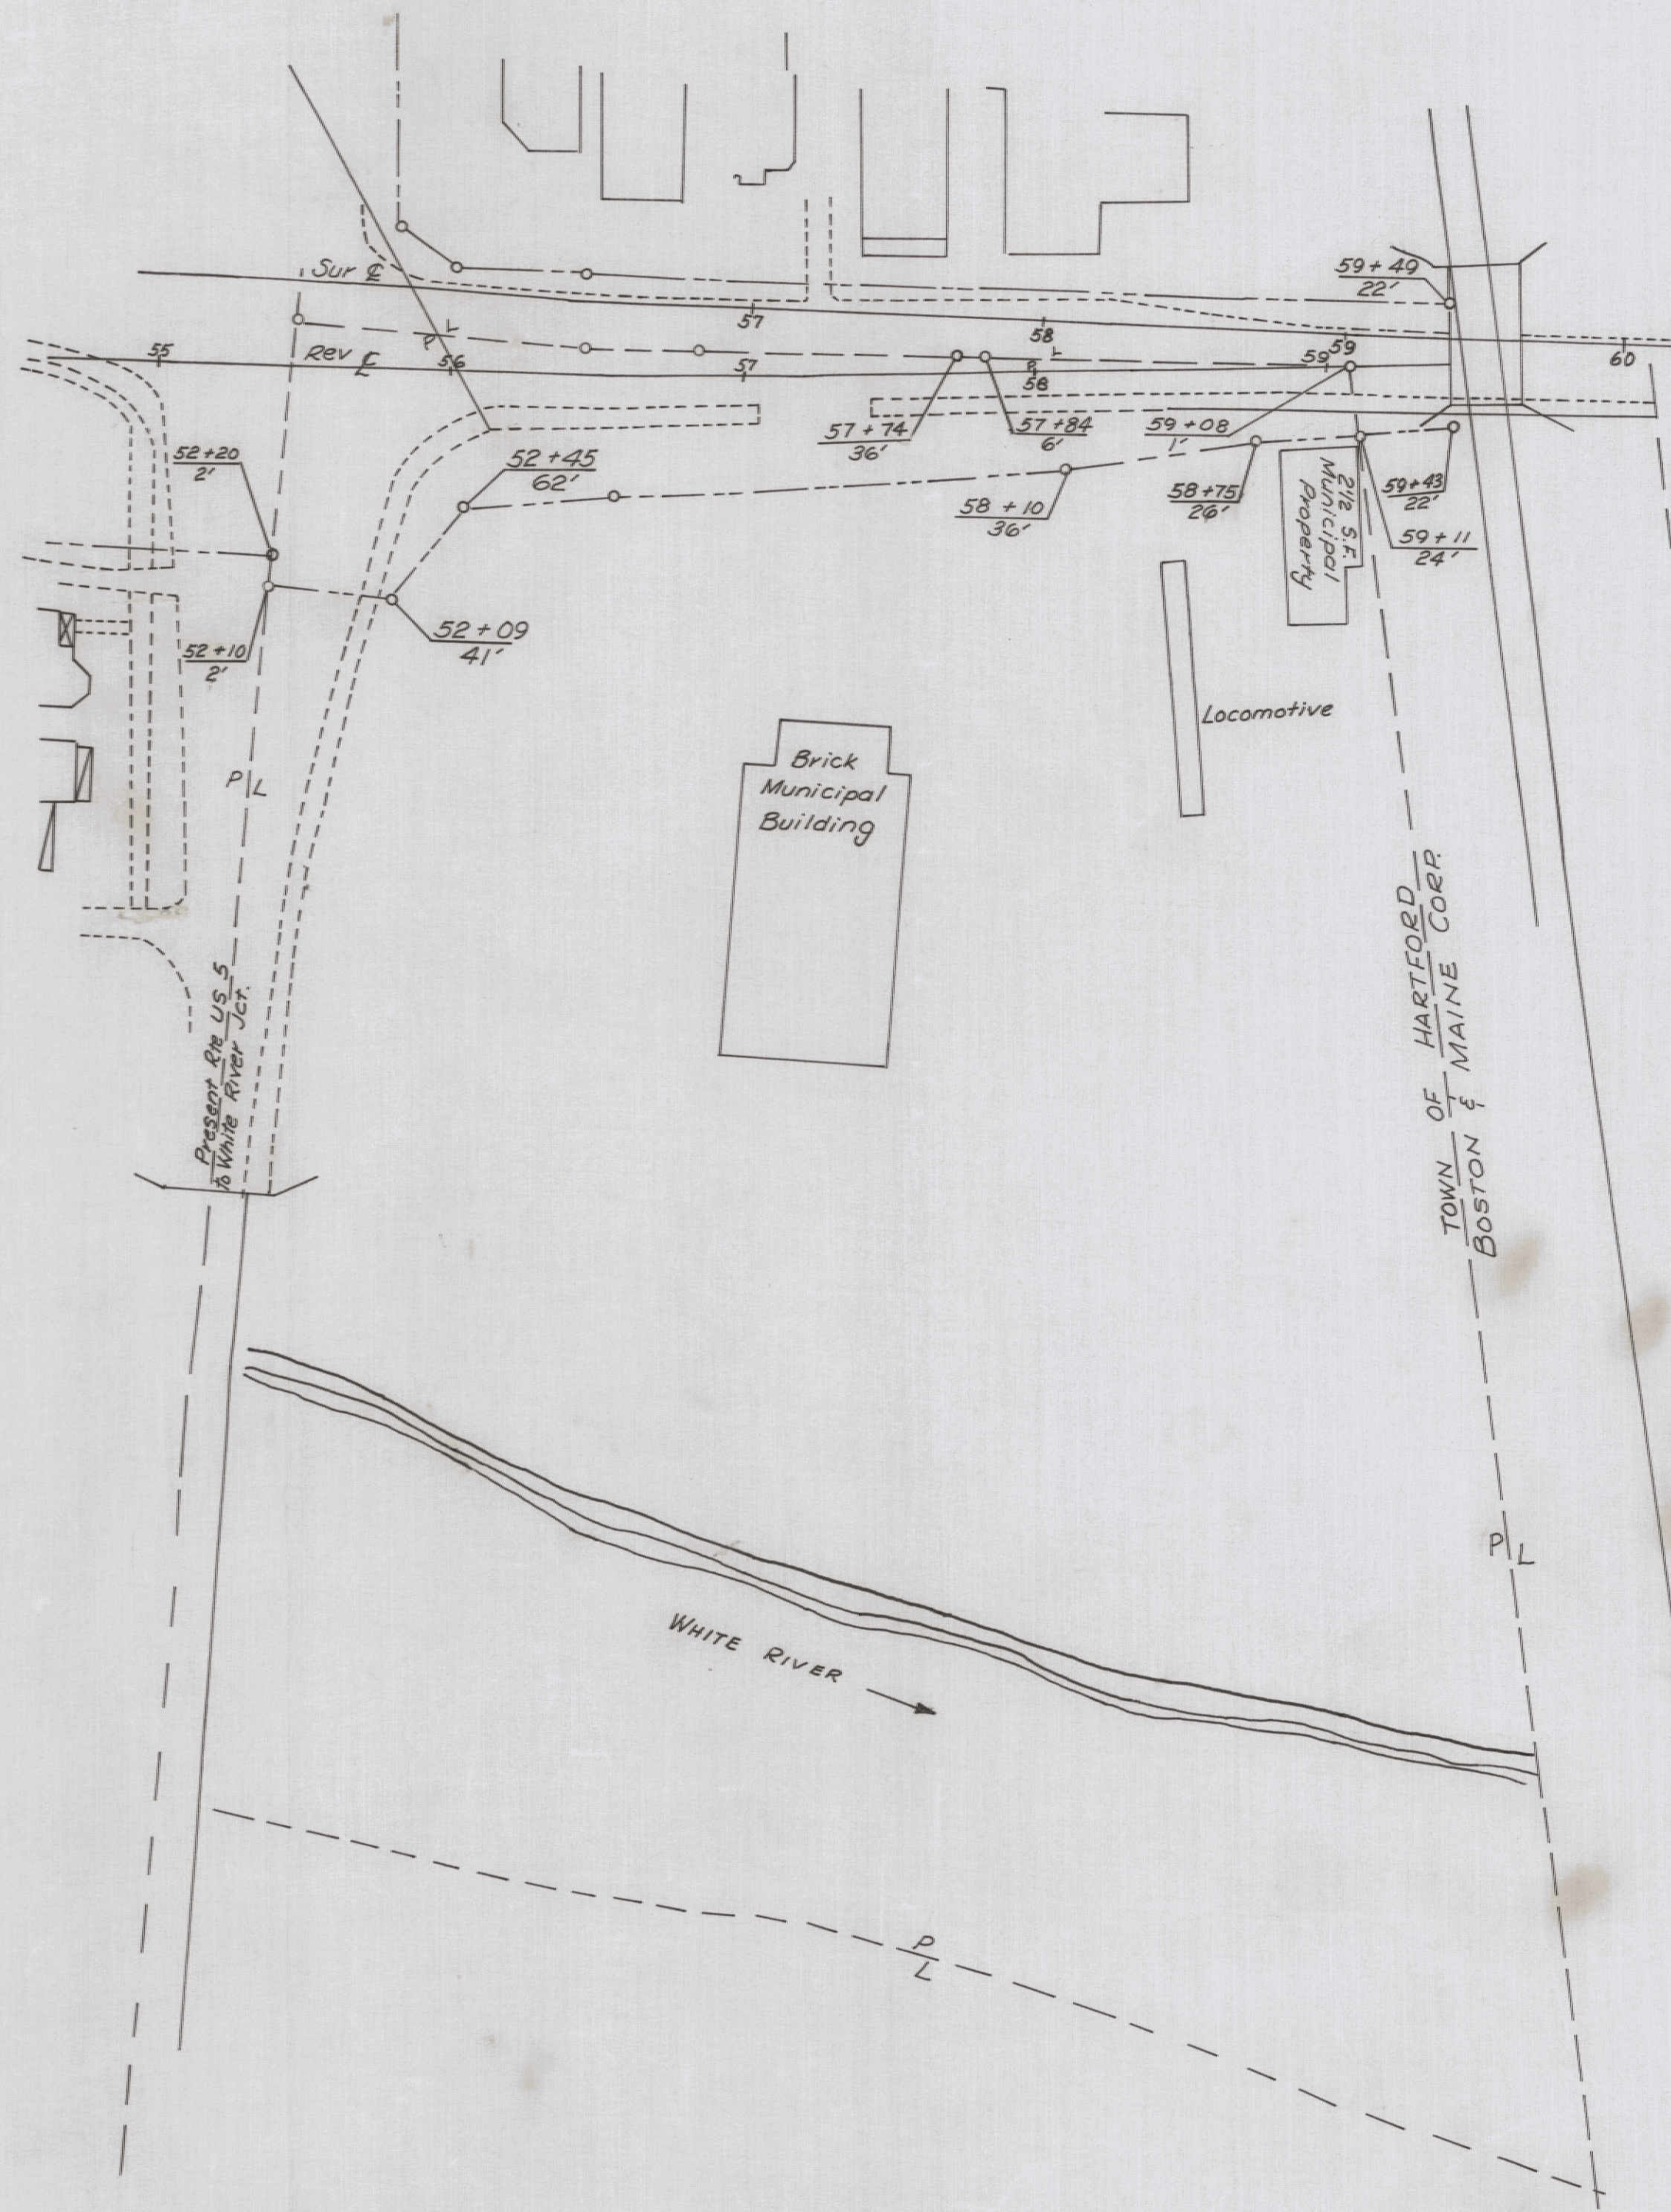

PROPERTY OWNER TOWN OF HARTFORD  
 PARCEL NO 39  
 TOTAL ACREAGE 5.6 A±  
 TAKING 0.4 A±  
 REMAINDER 5.2 A±  
 SCALE 1"=50±

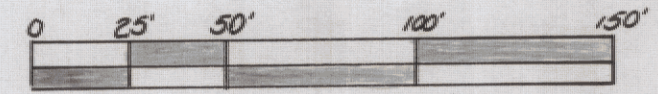

**VERMONT DEPARTMENT OF HIGHWAYS**  
**RIGHT-OF-WAY PLANS**  
 PROJECT HARTFORD  
 NO FO20-3(1)  
 SHEET 26 OF 70