


PROPERTY OWNER MAURICE G. HARVEY
 PARCEL No. 60 A, B, C
 TOTAL ACREAGE 1.90 A±
 TAKING .58 A±
 REMAINDER 1.32 A±
 SCALE 1" = 20'
 SLOPE RIGHT 2775"
 DRIVE RIGHT R.T.I. IN PARCEL 66



PROPERTY OWNER FRANCES P. COVELL
 PARCEL No. 66
 TOTAL ACREAGE 0.54 A±
 TAKING 1450"
 REMAINDER 0.51 A±
 SCALE 1" = 20'
 SLOPE RIGHT 20"

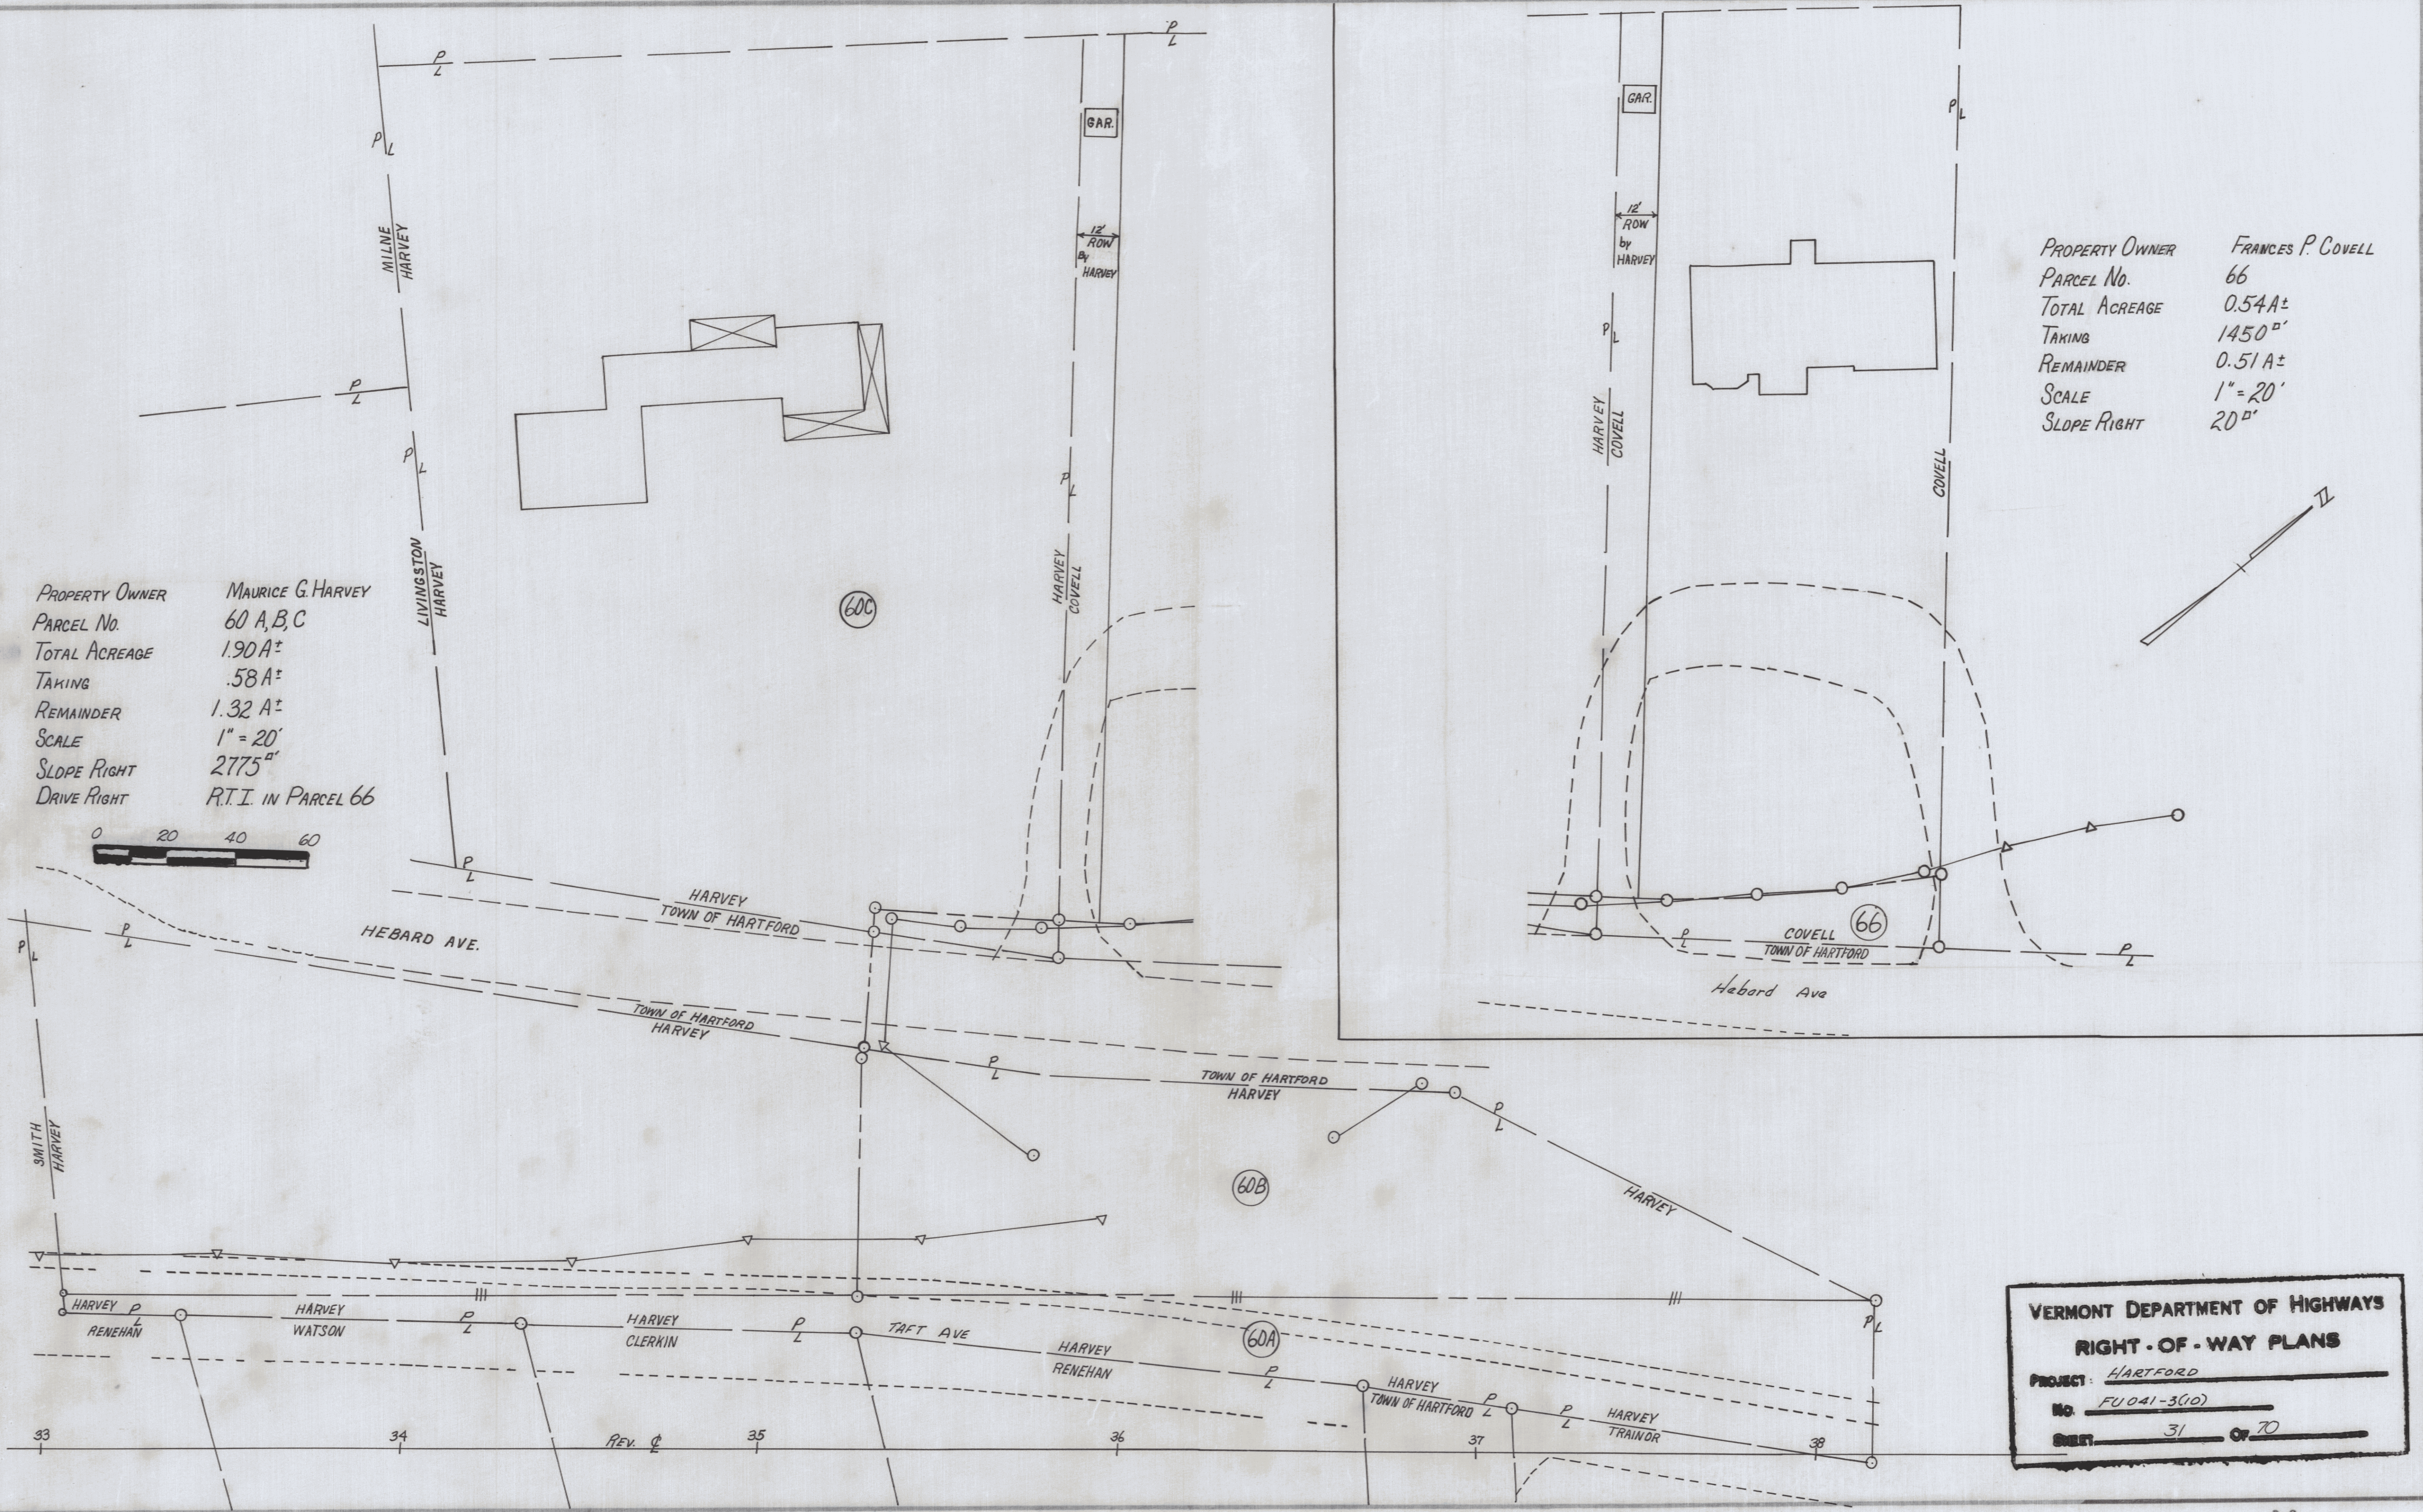

VERMONT DEPARTMENT OF HIGHWAYS
RIGHT-OF-WAY PLANS
 PROJECT: HARTFORD
 No. FU 041-3(10)
 SHEET 31 OF 70