


PROPERTY OWNER - ARTHUR T. & DOROTHY T. DUNLEY AND  
 FLORENCE WALSH & CONSTANCE WALSH  
 PARCEL No. - 70  
 TOTAL ACREAGE - 2.04 A±  
 TAKING - 0.14 A±  
 REMAINDER - 1.9 A±  
 SCALE - 1" = 20'  
 SLOPE - 1400 SF±  
 DRIVE -  
 DROP INLET -

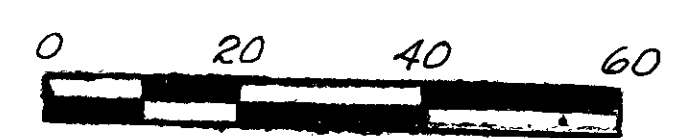

**VERMONT DEPARTMENT OF HIGHWAYS**  
**RIGHT-OF-WAY PLANS**  
 PROJECT HARTFORD  
 NO. FU041-3(10)  
 SHEET 33 OF 70