


BLANCHARD

PROPERTY OWNER FORREST L. & EDITH R. ADAMS
 PARCEL NO. 75
 TOTAL ACREAGE 1.8 A ±
 TAKING 0.4 A ±
 REMAINDER 1.4 A ±
 SCALE 1" = 20'
 DRIVE
 DROP INLET

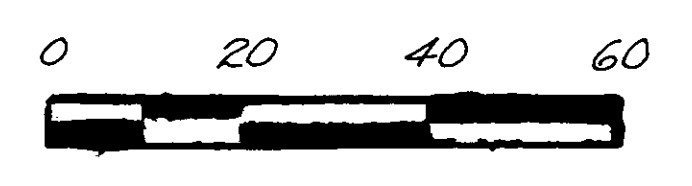

VERMONT DEPARTMENT OF HIGHWAYS
 RIGHT-OF-WAY PLANS
 PROJECT HARTFORD
 No. FU 041-3(10)
 SHEET 36 OF 70