


VERMONT DEPARTMENT OF HIGHWAYS
RIGHT-OF-WAY PLANS
 PROJECT: HARTFORD
 NO: FU 041-3(10) & F020-3(1)
 SHEET 51 OF 70

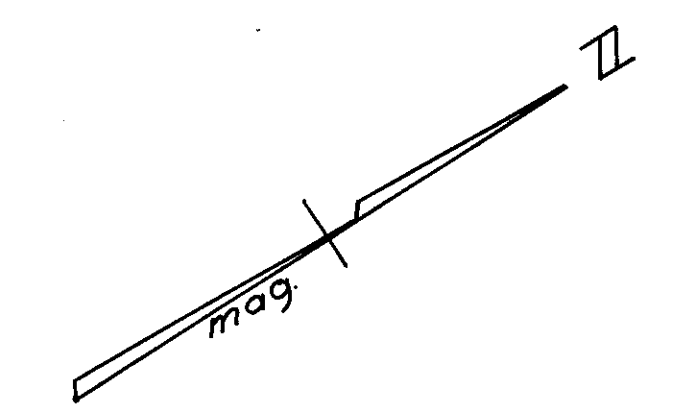

Sheet 1-A
 MATCH
 to sheet 2-A

Dec 13 1965