

FOR BOAT RAMP AREA
PLAN, SEE SHEET C61

LEGEND

- ♂ PROPOSED MAILBOX
- ⊗ PROPOSED LANDSCAPING
- x-x- PROPOSED CHAIN-LINK FENCE
- PB PROPOSED PULL BOX
- * PROPOSED OVERHEAD LIGHT
- PROPOSED UTILITY VAULT
- PUED- PROPOSED UNDERGROUND ELECTRICAL DUCT
- PUTV- PROPOSED UNDERGROUND CABLE TV DUCT
- PNL- PROPOSED UNDERGROUND WIRED CONDUIT FOR NAVIGATIONAL LIGHTING
- PE&TV- PROPOSED AERIAL ELECTRIC, CABLE TV AND TELEPHONE
- PT- PROPOSED AERIAL TELEPHONE
- E&TV- TEMPORARY AERIAL ELECTRIC, CABLE TV AND TELEPHONE

DUCTS - DIRECT BURIAL (CABLE TV DUCT)

- STA 12+073, RT 4.1 m - STA 12+078, RT 2.5 m
- STA 12+078, RT 2.5 m - STA 12+082, RT 2.5 m
- STA 12+082, RT 2.5 m - STA 12+089, RT 4.5 m
- STA 12+089, RT 4.5 m - STA 12+180, RT 5.7 m
- STA 12+180, RT 5.7 m - STA 12+270, RT 15.7 m
- STA 12+200, RT 16.0 m - STA 12+232, RT 17.0 m

DUCTS - CONCRETE ENCASED

- 12 DUCTS (ELECTRICAL, CABLE TV AND VTRANS DUCTS):
- STA 12+060.8, RT 3.6 m - STA 12+073, RT 4.1 m

9 DUCTS (ELECTRICAL DUCTS):

- STA 12+073, RT 4.1 m - STA 12+078, RT 4.1 m
- STA 12+082, RT 5.0 m - STA 12+180, RT 6.2 m
- STA 12+180, RT 6.2 m - STA 12+270, RT 16.2 m
- STA 12+200, RT 16.0 m - STA 12+224, RT 16.2 m

DOUBLE PULL BOX

- STA 12+073.5, RT 4.1 m (CABLE TV DUCT)

SETTLEMENT PLATFORM (TYPE I)

- PROPOSED SETTLEMENT PLATFORM LOCATIONS


- ~~PL-11~~ STA 12+068.250, LT 0.0 m
- ~~PL-12~~ STA 12+068.250, LT 7.6 m
- PL-13 STA 12+088.750, LT 0.0 m
- PL-14 STA 12+088.750, LT 7.6 m
- PL-15 STA 12+109.250, LT 0.0 m
- PL-16 STA 12+109.250, LT 7.6 m
- PL-17 STA 12+129.750, LT 0.0 m
- PL-18 STA 12+129.750, LT 7.6 m

DRIVE-GATE FOR CHAIN-LINK FENCE (TYPE I)

- STA 12+065, LT 20.0 m - STA 12+065, LT 23.6 m

CHAIN-LINK FENCE (TYPE I)

- STA 12+065, LT 8.0 m - STA 12+065, LT 20.0 m
- STA 12+065, LT 23.6 m - STA 12+065, LT 30.0 m

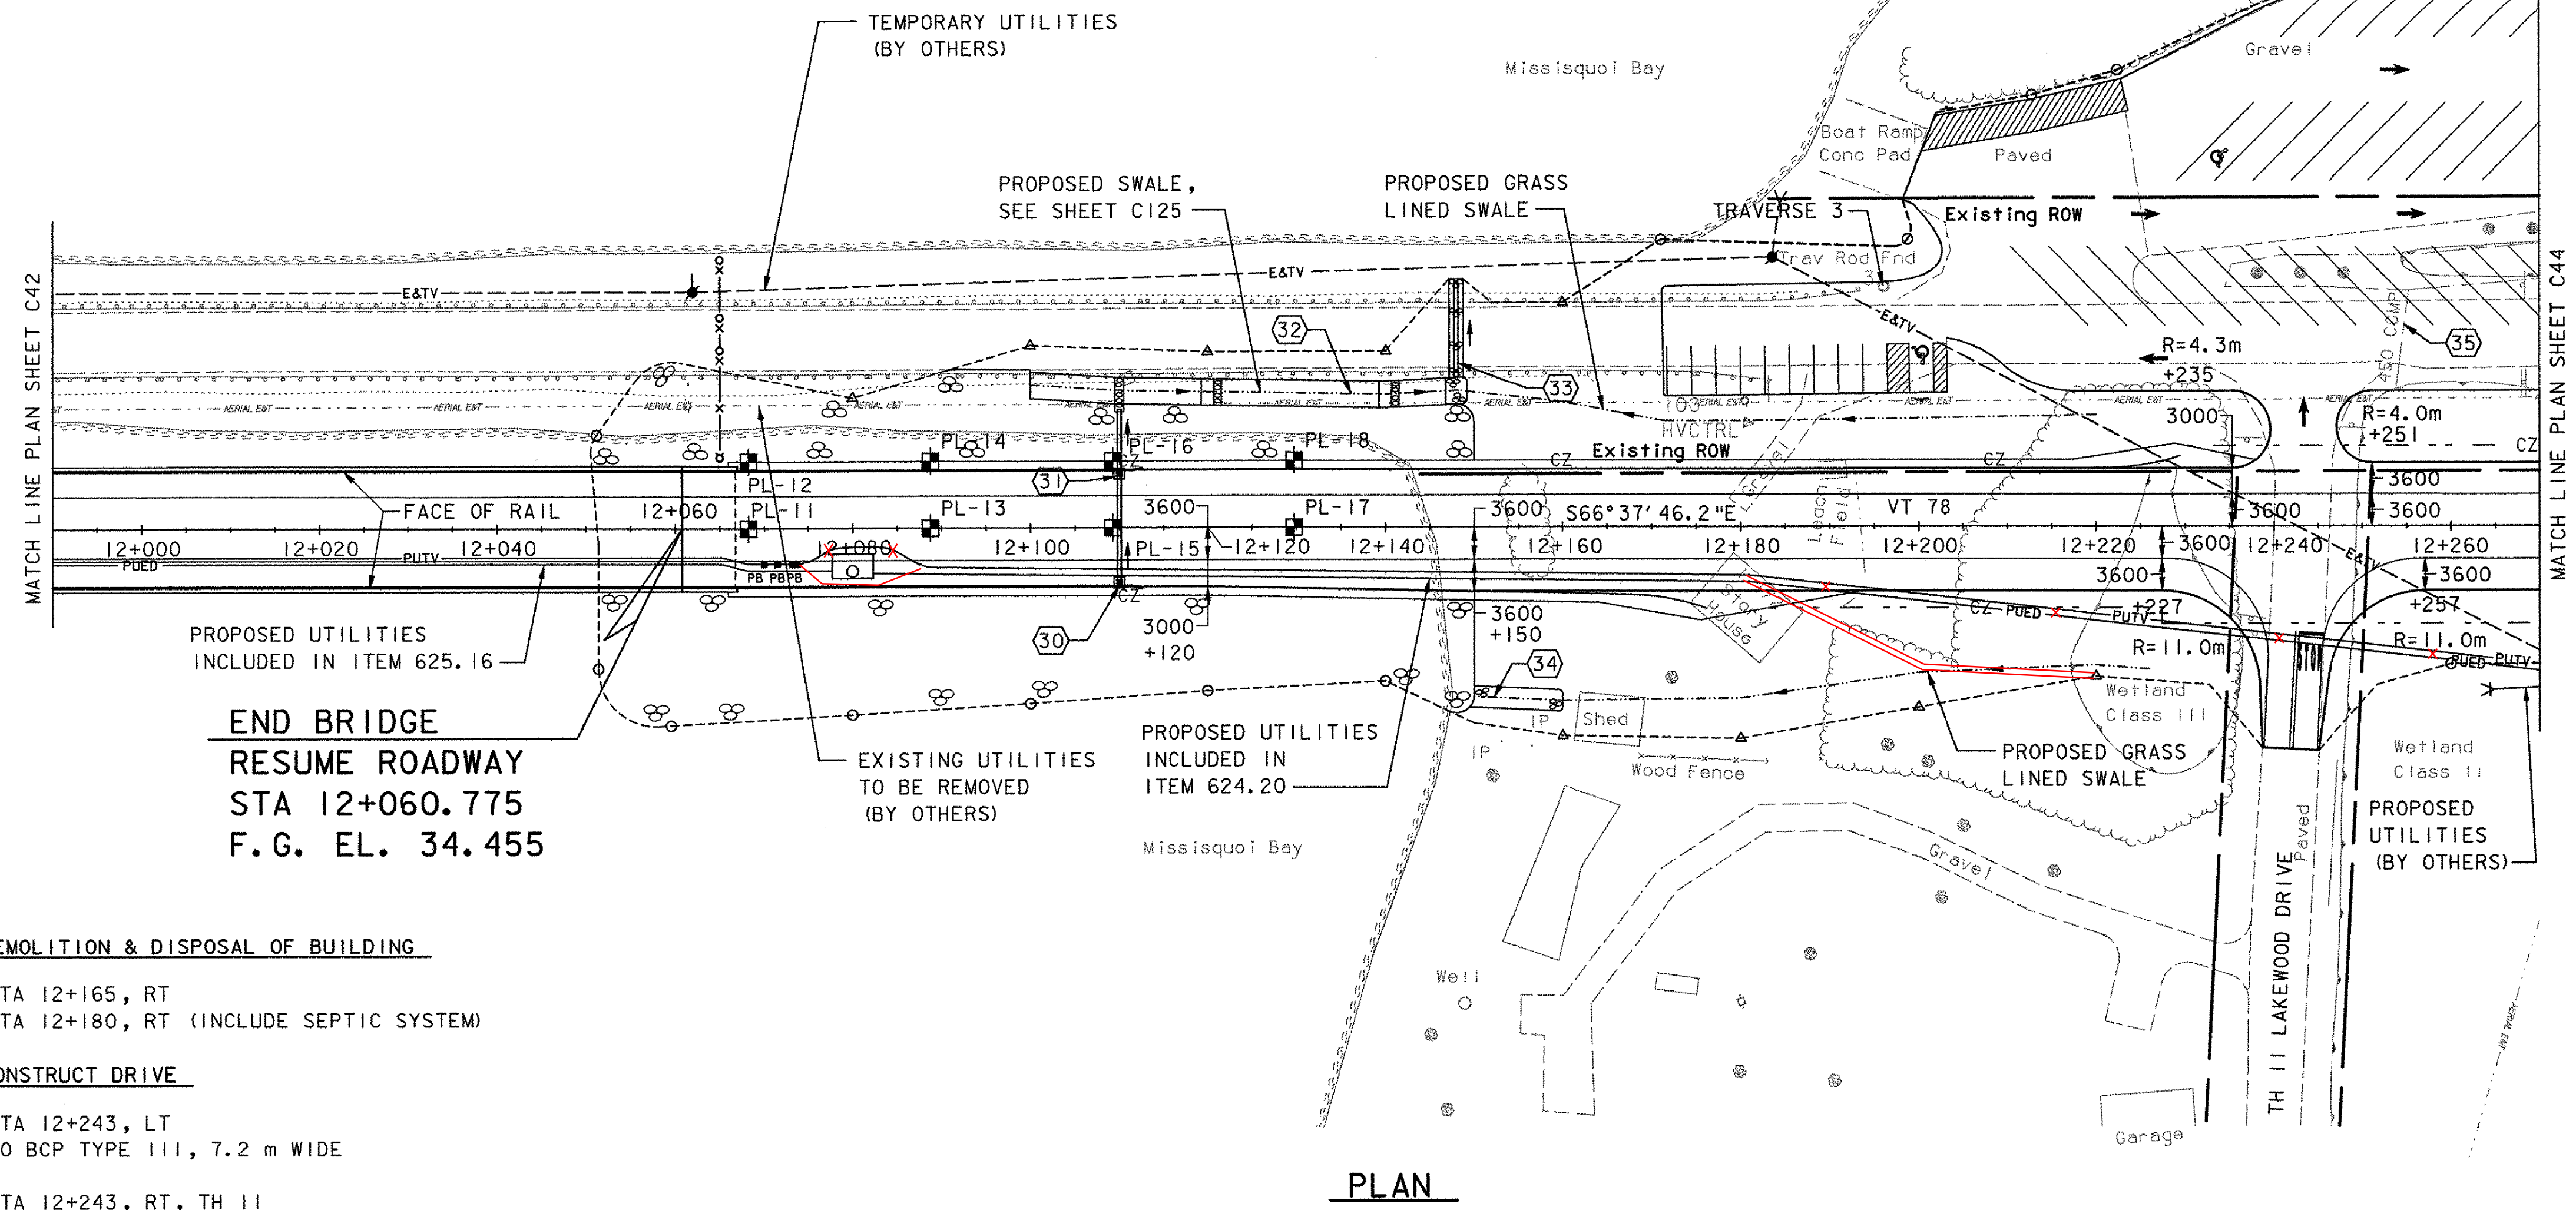

PLAN



DRAINAGE NOTES

- (30) STA 12+110, RT 6.3 m - LT 6.3 m
DI WITH GRATE, TYPE D
RIM EL. = 33.468
NEW 450x12 m PCCSP
INV. OUT = 31.626
- (31) STA 12+110, LT 6.3 m - LT 13.3 m
DI WITH GRATE, TYPE D
RIM EL. = 33.348
INV. IN (S) = 31.266
INV. OUT (N) = 31.166
NEW 450x7 m PCCSP
INV. OUT = 30.965 30.920
OUTLET WITH STONE FILL PAD, TYPE I
1000x3.9 m x 300 DEEP
- (32) STA 12+100, LT 16.0 m - STA 12+150, LT 15.4 m
NEW GRASS LINED SWALE WITH PERMANENT STONE CHECK DAMS
INV. IN = 30.700 CHECK DAMS ELIMINATED
INV. OUT = 30.500
OUTLET WITH STONE FILL SUMP, TYPE I
2400x3.0 m x 300 DEEP
- (33) STA 12+148, LT 16.8 m - LT 27.6 m
INSTALL NEW 600x12 m PCCSP OR CAAP OR RCP OR CPEP
INV. IN = 30.500 30.525
INV. OUT = 30.350 30.305
STA 12+148, LT 16.8 m - LT 27.6 m
NEW STONE FILL, TYPE II
1600x10.8 m x 600 DEEP
PLACE CRUSHED GRAVEL (COARSE GRADED)
ON TOP OF STONE FILL, TYPE II
- (34) STA 12+150, RT 16.9 m - STA 12+160, RT 19.9 m
NEW STONE FILL DITCH, TYPE II
INV. IN = 29.970
INV. OUT = 29.280
- (35) STA 12+254, LT 15.6 m - STA 12+255, LT 26.3 m
REMOVE EXISTING 450x11 m CGMP

SEE SHEET C39 FOR CAUSEWAY CONSTRUCTION NOTES.

DEMOLITION & DISPOSAL OF BUILDING

- STA 12+165, RT
- STA 12+180, RT (INCLUDE SEPTIC SYSTEM)

CONSTRUCT DRIVE

- STA 12+243, LT
50 BCP TYPE III, 7.2 m WIDE
- STA 12+243, RT, TH II
50 BCP TYPE III, 6.4 m WIDE

REMOVAL AND DISPOSAL OF GUARDRAIL

- STA 11+990, LT 17.1 m - STA 12+184, LT 16.4 m
- STA 11+990, LT 24.7 m - STA 12+194, LT 26.3 m

CAST-IN-PLACE CONCRETE CURB

- STA 12+067.0, LT - STA 12+076.5, LT
- STA 12+067.0, RT - STA 12+076.5, RT

BITUMINOUS CONCRETE CURB

- STA 12+076.5, LT - STA 12+113, LT
- STA 12+076.5, RT - STA 12+113, RT

STONE FILL, TYPE IV

- STA 12+050, LT - STA 12+150, LT
- STA 12+051, RT - STA 12+150, RT

MANUFACTURED TERMINAL SECTION - FLARED

- STA 12+215.3, LT - STA 12+226.8, LT
- STA 12+217.5, LT - STA 12+228.9, LT
- STA 12+164.1, RT - STA 12+175.6, RT
- STA 12+162.8, RT - STA 12+174.3, RT

STEEL BEAM GUARDRAIL

- STA 12+076.5, LT - STA 12+215.3, LT
- STA 12+076.5, RT - STA 12+164.1, RT
- STA 12+076.5, RT - STA 12+162.8, RT

REMOVAL & DISPOSAL OF GUIDE POSTS

- STA 12+238, LT
- STA 12+243, LT
- STA 12+247, LT
- STA 12+264, LT
- STA 12+269, LT

COLD PLANING (TH II)

- STA 12+243, RT 23.0 m - STA 12+243, RT 25.0 m (SALVAGE)
- (SEE SPECIAL PROVISIONS)

PAVED SHOULDER TAPER

- STA 12+120, RT (3000 mm) TO STA 12+150, RT (3600 mm)

GEOTEXTILE FOR ROADBED SUBGRADE SEPARATOR

- STA 12+060.8 - STA 12+150

UTILITY VAULT

- STA 12+080, RT 4.15 m (ELECTRICAL)
- (SEE SPECIAL PROVISIONS FOR DETAILS)

PULL BOX

- STA 12+070.0, RT 4.1 m (SINGLE VTRANS DUCT)
- STA 12+071.5, RT 4.1 m (SINGLE VTRANS DUCT)

DATUM
VERTICAL NAVD 88
HORIZONTAL NAD 83 (92)

VANASSE HANGEN BRUSTLIN, INC.

STATE OF VERMONT AGENCY OF TRANSPORTATION		
Town Of	ALBURG-SWANTON	Bridge No. 2
Highway No.	VT 78	Log Sta. Surv. Sta.
VT 78 OVER MISSISQUOI BAY		
VT 78 ROADWAY PLAN (8 OF 10)		
Designed By	S. W. BEKIER	Drawn By C. L. CILLEY
Checked By	Date 10/03	Bridge Design Supervisor C. D. BAKER Date 10/03
PROJECT	ALBURG-SWANTON	PROJECT NO. BRF 036-1 (1)
I.G.C. Info.		
File No.	ZE072PN8	Sheet C43 of C194