



END CONSTRUCTION
STA 1+135.000
MATCH EXISTING

END CONSTRUCTION
STA 0+160.000
MATCH EXISTING

SIDEROAD OFF TH2
ALBURG SPRINGS ROAD
CURVE DATA #1

$\Delta = 39^{\circ}14'21.2''$ LT
R = 90.000
T = 32.082
L = 61.637
E = 5.547
BANK = NC

PROPOSED UTILITIES
(BY OTHERS)

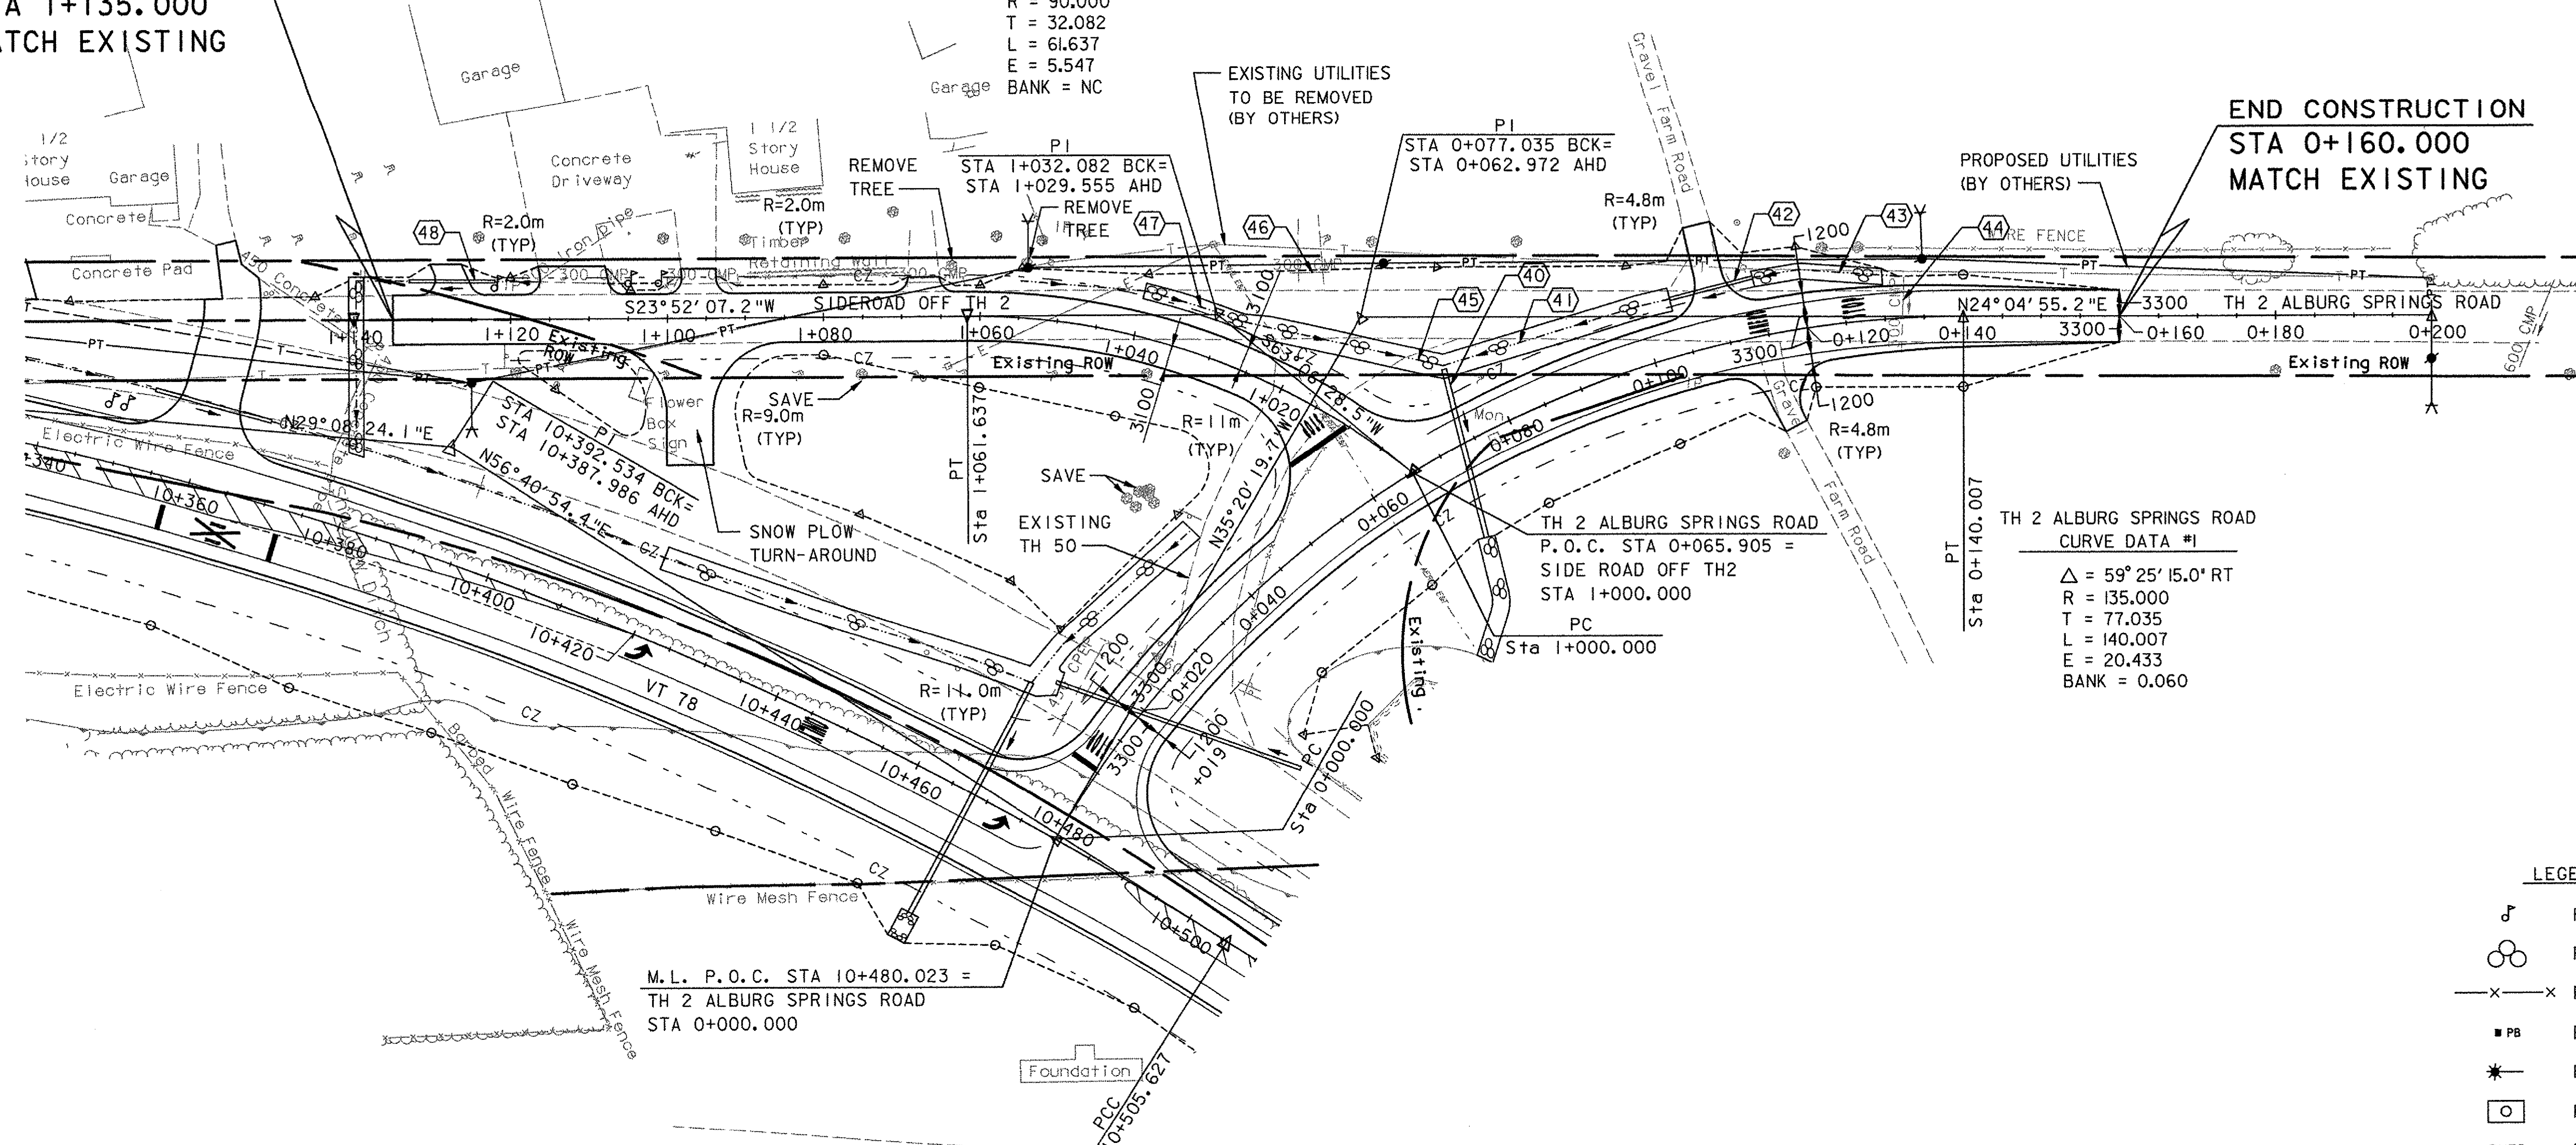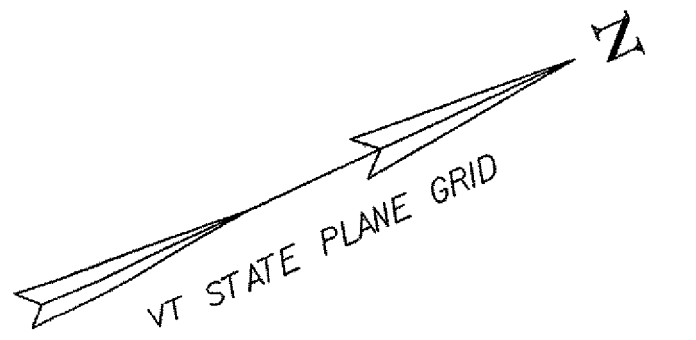

TH 2 ALBURG SPRINGS ROAD
CURVE DATA #1
 $\Delta = 59^{\circ}25'15.0''$ RT
R = 135.000
T = 77.035
L = 140.007
E = 20.433
BANK = 0.060

M.L. P.O.C. STA 10+480.023 =
TH 2 ALBURG SPRINGS ROAD
STA 0+000.000

LEGEND

- PROPOSED MAILBOX
- PROPOSED LANDSCAPING
- PROPOSED CHAIN-LINK FENCE
- PROPOSED PULL BOX
- PROPOSED OVERHEAD LIGHT
- PROPOSED UTILITY VAULT
- PROPOSED UNDERGROUND ELECTRICAL DUCT
- PROPOSED UNDERGROUND CABLE TV DUCT
- PROPOSED UNDERGROUND WIRED CONDUIT FOR NAVIGATIONAL LIGHTING
- PROPOSED AERIAL ELECTRIC, CABLE TV AND TELEPHONE
- PROPOSED AERIAL TELEPHONE
- TEMPORARY AERIAL ELECTRIC, CABLE TV AND TELEPHONE

PLAN



COLD PLANING

STA 0+155 - STA 0+160
STA 1+060 - STA 1+135

SHOULDER TAPER

STA 0+120, RT & LT (1200 mm) TO
STA 0+160, RT & LT (0 mm)

CONSTRUCT DRIVE

STA 0+109, LT
50 BCP TYPE III, 3.6 m WIDE

STA 0+115, RT
50 BCP TYPE III, 3.0 m WIDE

STA 1+095, LT
50 BCP TYPE III, 6.0 m WIDE

STA 1+125, RT
50 BCP TYPE III, 3.6 m WIDE

SINGLE MAILBOX SUPPORT

STA 1+101, RT
STA 1+105, RT
STA 1+122, RT

DRAINAGE NOTES

- (40) STA 0+076, LT 9.5 m - STA 0+070, RT 12.2 m
NEW 600x22 m PCCSP OR CAAP OR RCP OR CPEP
INV. IN = ~~39.420~~ 39.406
INV. OUT = ~~37.900~~ 37.851
NEW STONE FILL DITCH, TYPE I
2200x16.3 mx300 DEEP
1000 WIDE WITH 1:2 SIDE SLOPES
- (41) STA 0+076, LT 9.5 m - STA 0+104, LT 7.0 m
NEW STONE LINED DITCH, TYPE I
3000x28.0 mx300 DEEP
- (42) STA 0+104, LT 7.5 m - STA 0+114, LT 7.5 m
NEW 375x11 m PCCSP OR CAAP OR
RCP CLASS IV OR CPEP
INV. IN = 41.380
INV. OUT = 41.180
- (43) STA 0+114, LT 7.0 m - STA 0+130, LT 5.6 m
NEW STONE LINED DITCH, TYPE I
2000x16.0 mx300 DEEP
- (44) STA 0+132, LT 5.0 m - STA 0+132, RT 5.0 m
REMOVE EXISTING 300x10 m CMP
- (45) STA 0+076, LT 9.5 m - STA 1+025, RT 6.1 m
NEW STONE LINED DITCH, TYPE I
3000x24.0 mx300 DEEP
- (46) STA 1+021, RT 16.0 m - STA 1+024, RT 13.8 m
REMOVE EXISTING 300x6 m CMP
- (47) STA 1+025, RT 6.1 m - STA 1+040, RT 5.8 m
NEW STONE LINED DITCH, TYPE I
2000x11.0 mx300 DEEP
- (48) STA 1+122, RT 4.6 m - STA 1+133, RT 4.6 m
NEW 375x11 m PCCSP OR CAAP OR
RCP CLASS IV OR CPEP
INV. IN = 40.565
INV. OUT = 40.475

**STATE OF VERMONT
AGENCY OF TRANSPORTATION**

Town Of	ALBURG-SWANTON	Bridge No.	2
Highway No.	VT 78	Log Sta.	
		Surv. Sta.	
VT 78 OVER MISSISQUOI BAY			
TH 2 ALBURG SPRINGS ROAD PLAN			
Designed By	S.W. BEKIER	Drawn By	C.L. CILLEY
Checked By	Date	Bridge Design Supervisor	
J.A. MERCER	10/03	C.D. BAKER Date 10/03	
PROJECT	ALBURG-SWANTON	PROJECT NO.	BRF 036-1 (1)
I.G.C. Info.			
File No.	ZE072PN11	Sheet	C46 of C194

DATUM
VERTICAL NAVD 88
HORIZONTAL NAD 83 (92)

VANASSE HANGEN BRUSTLIN, INC.