


PLAN
SCALE IN METERS
0 10 20 30

- CONSTRUCTION NOTES**
- DURABLE 100 mm WHITE LINE**
12+550 - 12+840 LT & RT
12+720
 - DURABLE 100 mm YELLOW LINE (DOUBLE CENTER LINE)**
12+550 - 12+840
12+720
 - REMOVING SIGNS**
AS SHOWN - 1
 - DELINEATORS - TYPE II - SILVER**
12+580 LT & RT
12+660 LT & RT
12+700-12+740 LT & RT
12+720-12+820 LT & RT

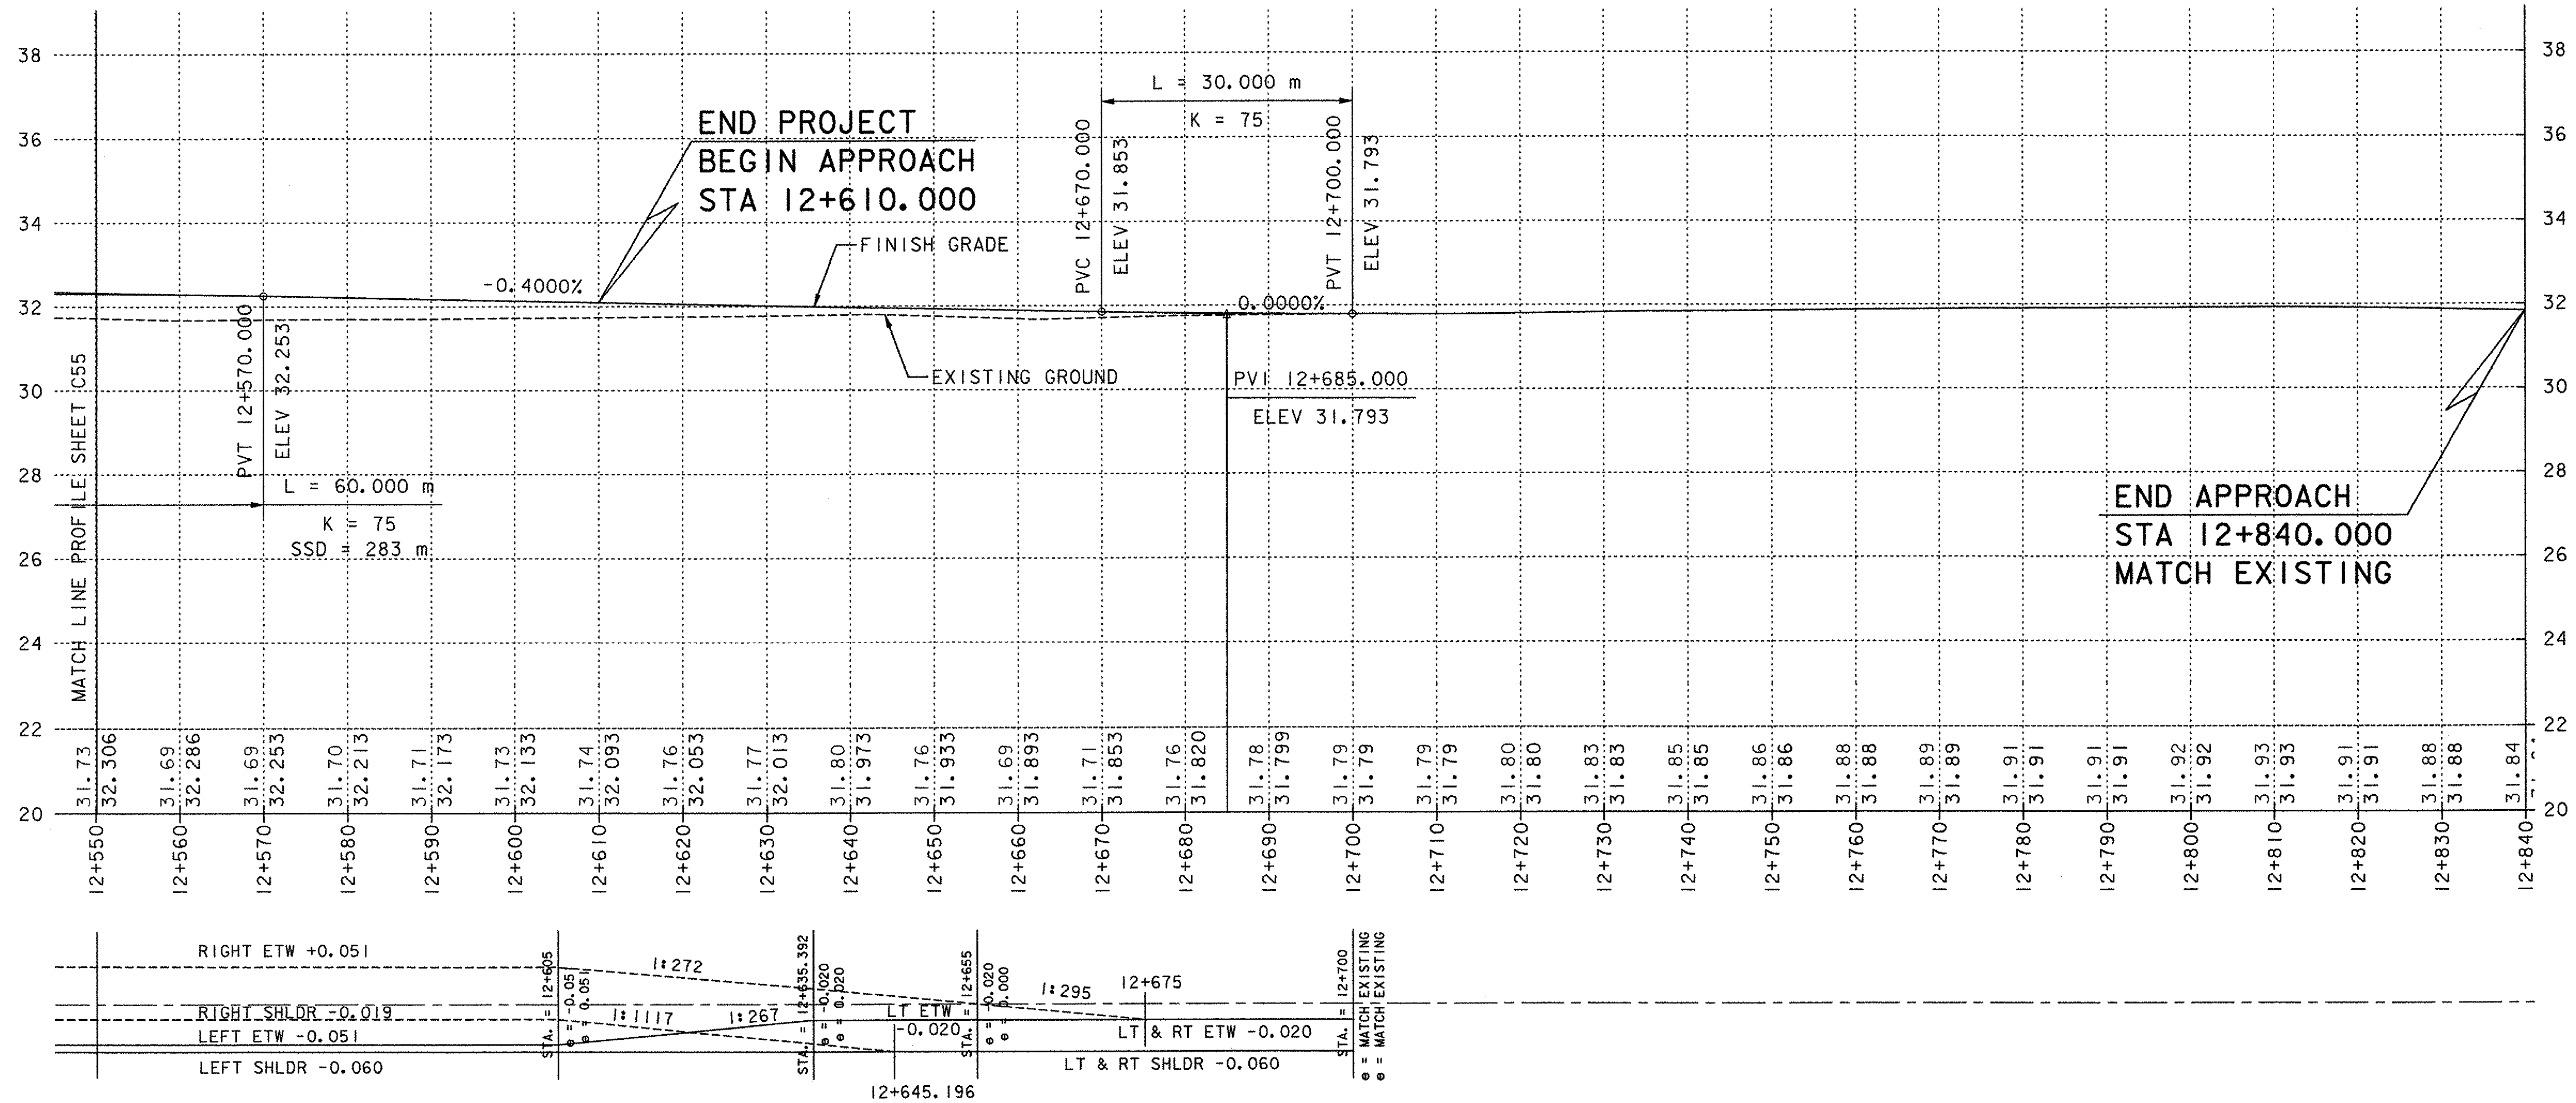

PROFILE AND BANKING DIAGRAM

- SIGN LEGEND**
- N = NEW
 - R = REMOVE
 - R&S = REMOVE & SALVAGE
 - S = SALVAGED SIGN
 - RET = RETAIN
 - B-B = BACK TO BACK
- ALL SIGNS SHALL BE RETAINED AND DISTRIBUTED AS DIRECTED BY THE RESIDENT ENGINEER.
- SCALE IN METERS
0 10 20 30
- HORIZONTAL SCALE = 1 : 500
VERTICAL SCALE = 1 : 100

NOTE:
SEE LAYOUT SHEETS FOR MEDIAN TAPERS

**STATE OF VERMONT
AGENCY OF TRANSPORTATION**

Town Of	ALBURG-SWANTON	Bridge No.	2
Highway No.	VT 78	Log Sta.	
		Surv. Sta.	
VT 78 OVER MISSISQUOI BAY			
VT 78 PROFILE & SIGNING & MARKING PLAN (10 OF 10)			
Designed By	N. M. CHOUINARD	Drawn By	M. M. LANDREY/CLC
Checked By	G. L. BAKOS	Date	10/03
		Bridge Design Supervisor	C. D. BAKER
PROJECT	ALBURG-SWANTON	PROJECT NO.	BRF 036-1 (1)
I.G.C. Info.	File No. ZE072ST10	Sheet	C56 of C194

DATUM
VERTICAL NAVD 88
HORIZONTAL NAD 83 (92)

VANASSE HANGEN BRUSTLIN, INC.