


PLAN



SECTION A-A

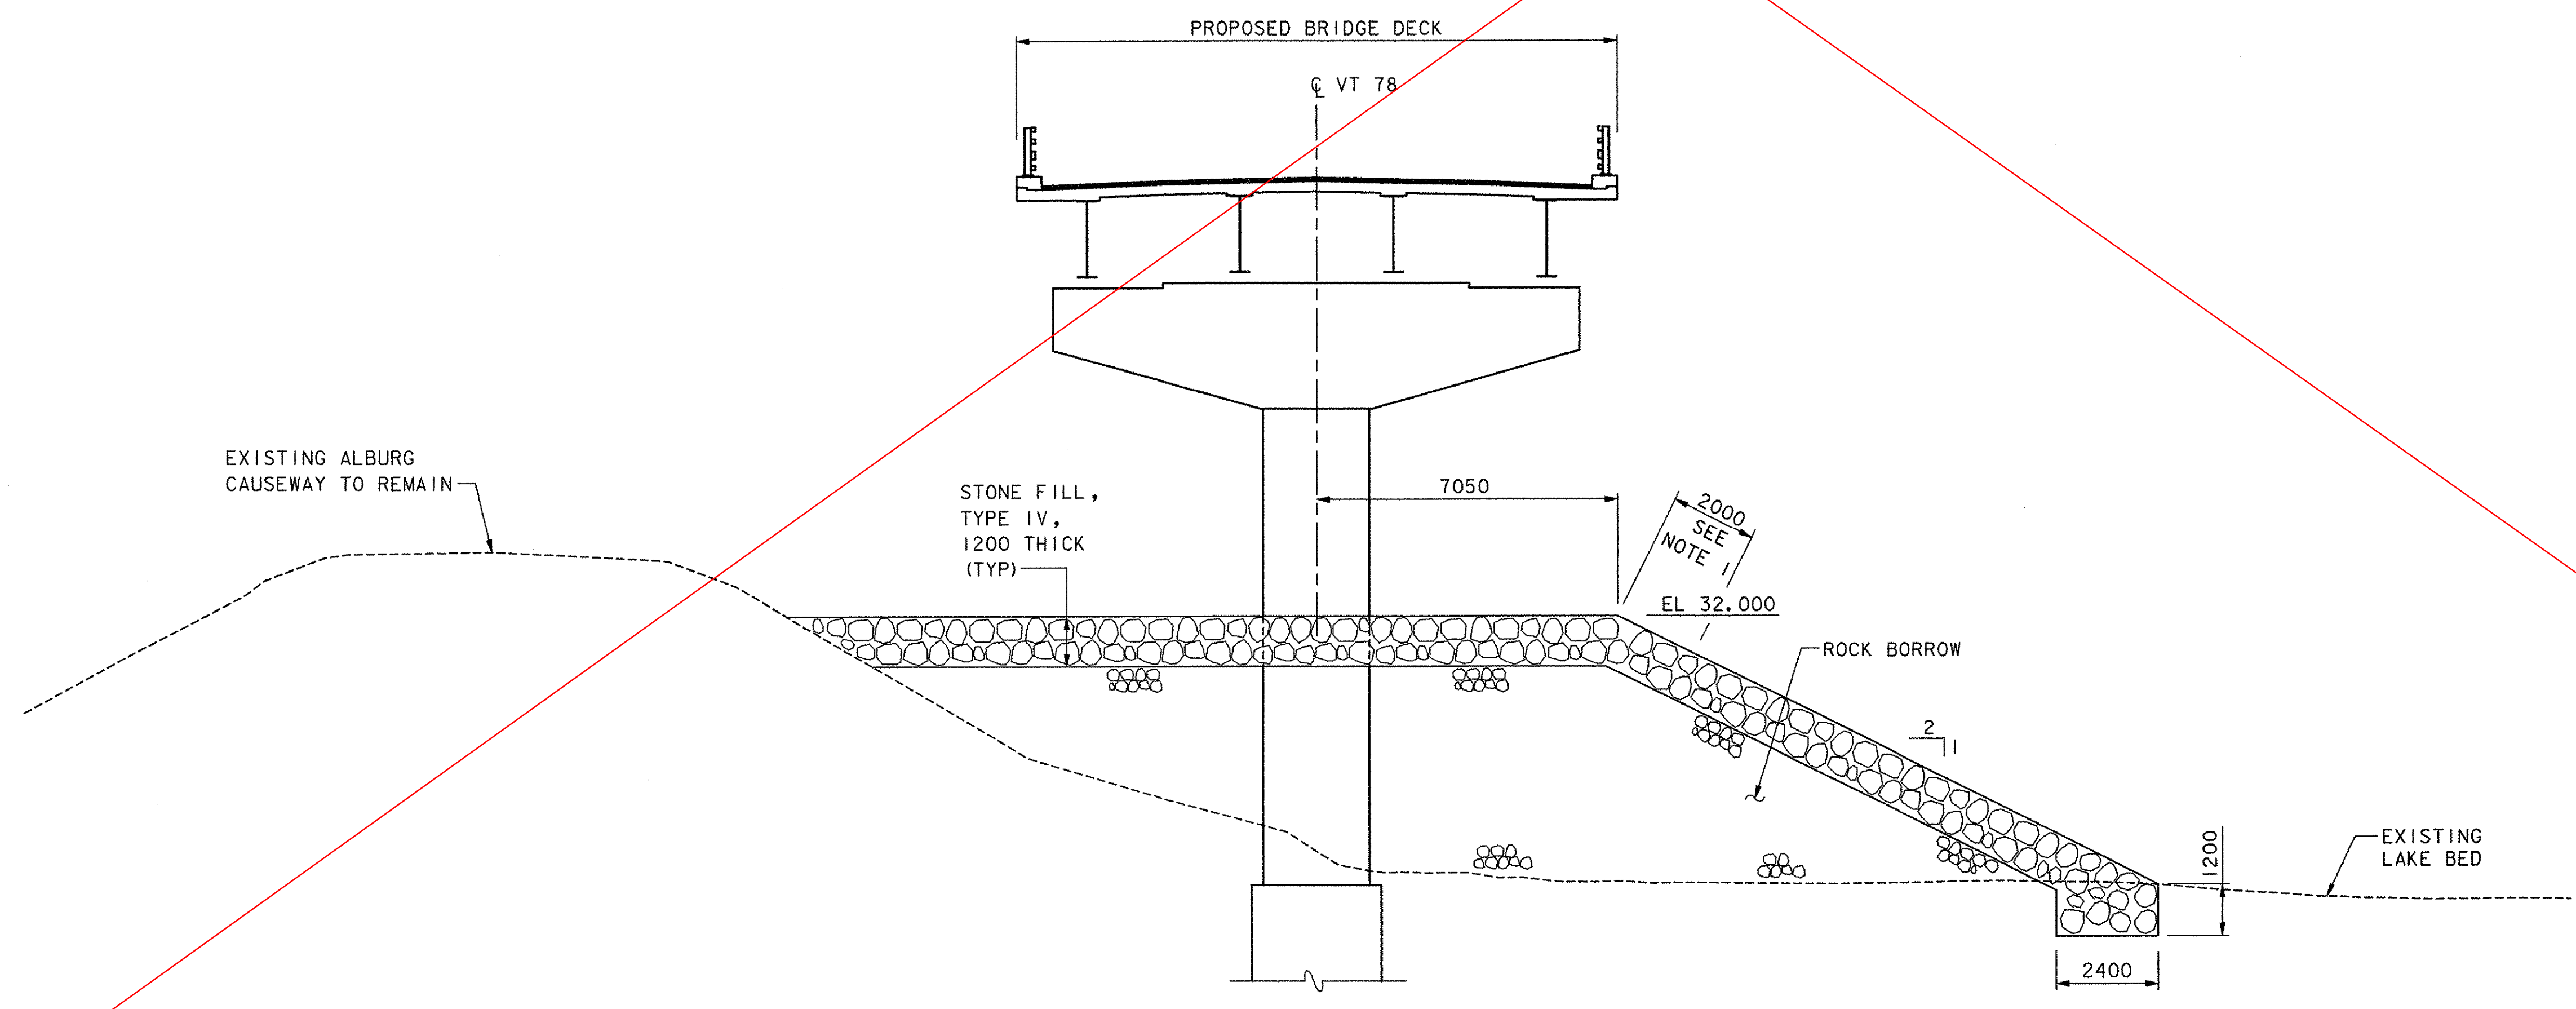

NOTES:

1. THIS AREA SHALL CONSIST OF GENERALLY FLAT STONES.
2. THE PERMANENT TURTLE BASKING AREA SHALL BE CONSTRUCTED AFTER THE PROPOSED PIER CONSTRUCTION IS COMPLETE.
3. THIS IS THE PERMANENT TURTLE BASKING AREA REQUIRED BY THE THREATENED AND ENDANGERED SPECIES PERMIT.

SEE REVISED SHEET: C62 of C194

**STATE OF VERMONT
AGENCY OF TRANSPORTATION**

Town Of	ALBURG-SWANTON	Bridge No.	2
Highway No.	VT 78	Log Sta.	
		Surv. Sta.	
VT 78 OVER MISSISQUOI BAY			
PERMANENT TURTLE BASKING AREA			
Designed By	C.L. CILLEY	Drawn By	C.L. CILLEY
Checked By	W. J. BARRY	Date	10/03
		Bridge Design Supervisor	C. D. BAKER
		Date	10/03
PROJECT	ALBURG-SWANTON	PROJECT NO.	BRF 036-1 (1)
I.G.C. Info.		File No. ZE072PTB	
		Sheet C62 of C194	

DATUM
VERTICAL NAVD 88
HORIZONTAL NAD 83 (92)

VANASSE HANGEN BRUSTLIN, INC.