



**PLAN**  
(RAIL POSTS NOT SHOWN)  
SCALE: 1:250

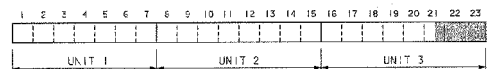


**KEY PLAN**

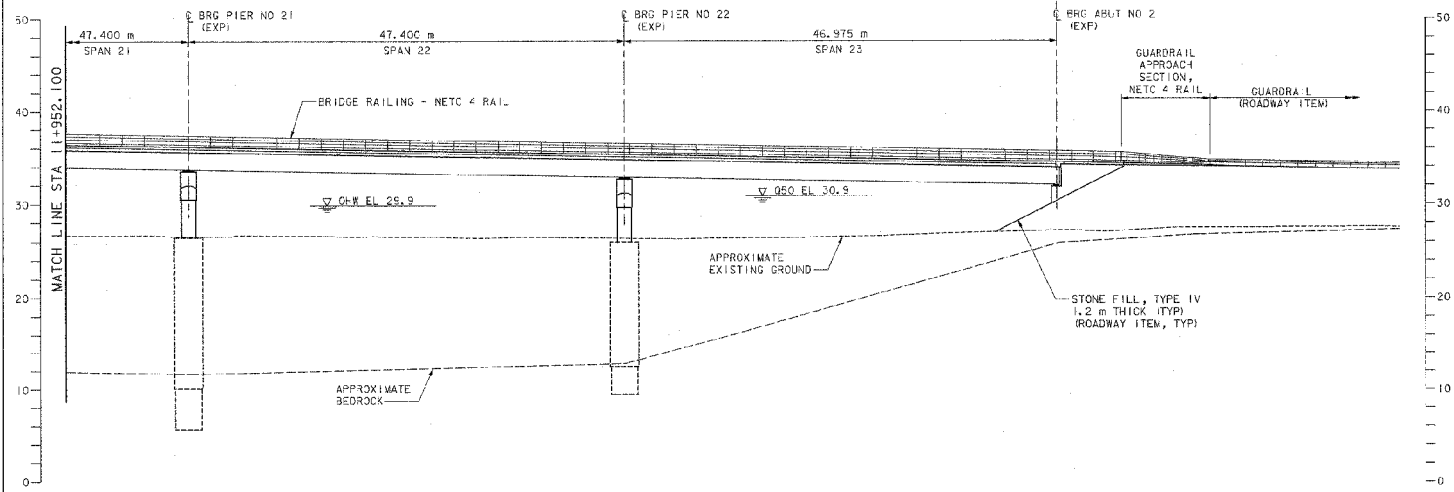

**ELEVATION**  
(SCALPERS NOT SHOWN)  
SCALE: 1:250

- NOTES:**
1. SEE CIVIL SHEETS FOR ADDITIONAL CAUSEWAY INFORMATION.
  2. SEE SHEET SS 47 FOR BRIDGE RAIL LAYOUT.
  3. APPROXIMATE BEDROCK SHOWN IS BASED ON EXTRAPOLATION BETWEEN BORINGS. SEE BORING LOGS FOR ELEVATIONS.

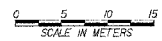

DATUM  
VERTICAL NAVD 88  
HORIZONTAL NAD 83 1921

STATE OF VERMONT AGENCY OF TRANSPORTATION			
Town Of	ALBURG-SWANTON	Bridge No. 2	
Highway No.	VT 78	Log Sta. Surv. Sta.	
VT 78 OVER MISSISSQUOI BAY			
PLAN & ELEVATION (8 OF 8)			
Designed By	A. S. ROBINSON	Drawn By	W. B. LAVERGNE (ITS)
Checked By	S. M. HODGDON	Date	10/03
		Bridge Design Supervisor	S. W. JOHNSON
PROJECT	ALBURG SWANTON	Date	10/C3
		PROJECT NO.	BRF 036-1 (1)
I.C.C. Info.			File No. ZE0720P8
			Sheet SS 10 of SS 37
VANASSE HANGEN BRUSTLIN, INC.			Sheet 10 of 37