




END CONSTRUCTION
STA 4+080
MATCH EXISTING

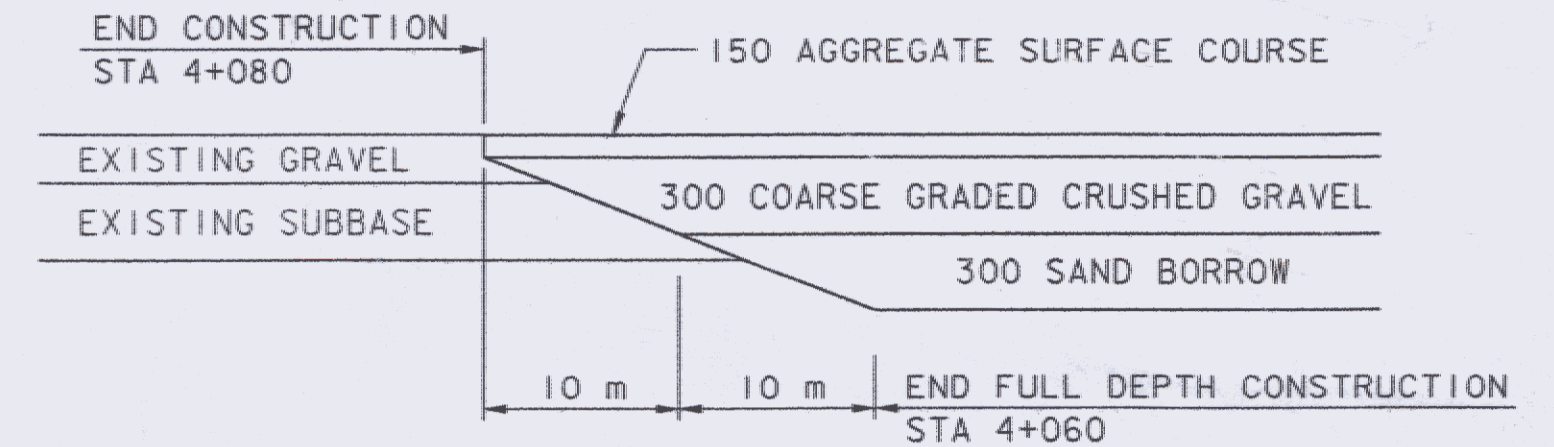


SANDY POINT RD MATERIAL TRANSITION DETAIL
NOT TO SCALE

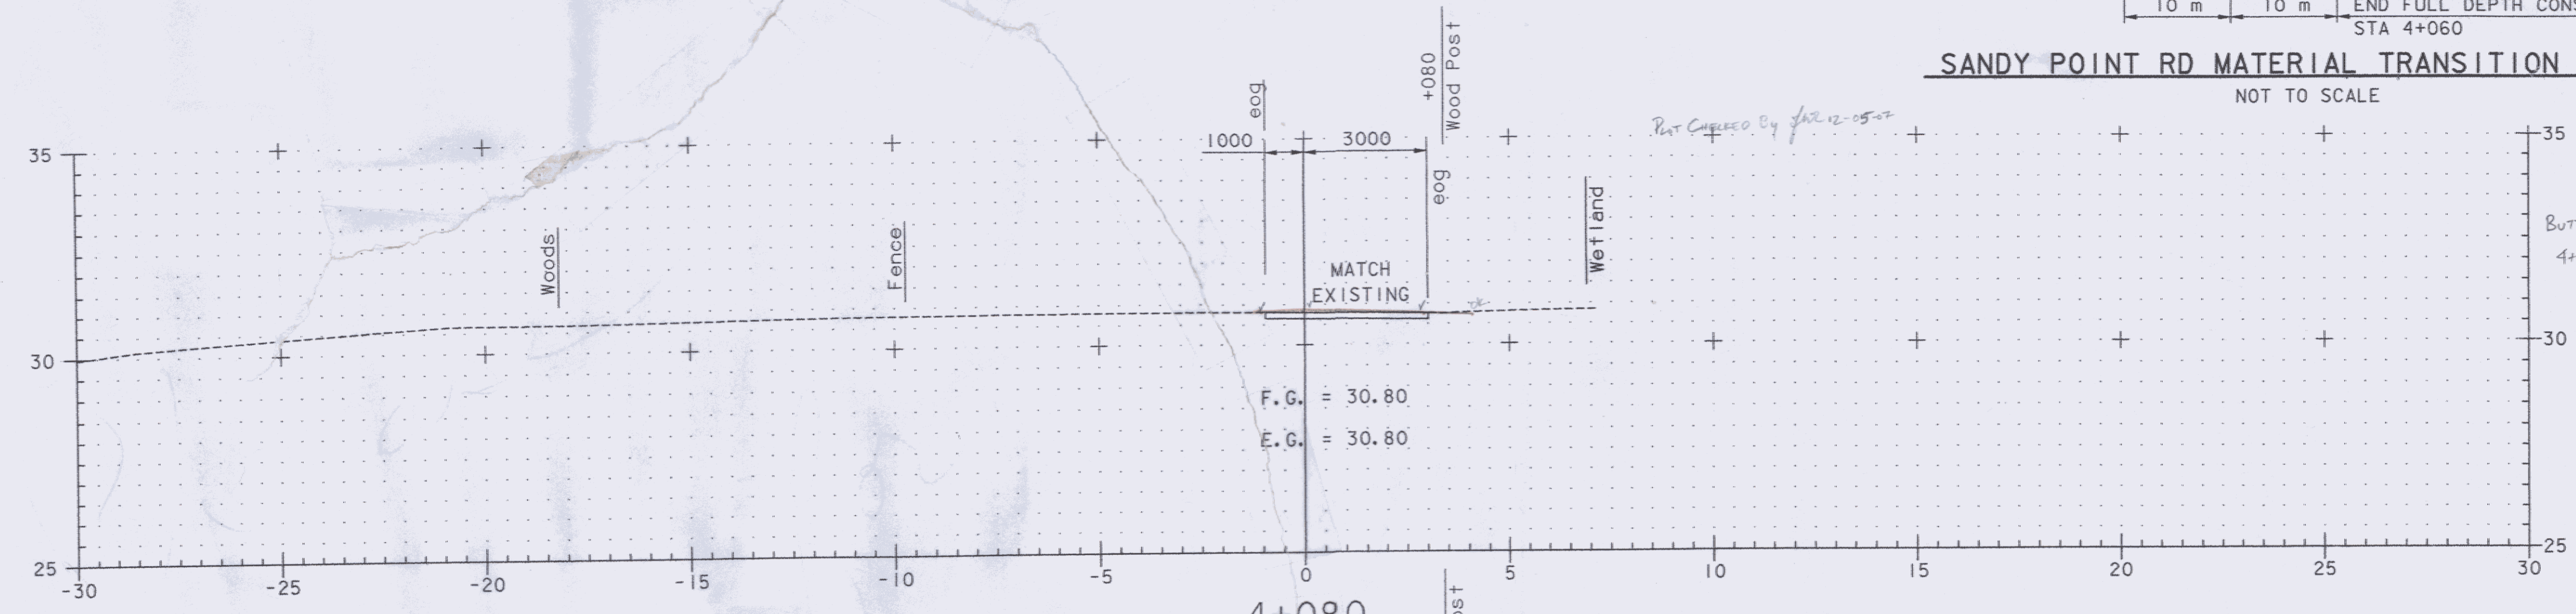


Common Exc. Area
 $0.6m^2$ (0.15m x 4.0m)
STW 12/12/07
JHY 12/13/07

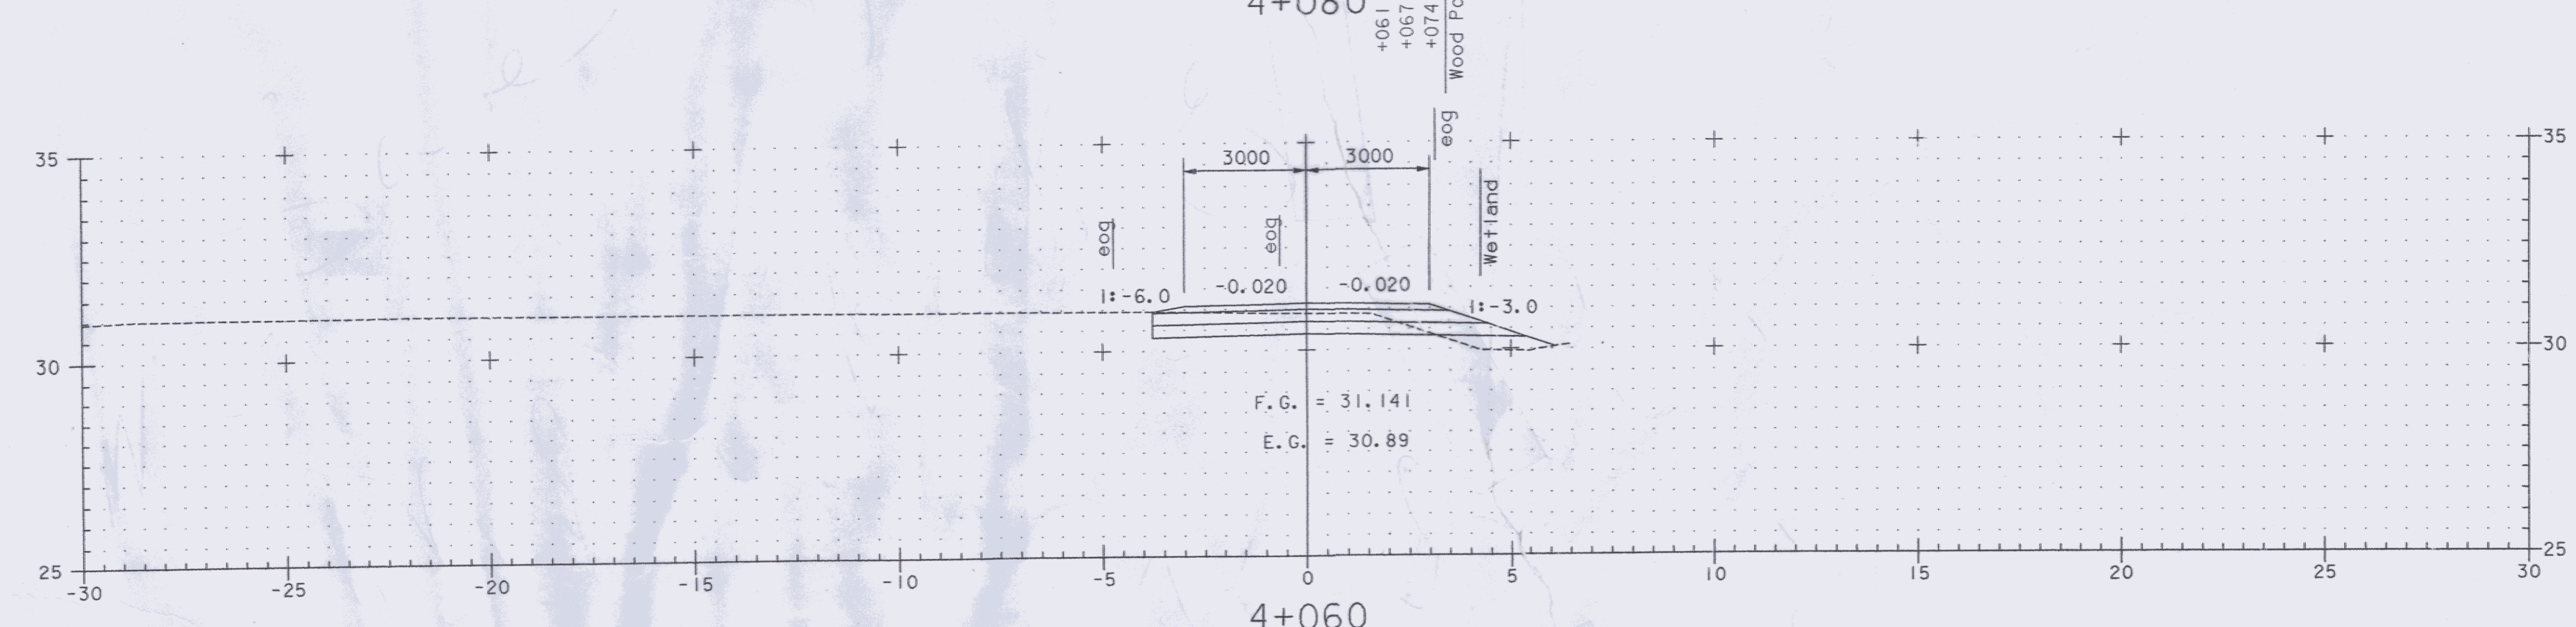

Common Exc. Area
3.4
3.3
3.3
AVG = $3.3m^2$ for 12-05-07
12/12/07

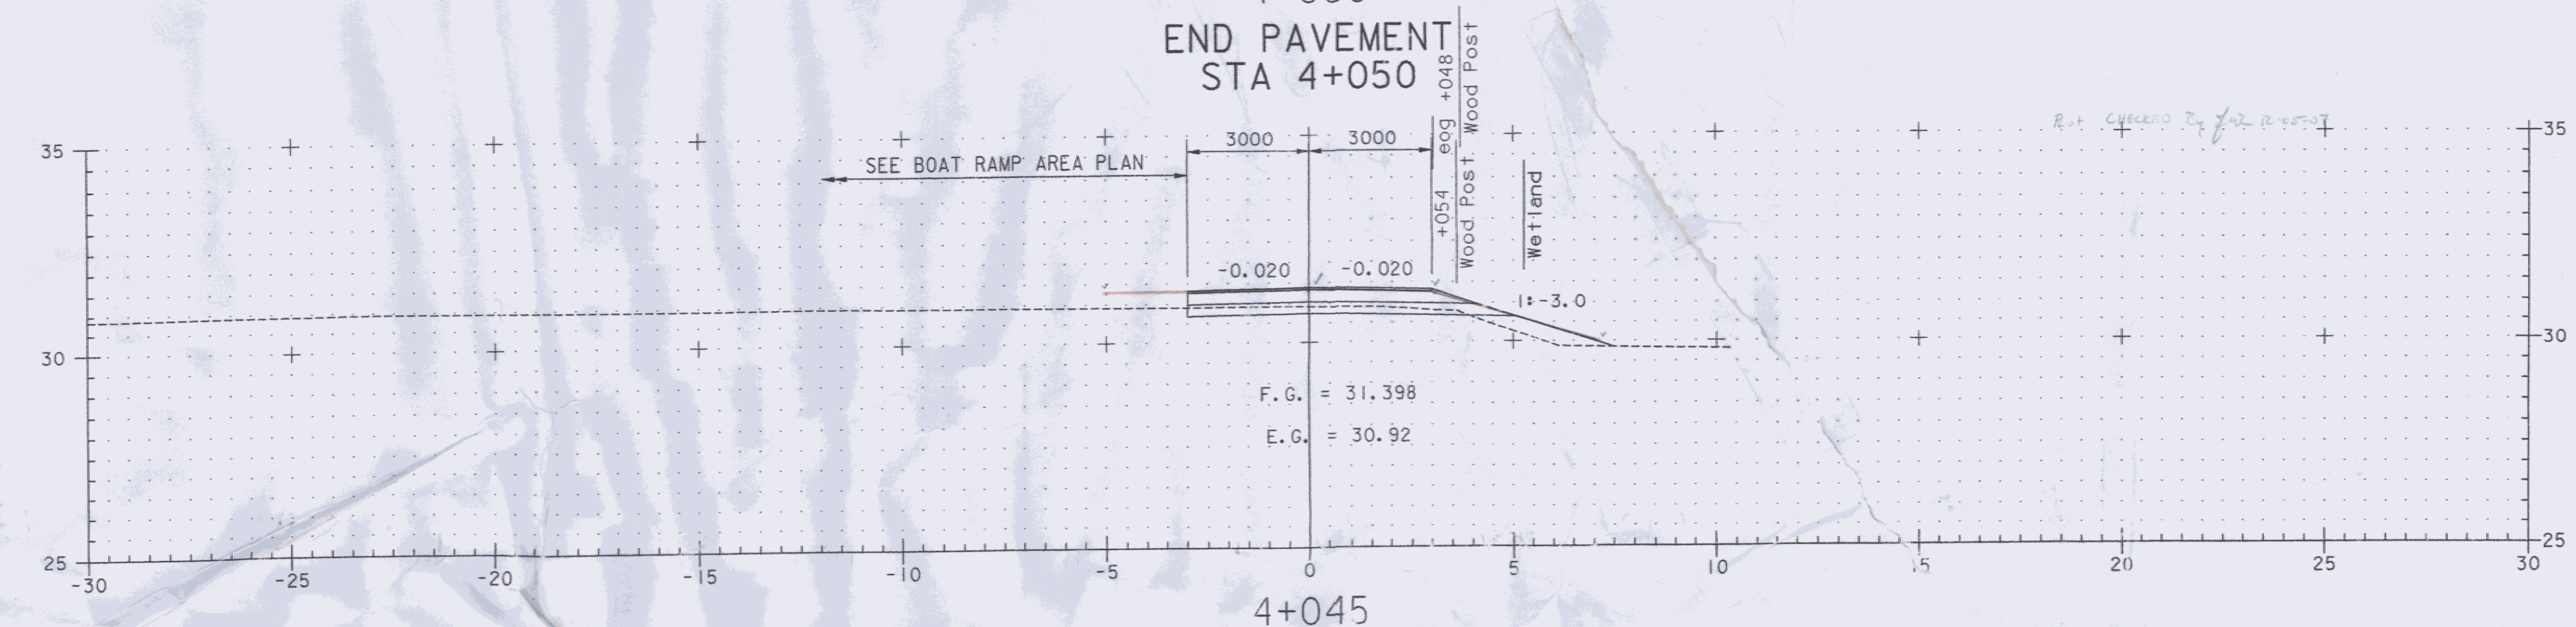

Common Exc. Area
1.2
1.3
1.2
AVG = $1.2m^2$ for 12-05-07
STW 12/12/07

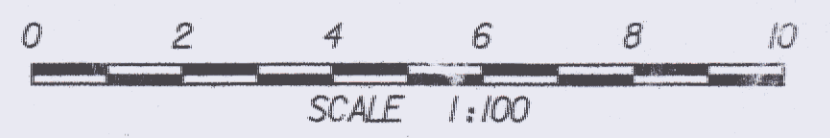

SANDY POINT ROAD

FROM STA 4+045 TO STA 4+080
PROJECT NAME ALBURG-SWANTON
PROJECT NO. BR# 036 - 100
SURVEYED BY VAOT 9/95 and EIV TECH. SERVICES, LLC 11/08
SHEET C194 OF C194