


PROFESSIONAL ENGINEERING  
REGISTERED ENGINEER  
MULLICHAMER ENGINEERING

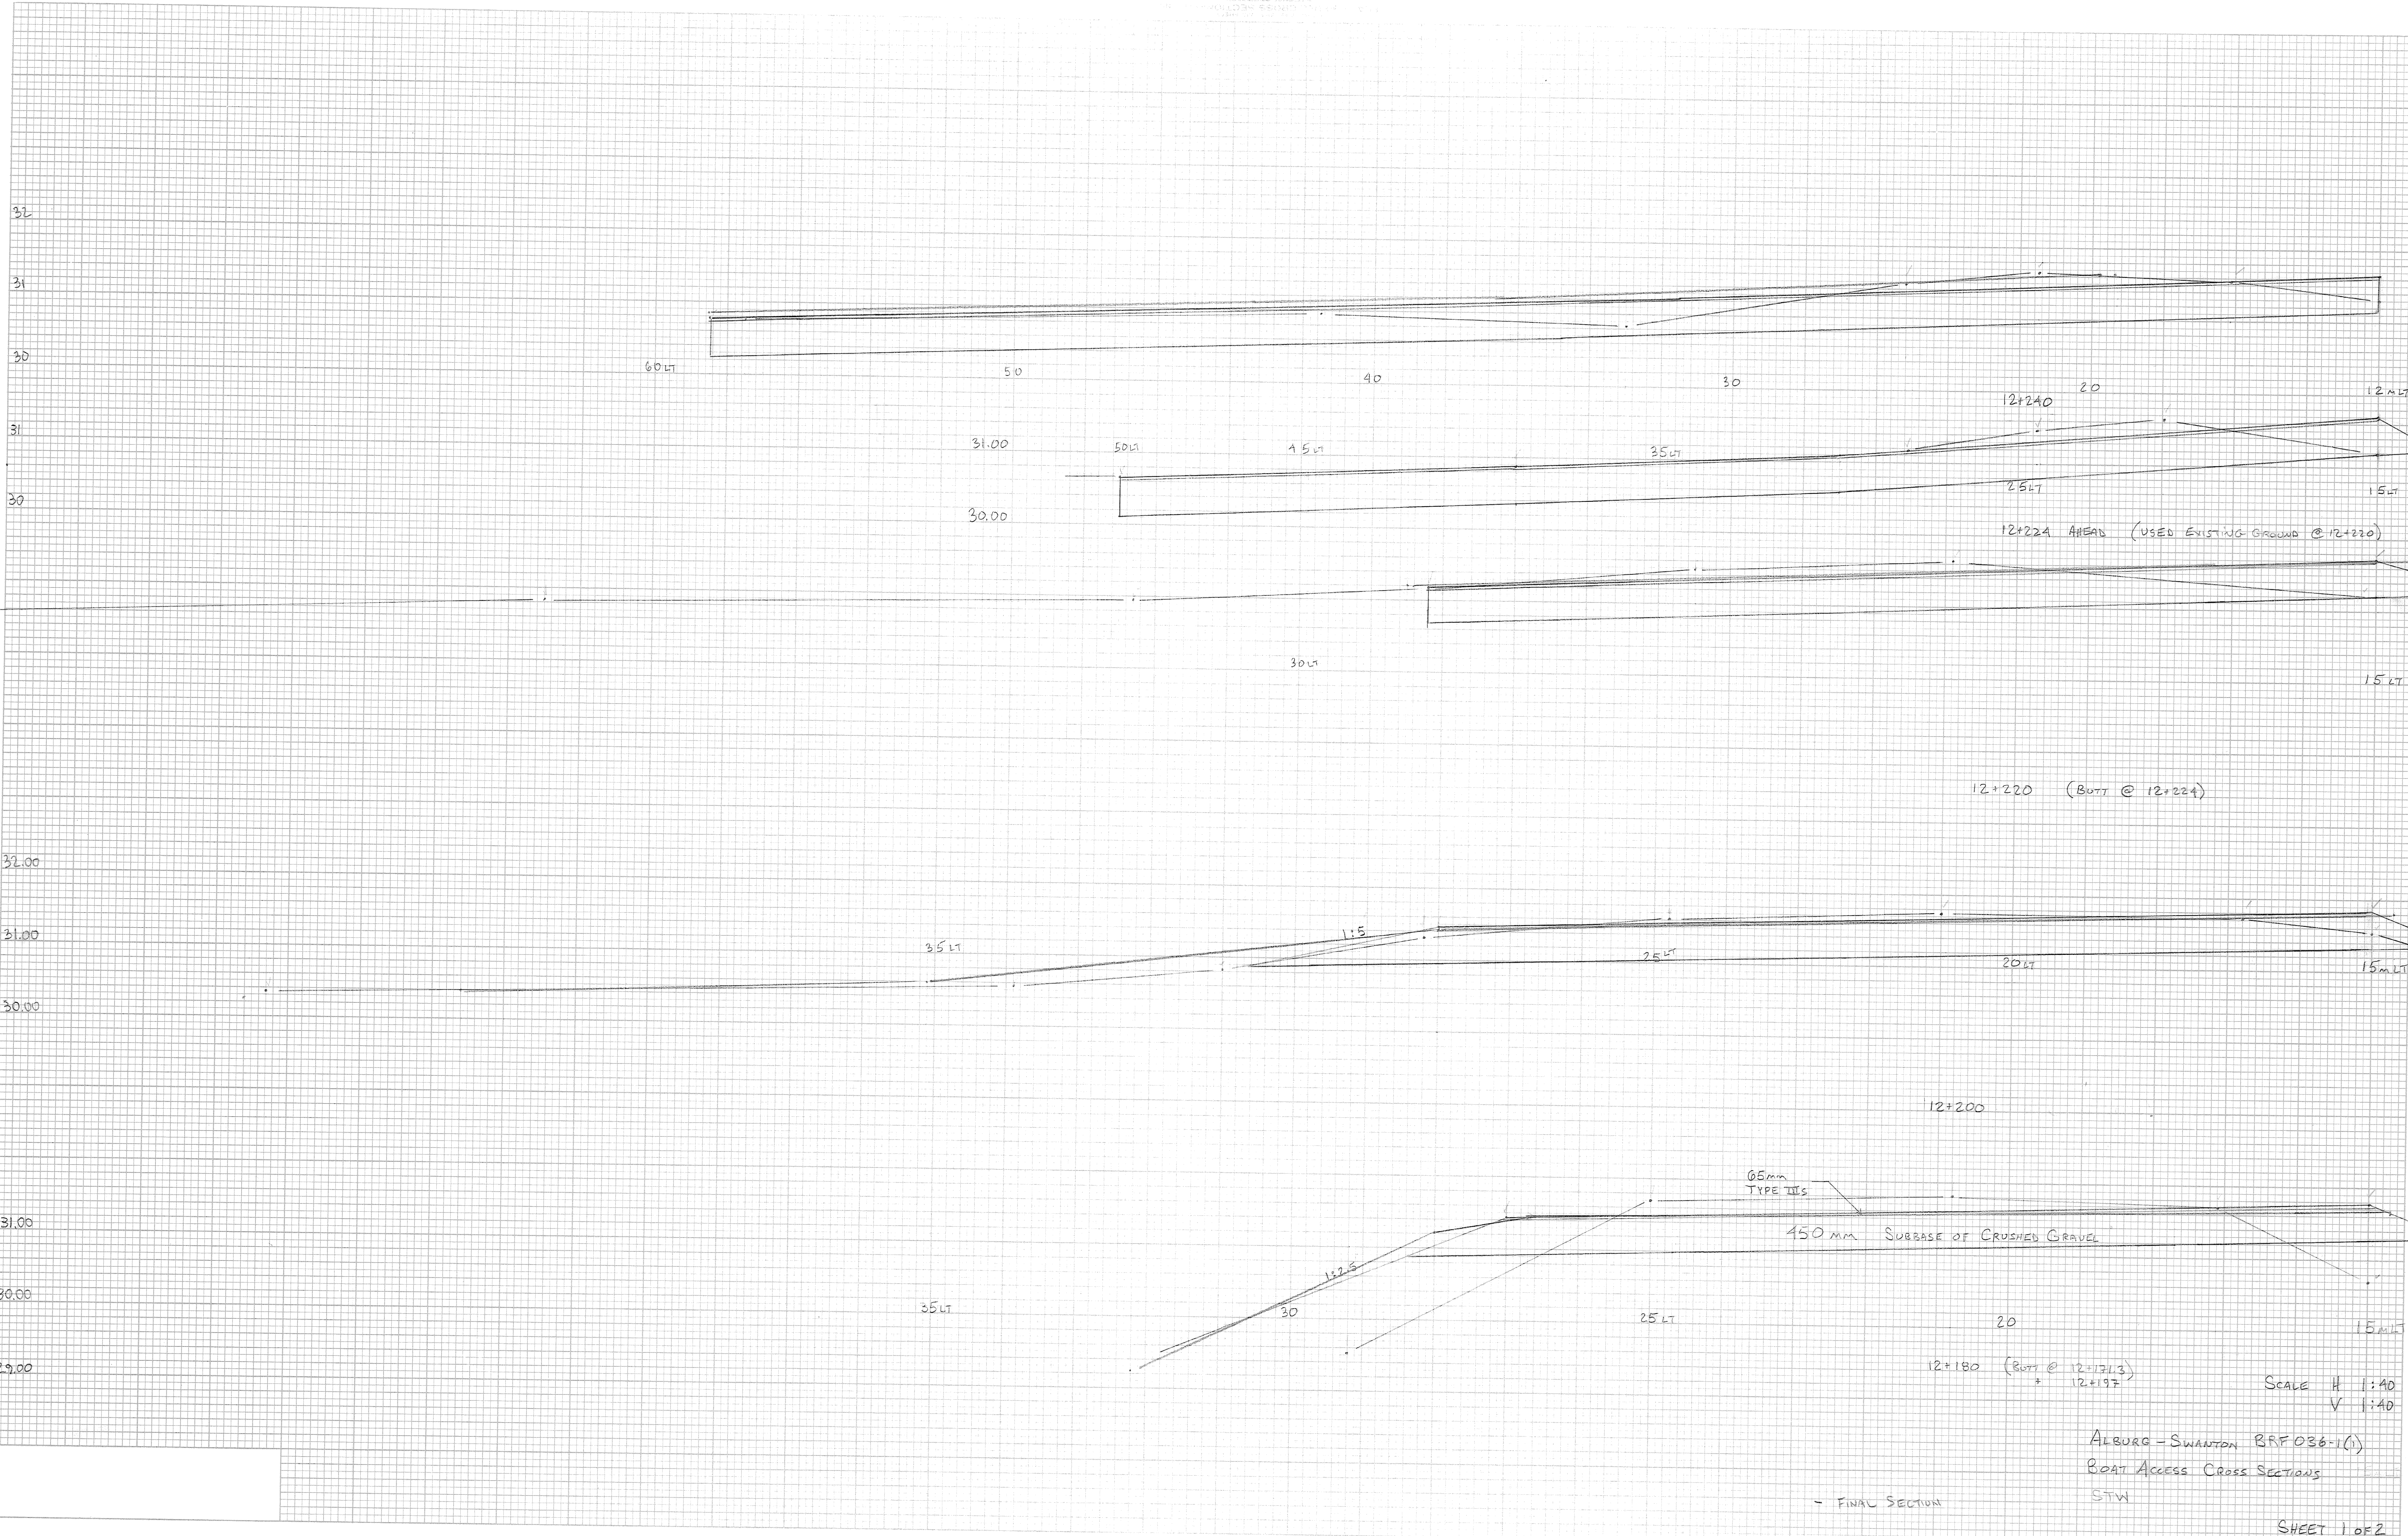

ORIGINAL SURVEY	NO.	BY	DATE
FINAL SURVEY	NO.	BY	DATE
NOTE BOOK			
TEMPLATE			
AREAS CHECKED			

ORIGINAL SURVEY	NO.	BY	DATE
FINAL SURVEY	NO.	BY	DATE
NOTE BOOK			
TEMPLATE			
AREAS CHECKED			

SCALE H 1:80  
V 1:40

ALBURG - SWANTON BRFO36-1(1)  
BOAT ACCESS CROSS SECTIONS  
STW

- FINAL SECTION

SHEET 1 OF 2

1/6-14-07